
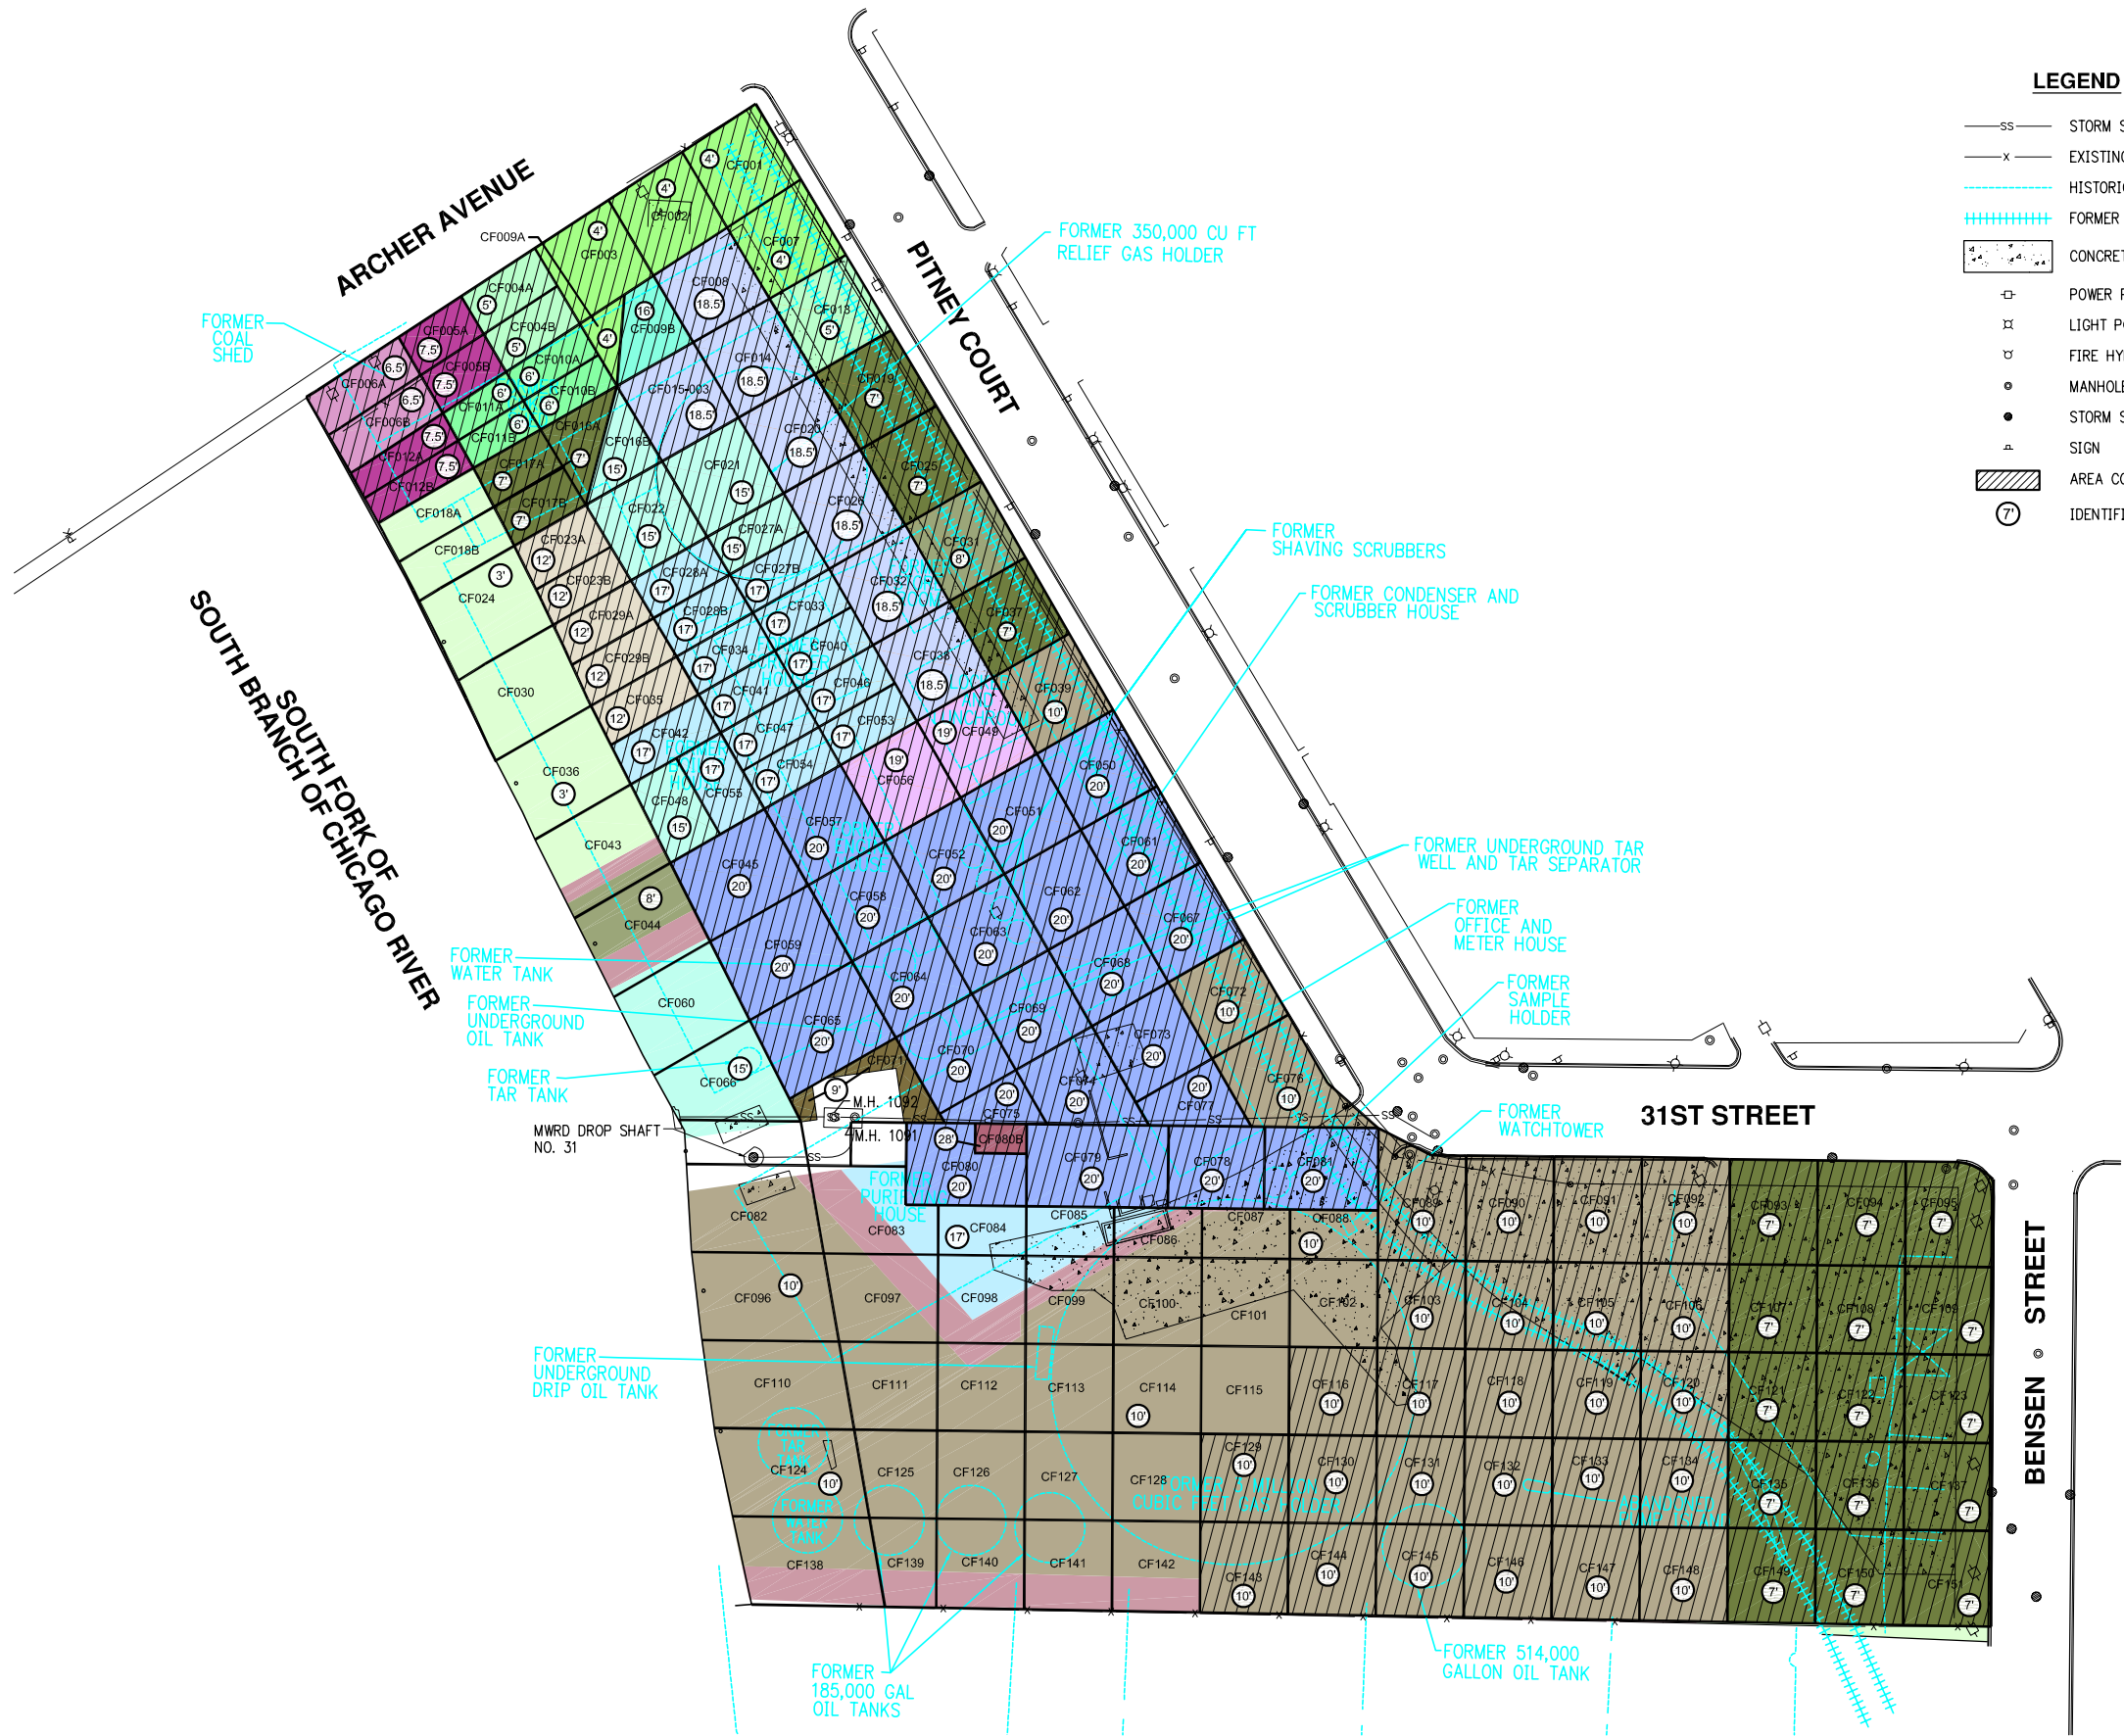


**DRAFT**

**JULY 13, 2007**

	
date 07-16-07	detailed G. ALVAREZ
designed A. HANRAHAN	checked
<b>THE PEOPLES GAS LIGHT AND COKE COMPANY CHICAGO, ILLINOIS</b>	
<b>PITNEY COURT 3052 SOUTH PITNEY COURT CHICAGO, ILLINOIS</b>	
Figure 1 AS-BUILT EXCAVATION LAYOUT MAP PITNEY COURT CHICAGO, ILLINOIS	
project 27112	contract
drawing	rev.
sheet 1 of 1 sheets	
file \\PEOPLES GAS\PITNEY COURT\JAG\BENKOR\IN PROGRESS\2007-07-13\PITNEY COURT EXCAVATION	



LEGEND

- SS STORM SEWER
- X EXISTING FENCE
- HISTORICAL FEATURES/FORMER STRUCTURES
- FORMER RAILROAD TRACKS
- CONCRETE
- POWER POLE
- LIGHT POLE
- FIRE HYDRANT
- MANHOLE
- STORM SEWER/CATCH BASIN
- SIGN
- AREA COMPLETED
- IDENTIFIED DEPTH OF EXCAVATION



40 0 40 80  
SCALE IN FEET

DRAFT

JULY 20, 2007



date	07-23-07	detailed	G. ALVAREZ
designed	A. HANRAHAN	checked	

THE PEOPLES GAS LIGHT  
AND COKE COMPANY  
CHICAGO, ILLINOIS

PITNEY COURT  
3052 SOUTH PITNEY COURT  
CHICAGO, ILLINOIS


Figure 1  
AS-BUILT EXCAVATION LAYOUT MAP  
PITNEY COURT  
CHICAGO, ILLINOIS

project	27112	contract	
drawing		rev.	


sheet 1 of 1 sheets

file:PEOPLES GAS/PITNEY COURT...CAG/BENKOR IN PROGRESS/2007-07-20/PITNEY COURT EXCAVATION



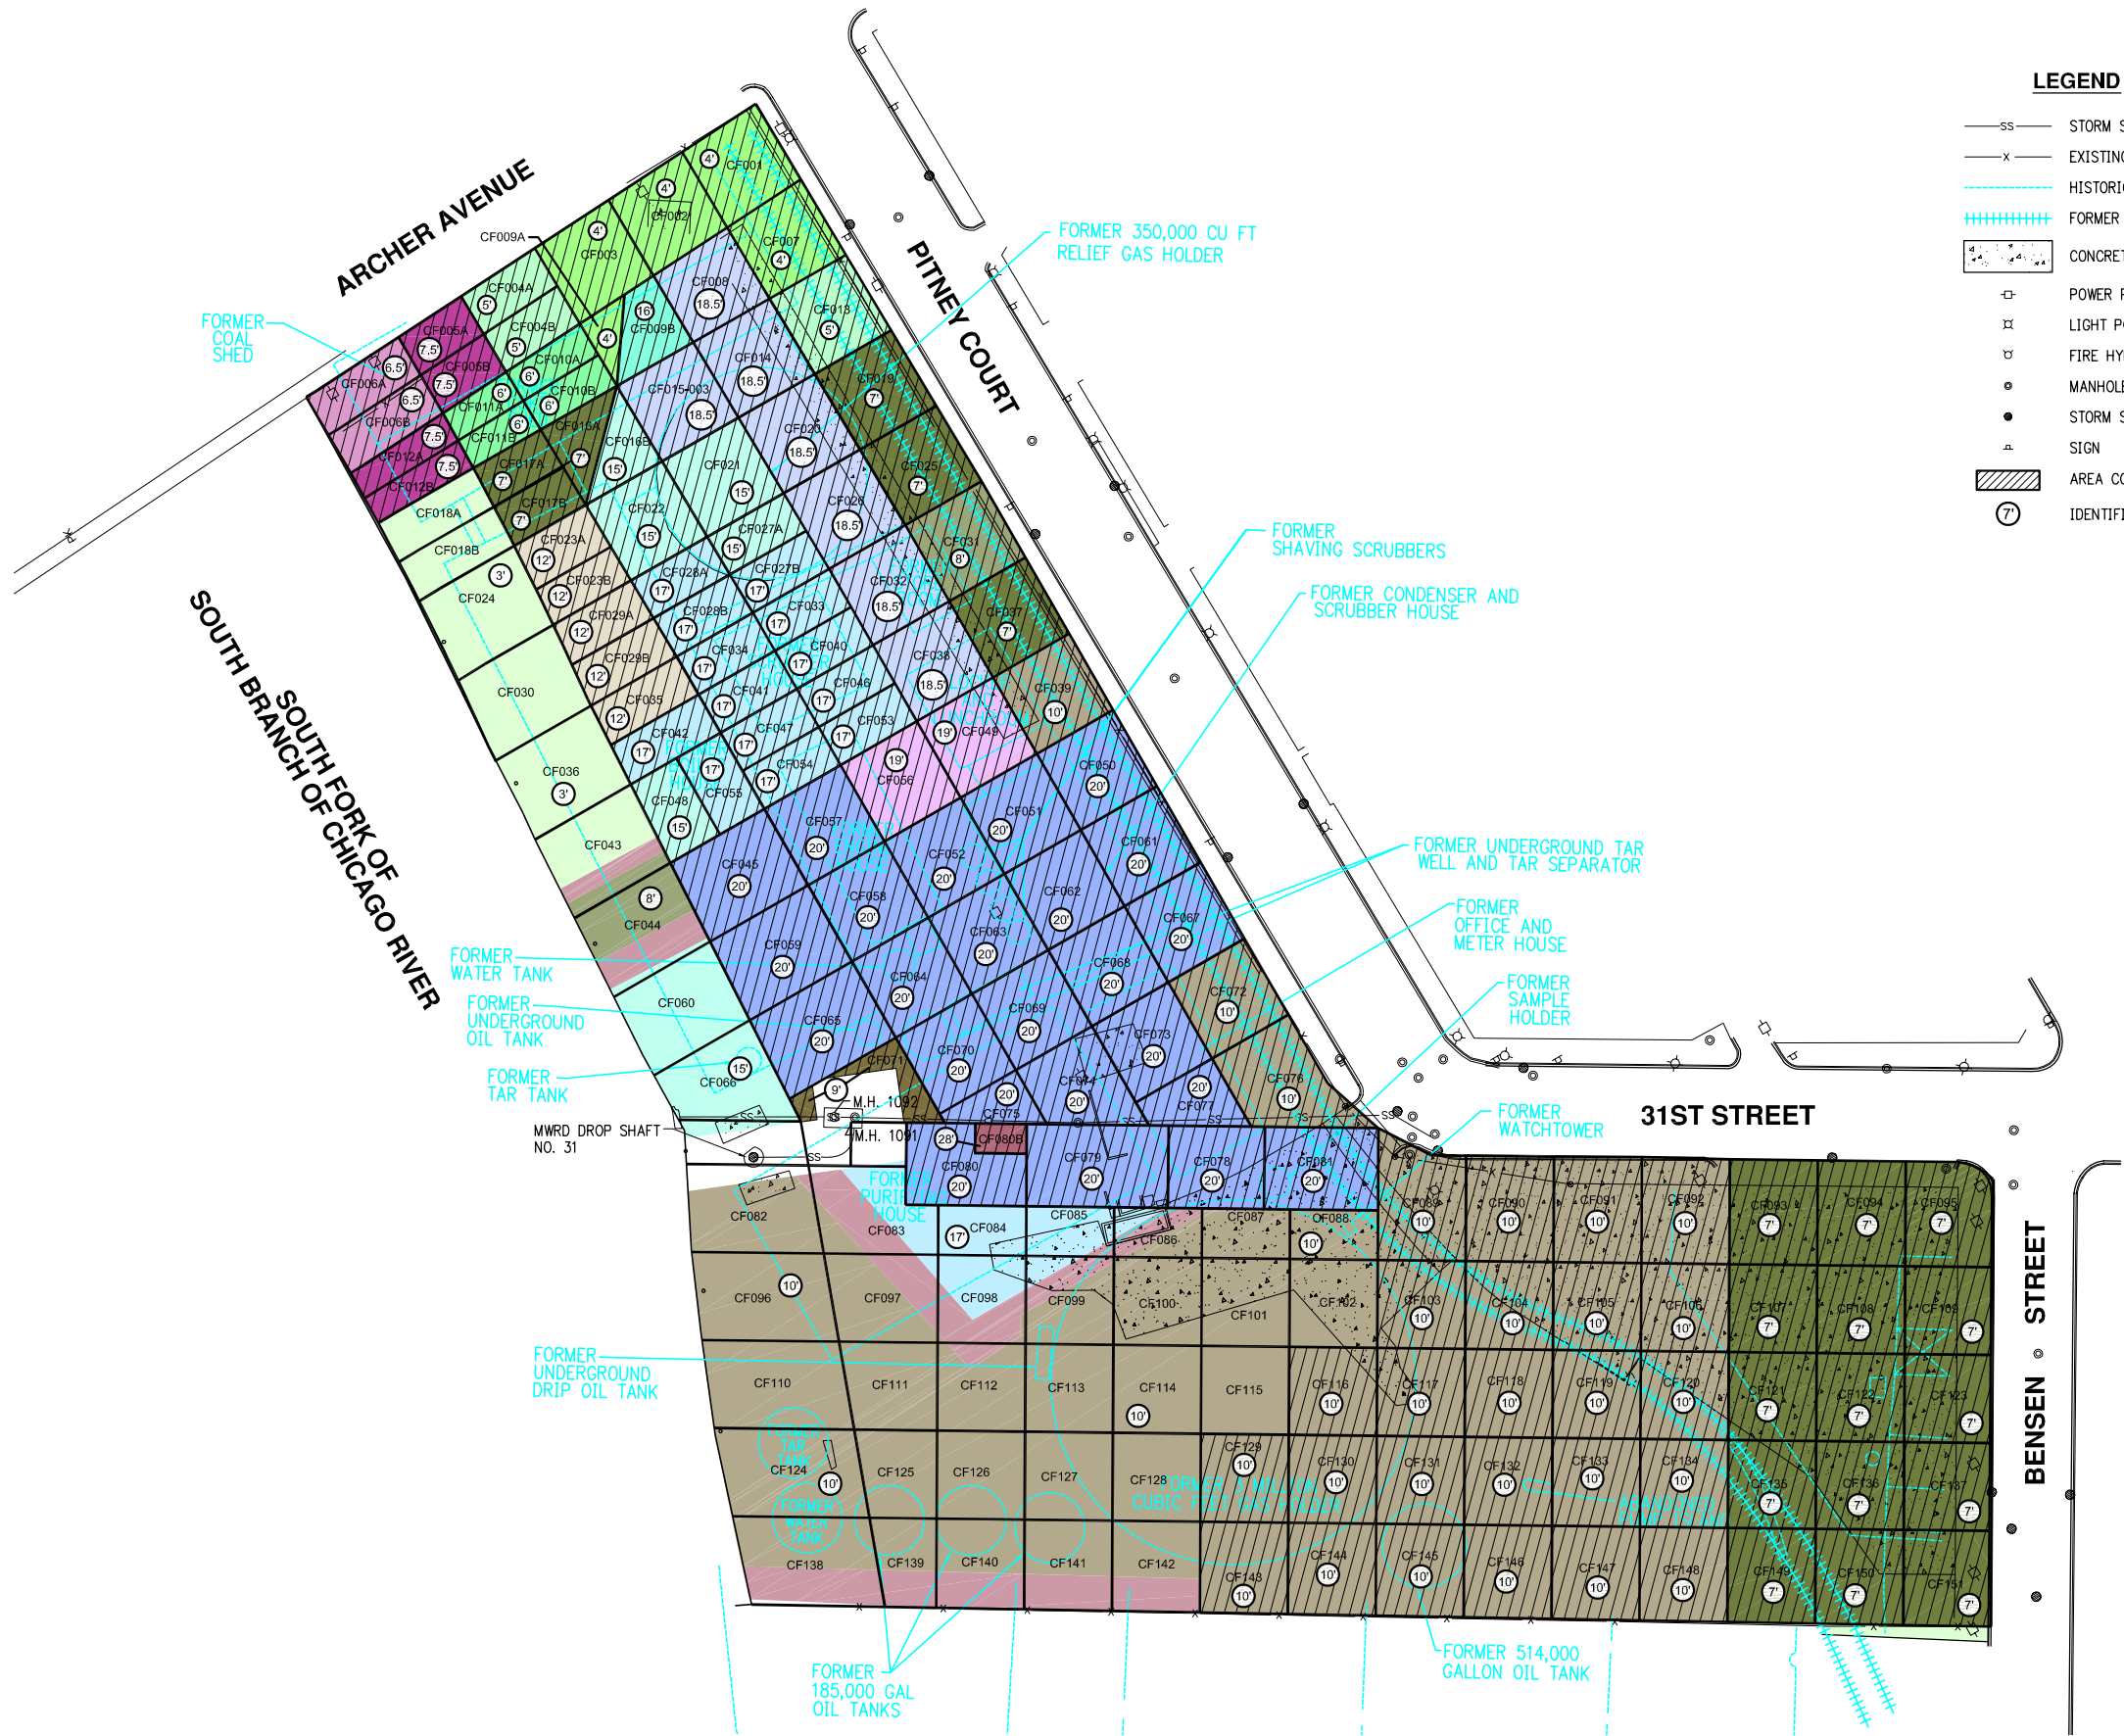

- LEGEND**
- SS STORM SEWER
  - X EXISTING FENCE
  - HISTORICAL FEATURES/FORMER STRUCTURES
  - FORMER RAILROAD TRACKS
  - CONCRETE
  - POWER POLE
  - LIGHT POLE
  - FIRE HYDRANT
  - MANHOLE
  - STORM SEWER/CATCH BASIN
  - SIGN
  - AREA COMPLETED
  - IDENTIFIED DEPTH OF EXCAVATION

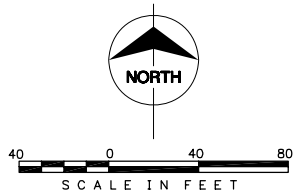

**DRAFT**

**JULY 28, 2007**



date	07-30-07	detailed	G. ALVAREZ
designed	A. HANRAHAN	checked	

THE PEOPLES GAS LIGHT  
AND COKE COMPANY  
CHICAGO, ILLINOIS


PITNEY COURT  
3052 SOUTH PITNEY COURT  
CHICAGO, ILLINOIS

Figure 1  
AS-BUILT EXCAVATION LAYOUT MAP  
PITNEY COURT  
CHICAGO, ILLINOIS

project	27112	contract	
drawing		rev.	

sheet 1 of 1 sheets

file:PEOPLES GAS PITNEY COURT...CAG@BENKOR IN PROGRESS 2007-07-28 PITNEY COURT EXCAVATION

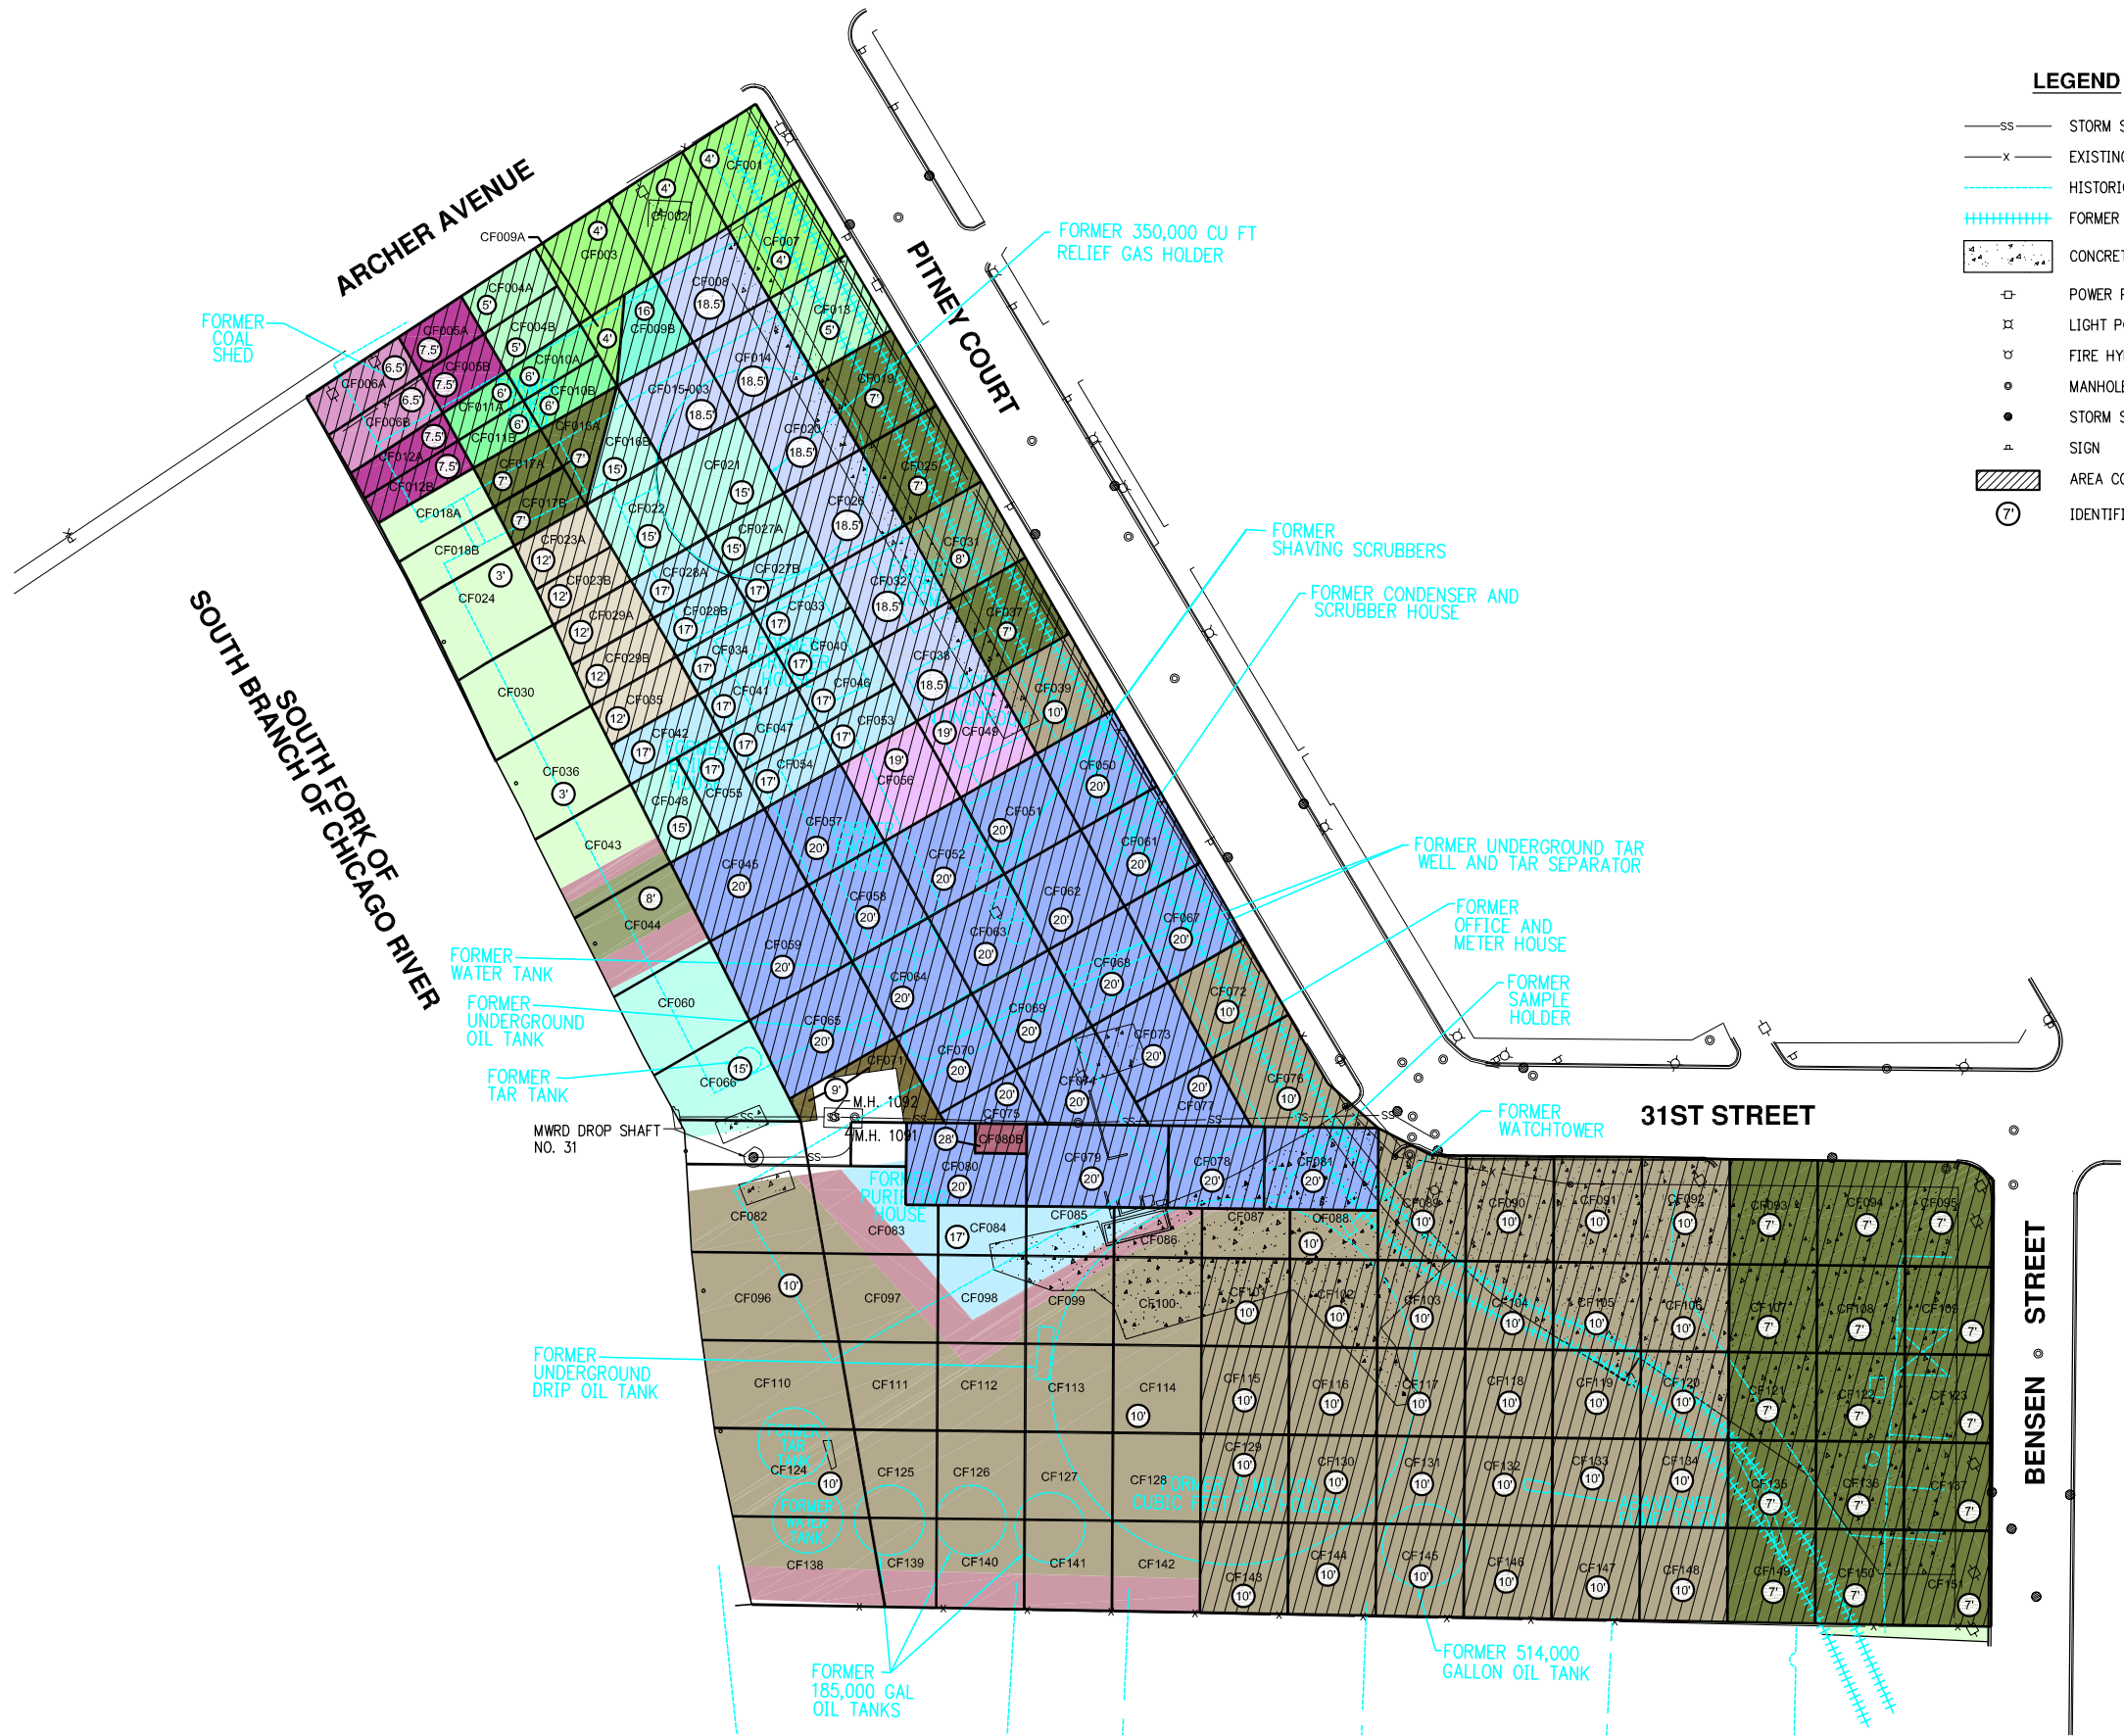

40 0 40 80  
SCALE IN FEET

**DRAFT**

**AUGUST 04, 2007**



date	08-03-07	detailed	G. ALVAREZ
designed	A. HANRAHAN	checked	

**THE PEOPLES GAS LIGHT  
AND COKE COMPANY  
CHICAGO, ILLINOIS**

**PITNEY COURT  
3052 SOUTH PITNEY COURT  
CHICAGO, ILLINOIS**


Figure 1  
AS-BUILT EXCAVATION LAYOUT MAP  
PITNEY COURT  
CHICAGO, ILLINOIS

project	27112	contract	
drawing		rev.	

sheet 1 of 1 sheets

file \\PEOPLES GAS\PITNEY COURT\JAG\BENKIN\IN PROGRESS\2007\244\PITNEY COURT EXCAVATION



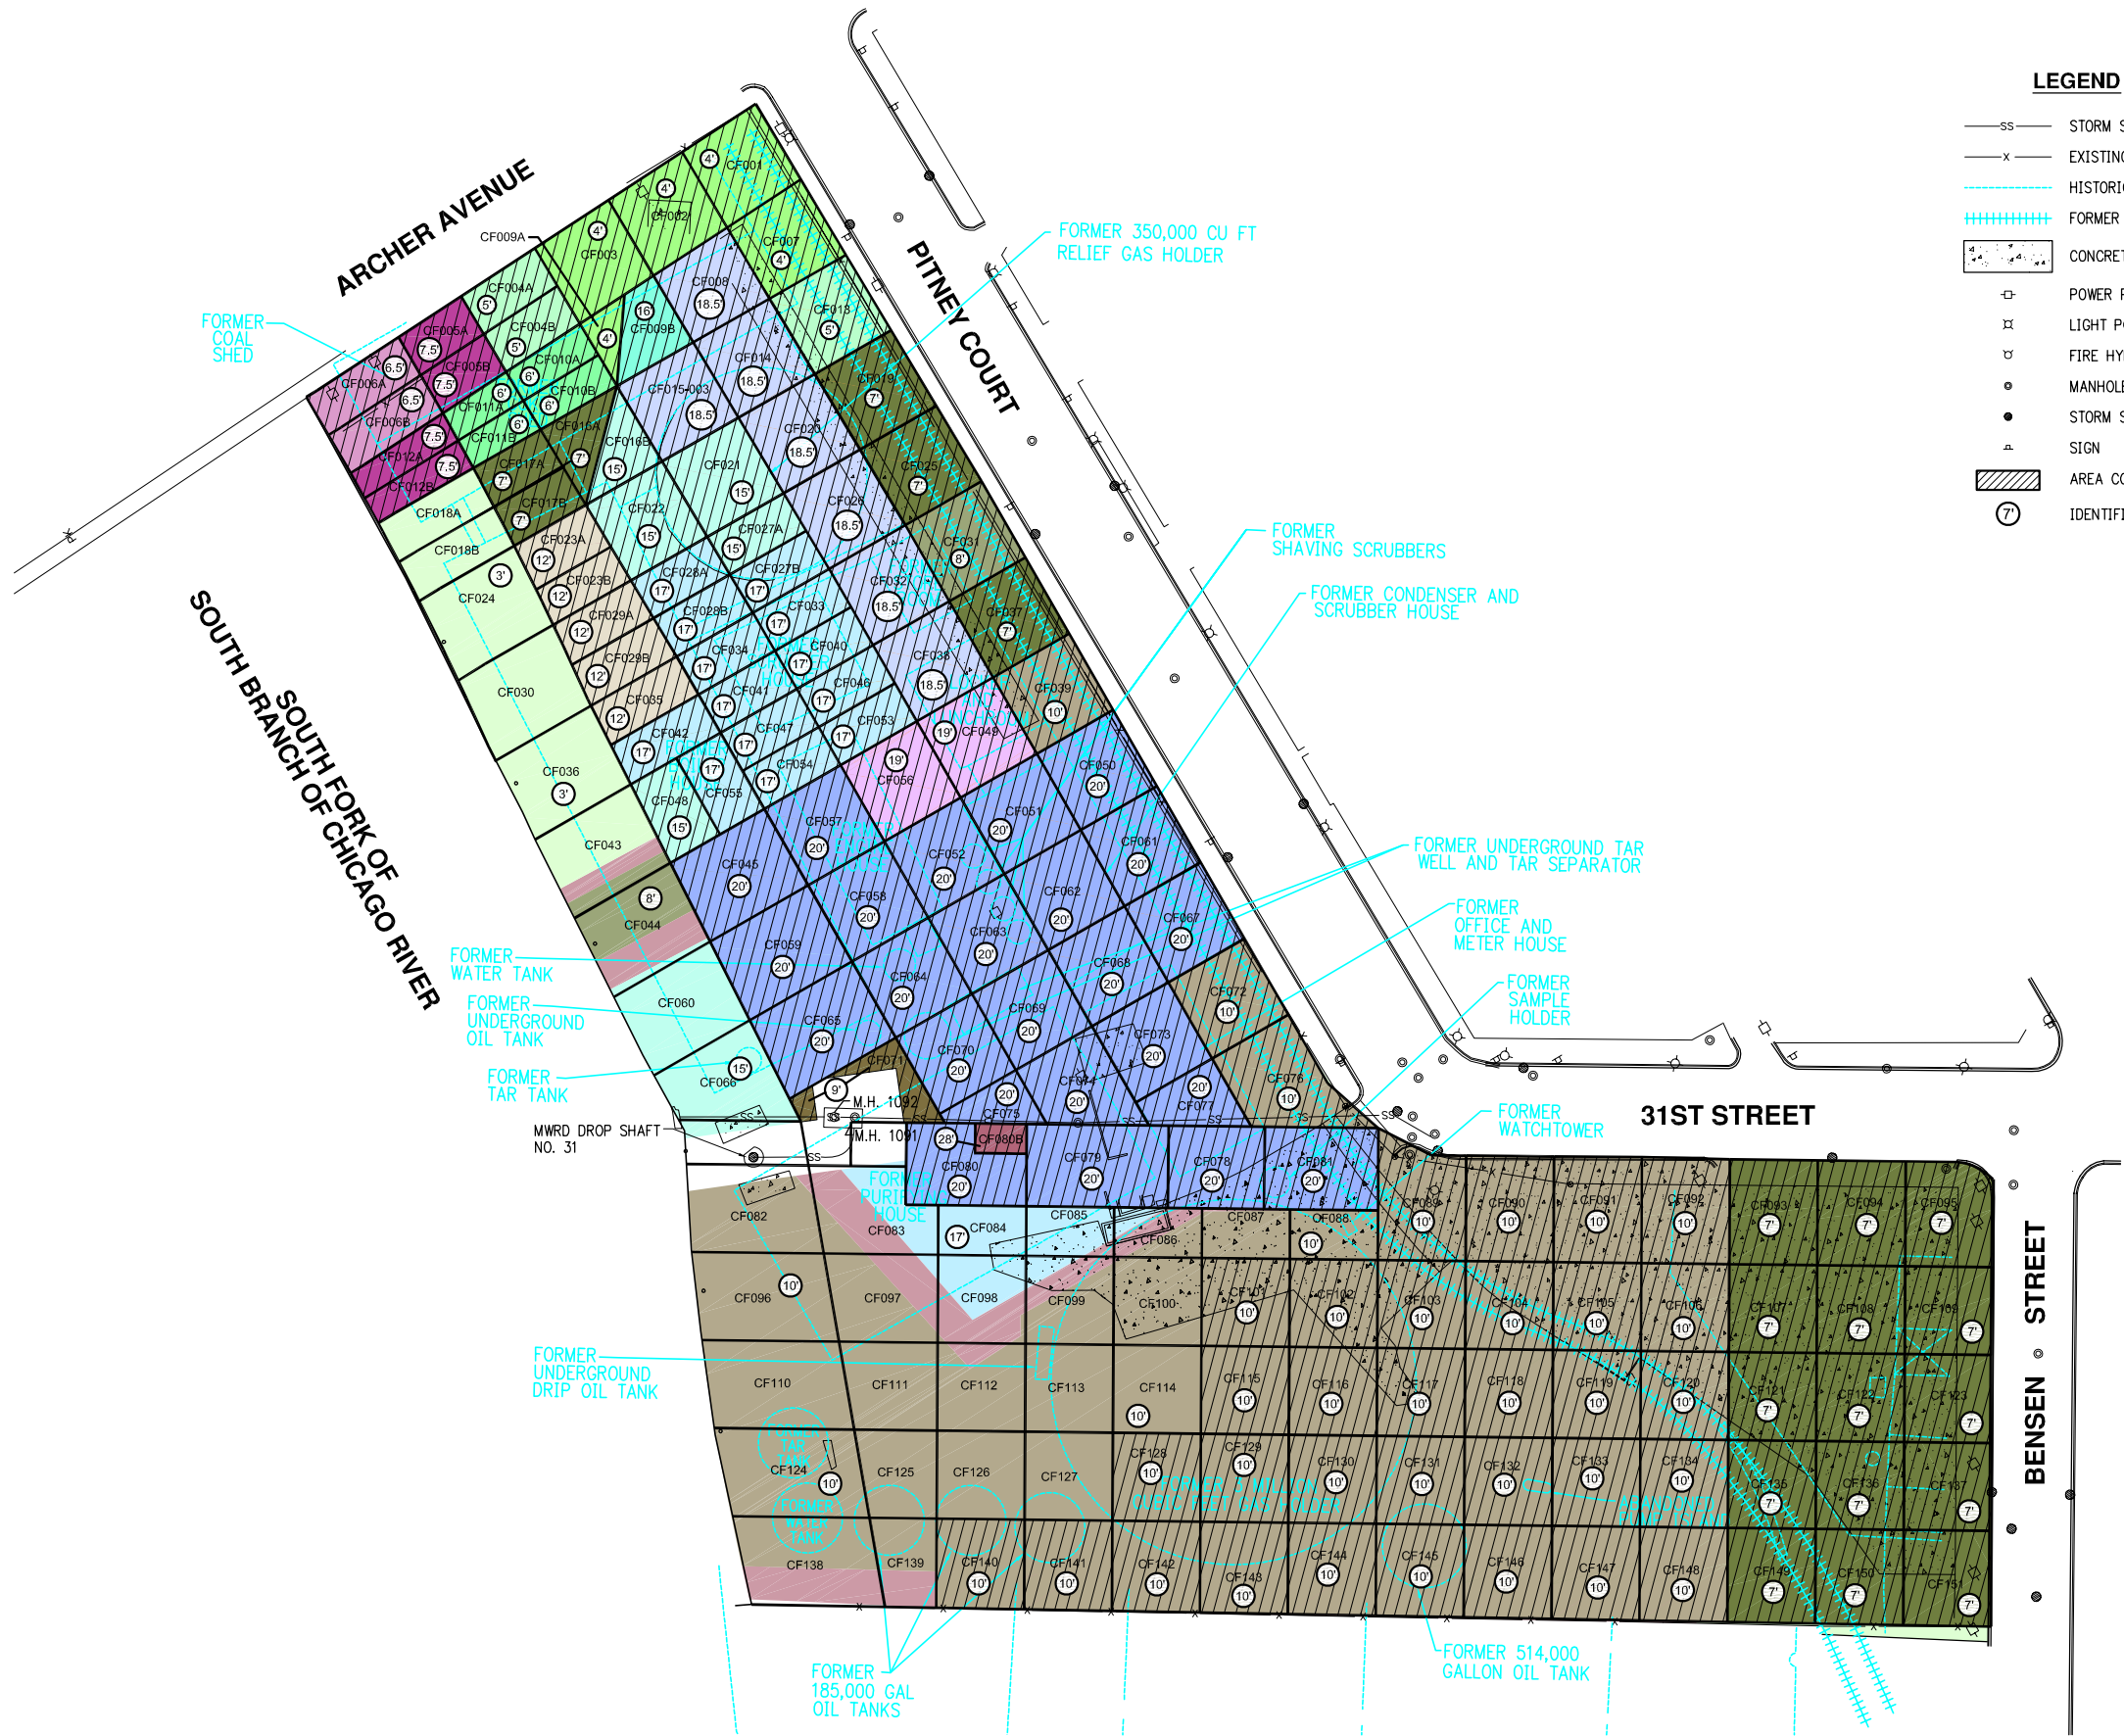

LEGEND

- SS STORM SEWER
- X EXISTING FENCE
- HISTORICAL FEATURES/FORMER STRUCTURES
- FORMER RAILROAD TRACKS
- CONCRETE
- POWER POLE
- LIGHT POLE
- FIRE HYDRANT
- MANHOLE
- STORM SEWER/CATCH BASIN
- SIGN
- AREA COMPLETED
- IDENTIFIED DEPTH OF EXCAVATION



40 0 40 80  
SCALE IN FEET

DRAFT

AUGUST 18, 2007



date	08-18-07	detailed	G. ALVAREZ
designed	A. HANRAHAN	checked	

THE PEOPLES GAS LIGHT  
AND COKE COMPANY  
CHICAGO, ILLINOIS


PITNEY COURT  
3052 SOUTH PITNEY COURT  
CHICAGO, ILLINOIS

Figure 1  
AS-BUILT EXCAVATION LAYOUT MAP  
PITNEY COURT  
CHICAGO, ILLINOIS

project	27112	contract	
drawing		rev.	

sheet 1 of 1 sheets

file:PEOPLES GAS PITNEY COURT...CAG@BENKOR\INPROGRESS\2007-08-18\PITNEY COURT EXCAVATION

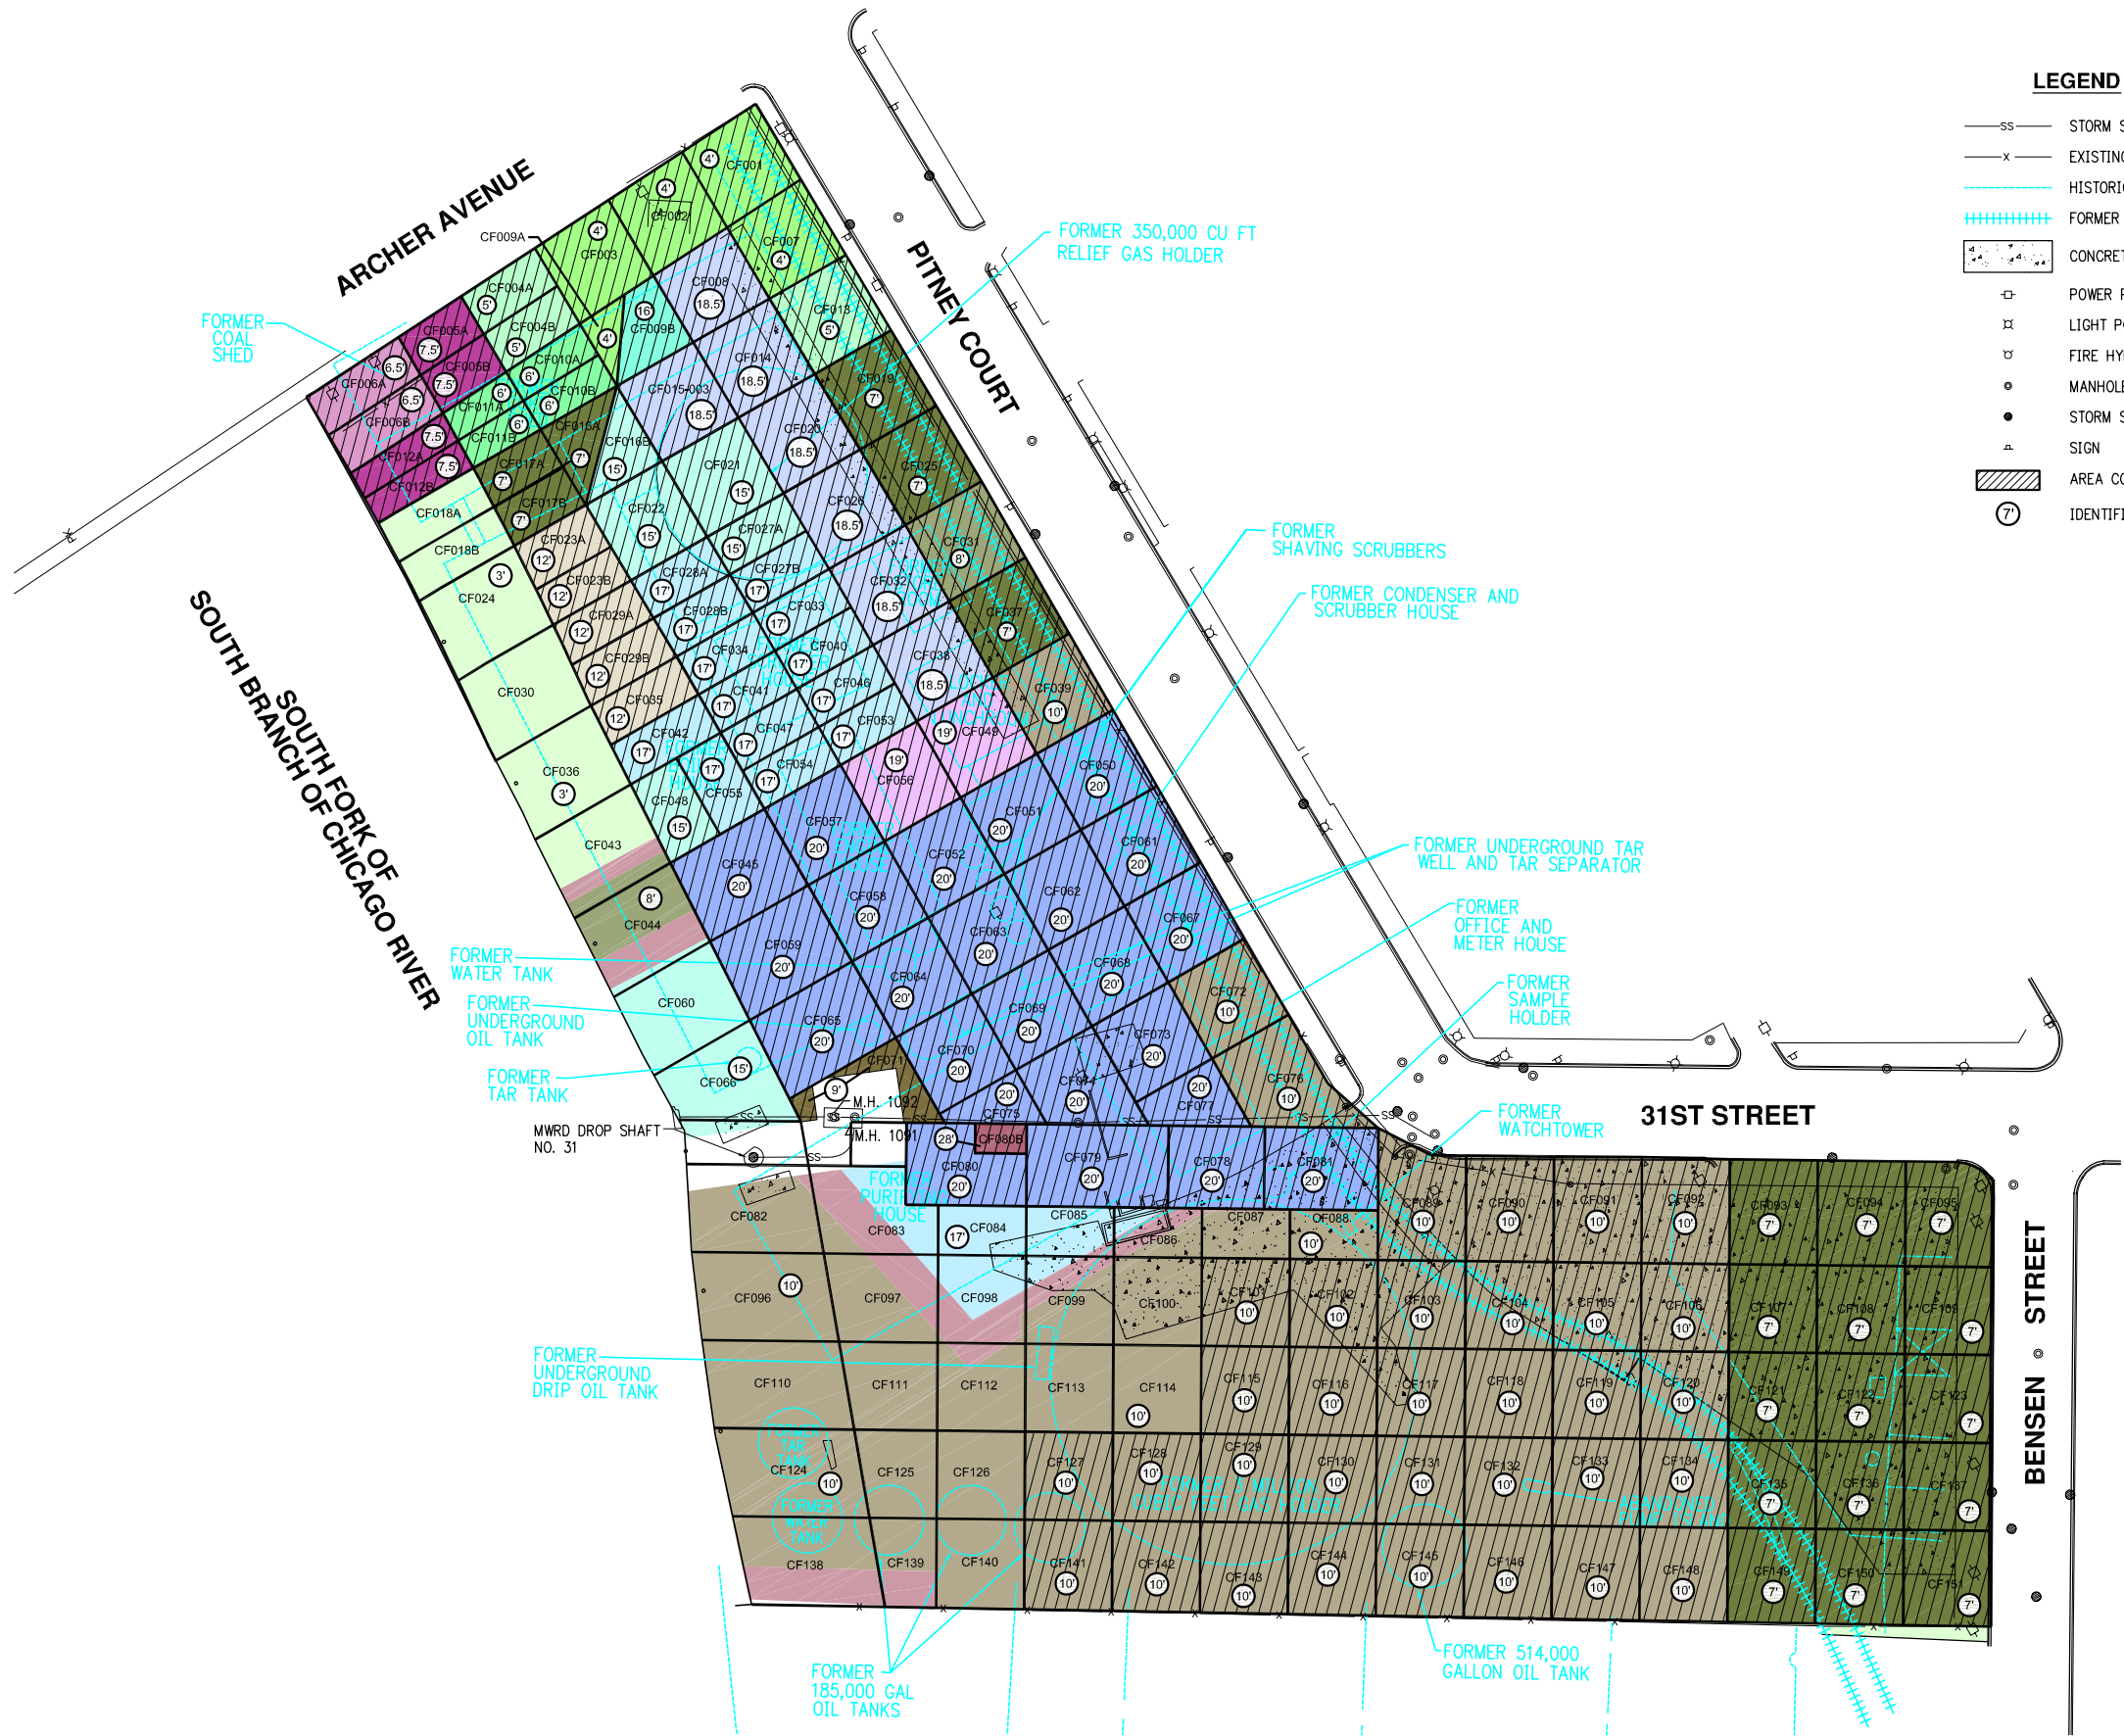

**DRAFT**

**AUGUST 25, 2007**



date	08-27-07	detailed	G. ALVAREZ
designed	A. HANRAHAN	checked	

THE PEOPLES GAS LIGHT  
AND COKE COMPANY  
CHICAGO, ILLINOIS

PITNEY COURT  
3052 SOUTH PITNEY COURT  
CHICAGO, ILLINOIS

Figure 1  
AS-BUILT EXCAVATION LAYOUT MAP  
PITNEY COURT  
CHICAGO, ILLINOIS


project	27112	contract	
---------	-------	----------	--

drawing		rev.	
---------	--	------	--

sheet	1	of	1	sheets
-------	---	----	---	--------


file:PEOPLES GAS PITNEY COURT...CAG@BENKOR\INPROGRESS\2007-08-25 PITNEY COURT EXCAVATION




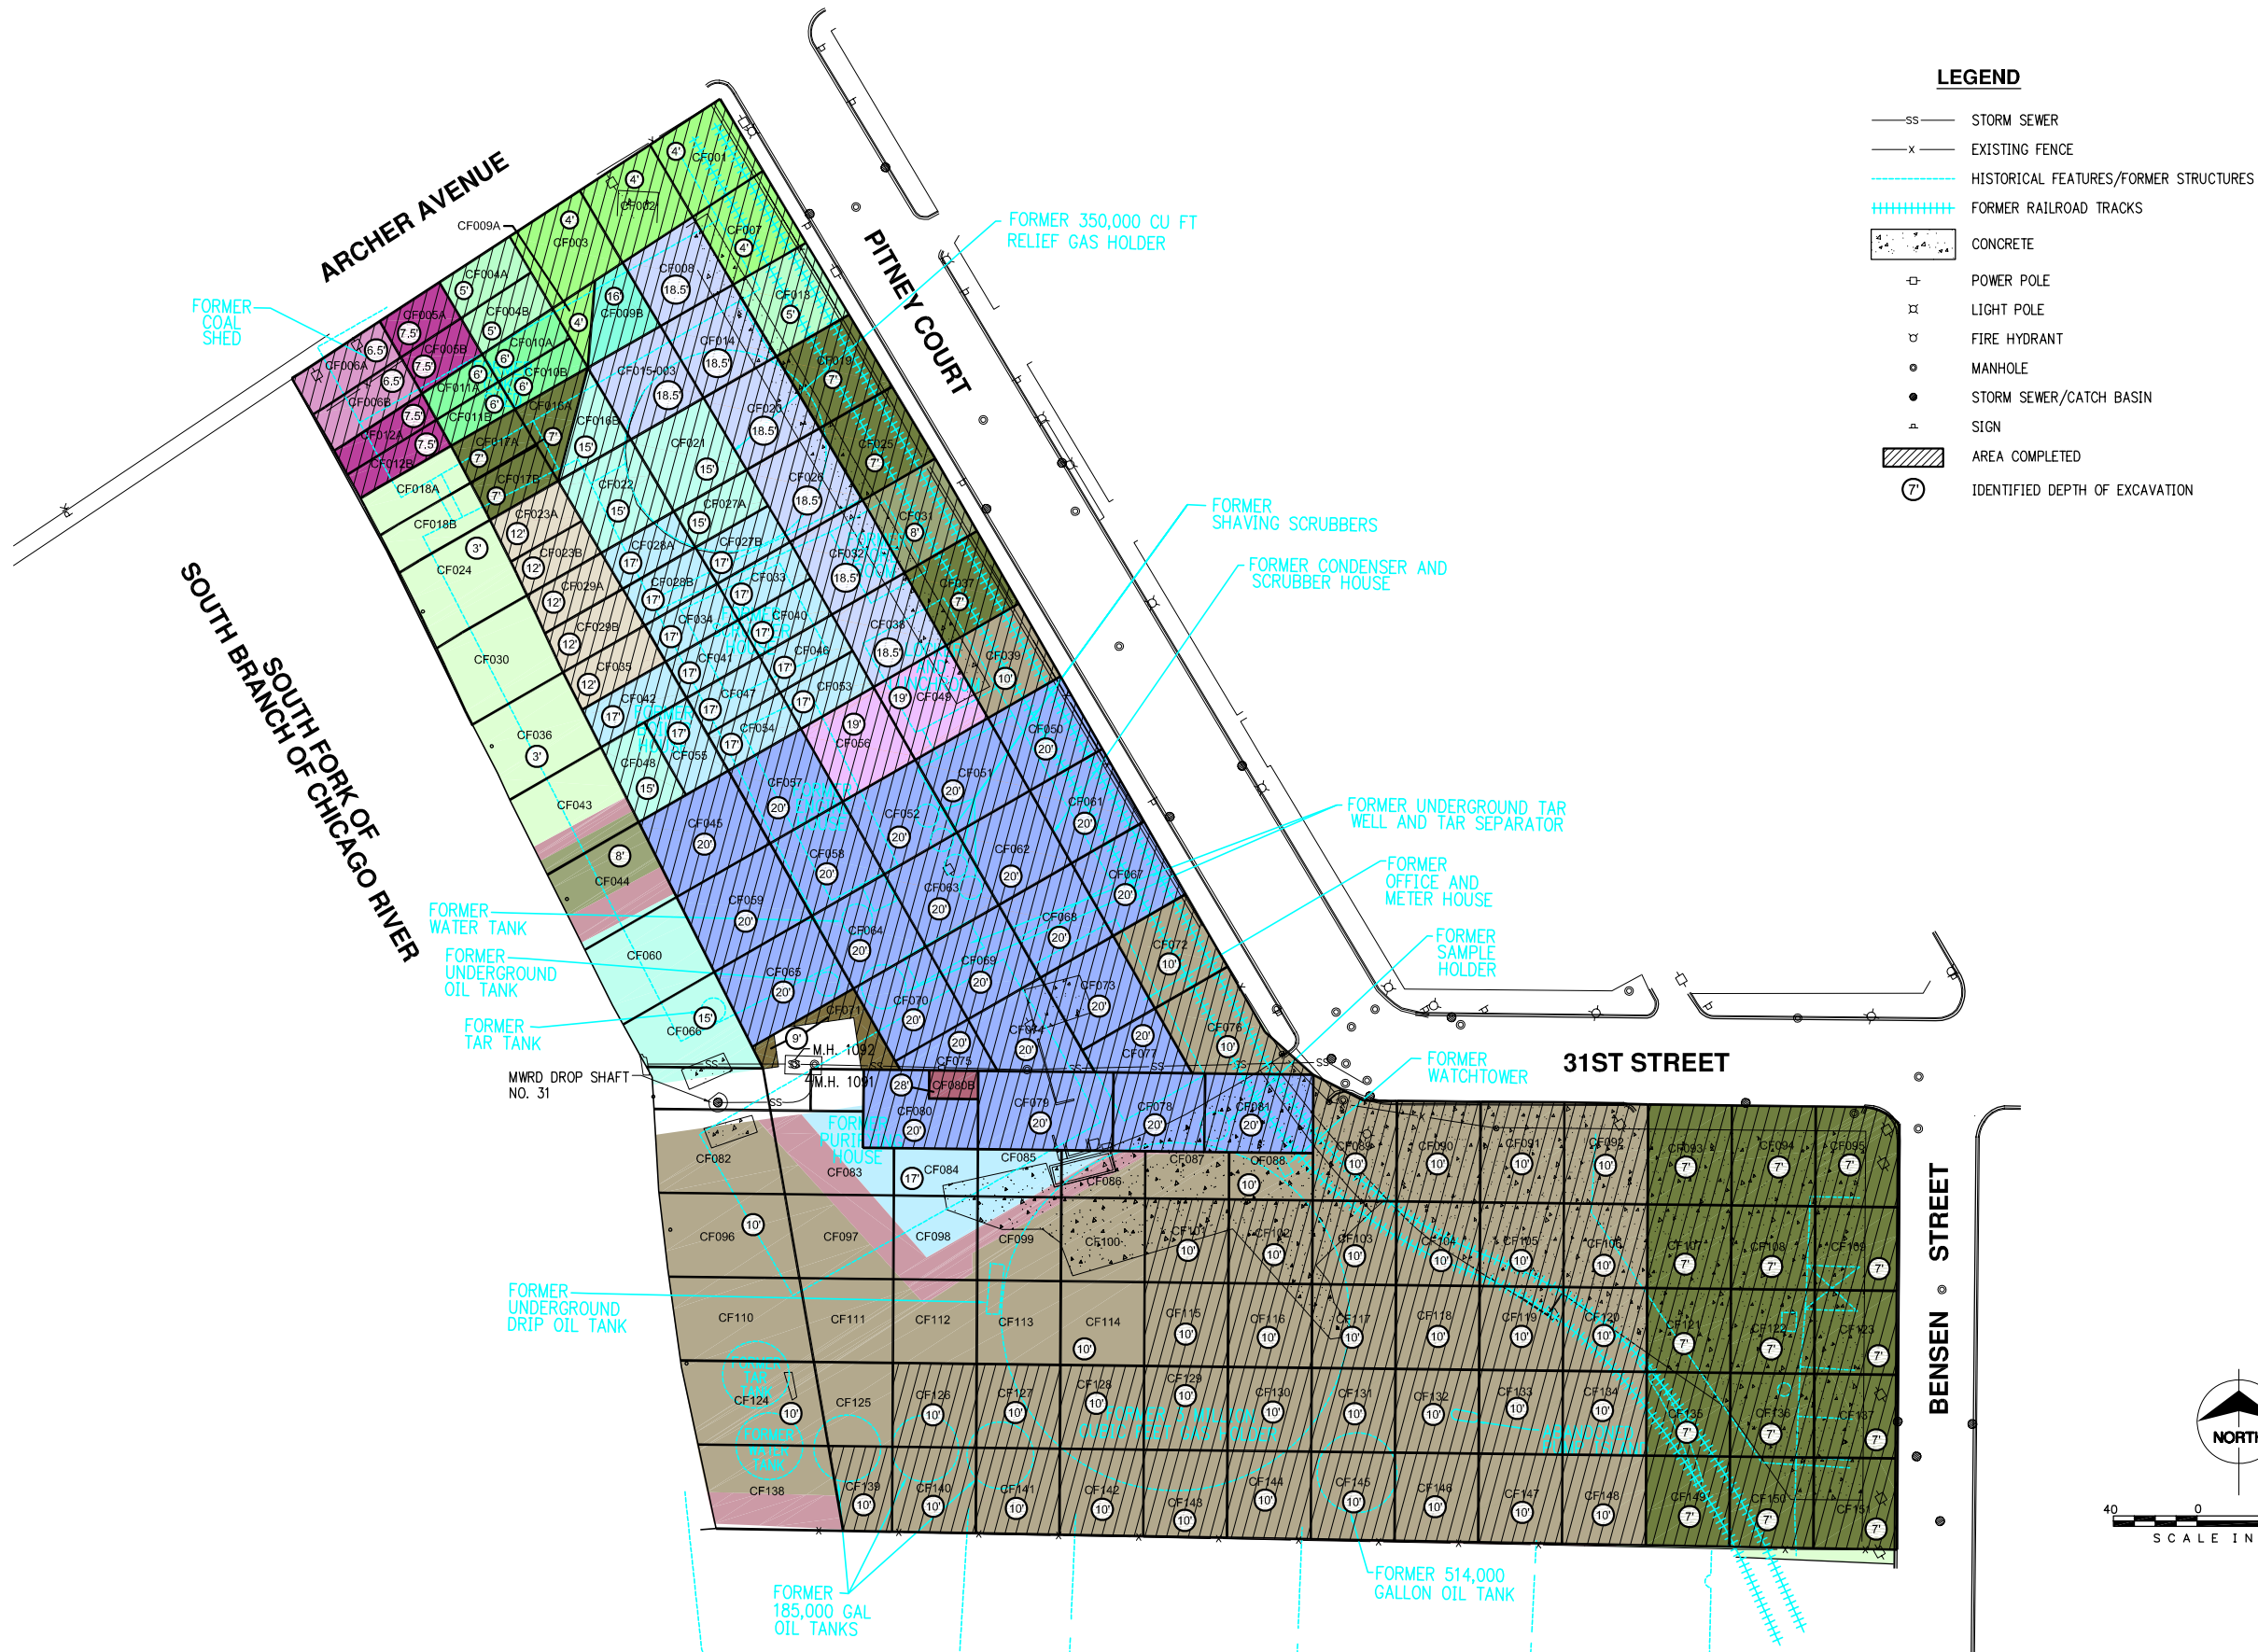

DRAFT

SEPTEMBER 01, 2007

	
date 08-30-07	detailed G. ALVAREZ
designed A. HANRAHAN	checked
THE PEOPLES GAS LIGHT AND COKE COMPANY CHICAGO, ILLINOIS	
PITNEY COURT 3052 SOUTH PITNEY COURT CHICAGO, ILLINOIS	
Figure 1 AS-BUILT EXCAVATION LAYOUT MAP PITNEY COURT CHICAGO, ILLINOIS	
project 27112	contract
drawing	rev.
sheet 1 of 1 sheets	
file \\PEOPLES GAS\PITNEY COURT\JAG\BENKIN\IN PROGRESS\2007-08-30\PITNEY COURT EXCAVATION	

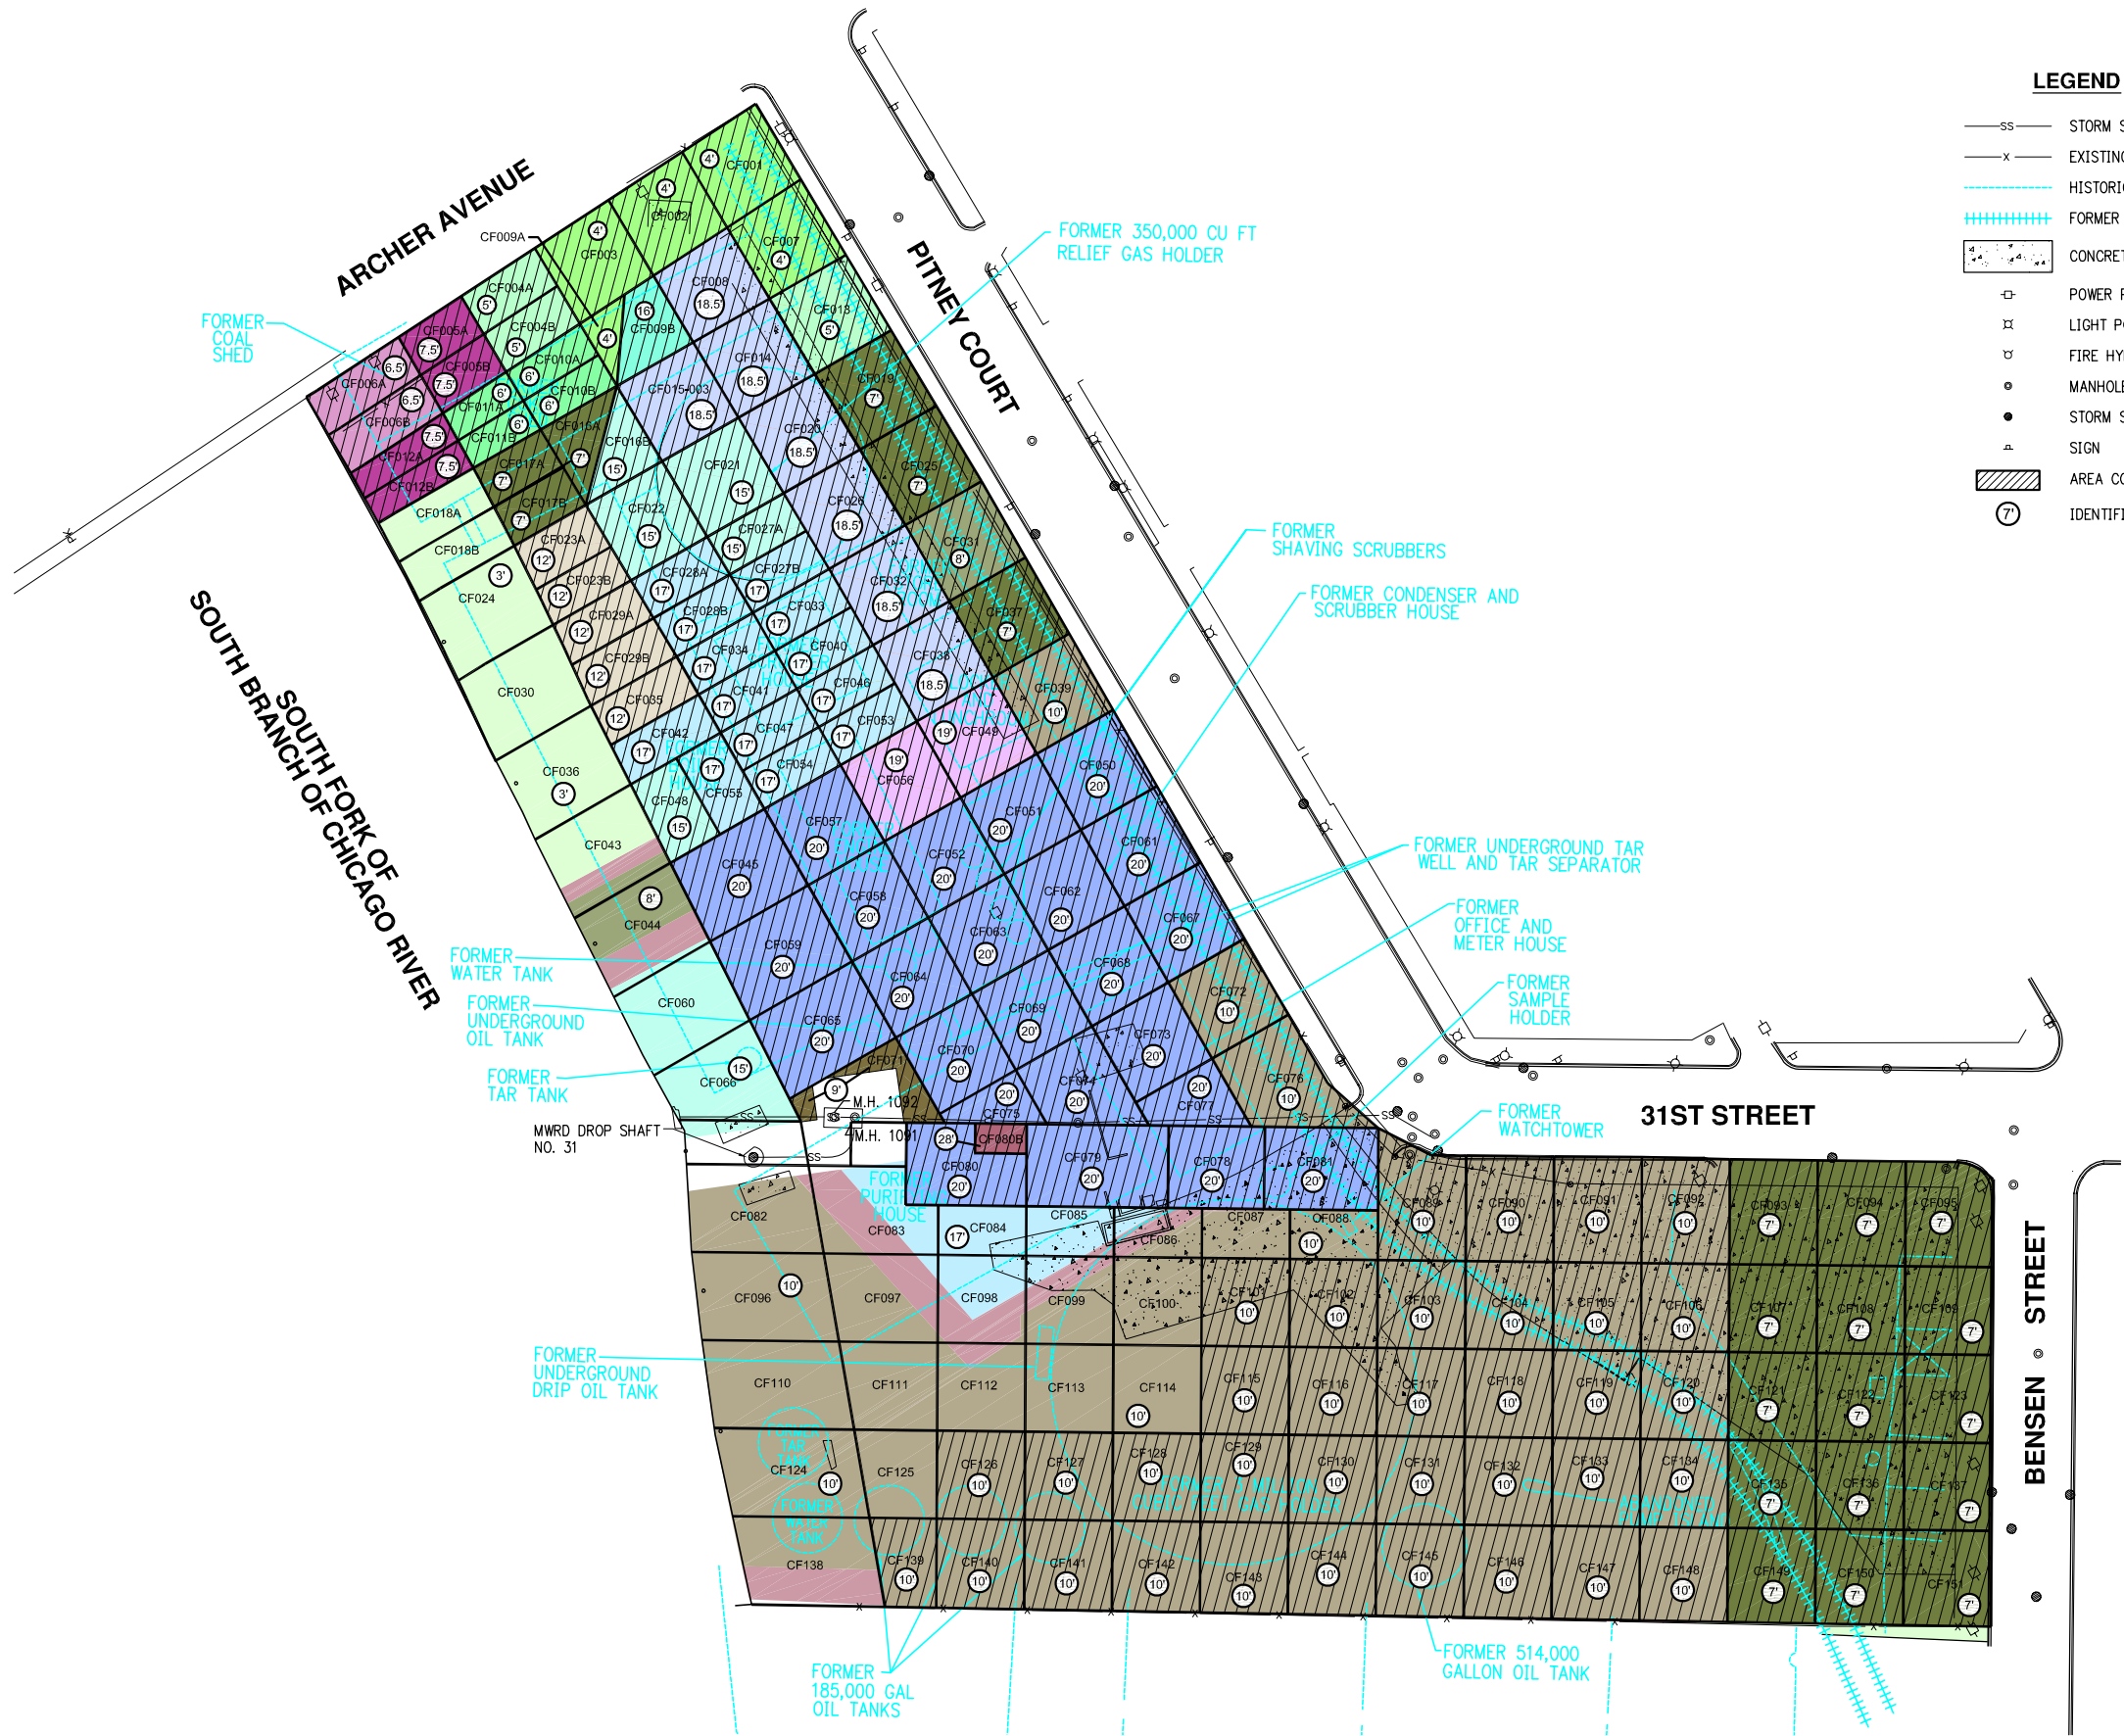

LEGEND

- SS STORM SEWER
- X EXISTING FENCE
- HISTORICAL FEATURES/FORMER STRUCTURES
- FORMER RAILROAD TRACKS
- CONCRETE
- POWER POLE
- LIGHT POLE
- FIRE HYDRANT
- MANHOLE
- STORM SEWER/CATCH BASIN
- SIGN
- AREA COMPLETED
- IDENTIFIED DEPTH OF EXCAVATION



DRAFT

SEPTEMBER 08, 2007



date	09-07-07	detailed	J. PEREZ
designed	A. HANRAHAN	checked	

THE PEOPLES GAS LIGHT  
AND COKE COMPANY  
CHICAGO, ILLINOIS

PITNEY COURT  
3052 SOUTH PITNEY COURT  
CHICAGO, ILLINOIS

Figure 1  
AS-BUILT EXCAVATION LAYOUT MAP  
PITNEY COURT  
CHICAGO, ILLINOIS

project	27112	contract	
drawing		rev.	

sheet 1 of 1 sheets


file:PEOPLES GAS PITNEY COURT...CAG@BENKOR\INPROGRESS\2007-09-08\PITNEY COURT EXCAVATION






DRAFT


SEPTEMBER 15, 2007

	
date 09-15-07	detailed J. PEREZ
designed A. HANRAHAN	checked
THE PEOPLES GAS LIGHT AND COKE COMPANY CHICAGO, ILLINOIS	
PITNEY COURT 3052 SOUTH PITNEY COURT CHICAGO, ILLINOIS	
Figure 1 AS-BUILT EXCAVATION LAYOUT MAP PITNEY COURT CHICAGO, ILLINOIS	
project 27112	contract
drawing	rev.
sheet 1 of 1 sheets	
file \\PEOPLES GAS\PITNEY COURT\JAG\BENKOR\IN PROGRESS\2007-09-15\PITNEY COURT EXCAVATION	

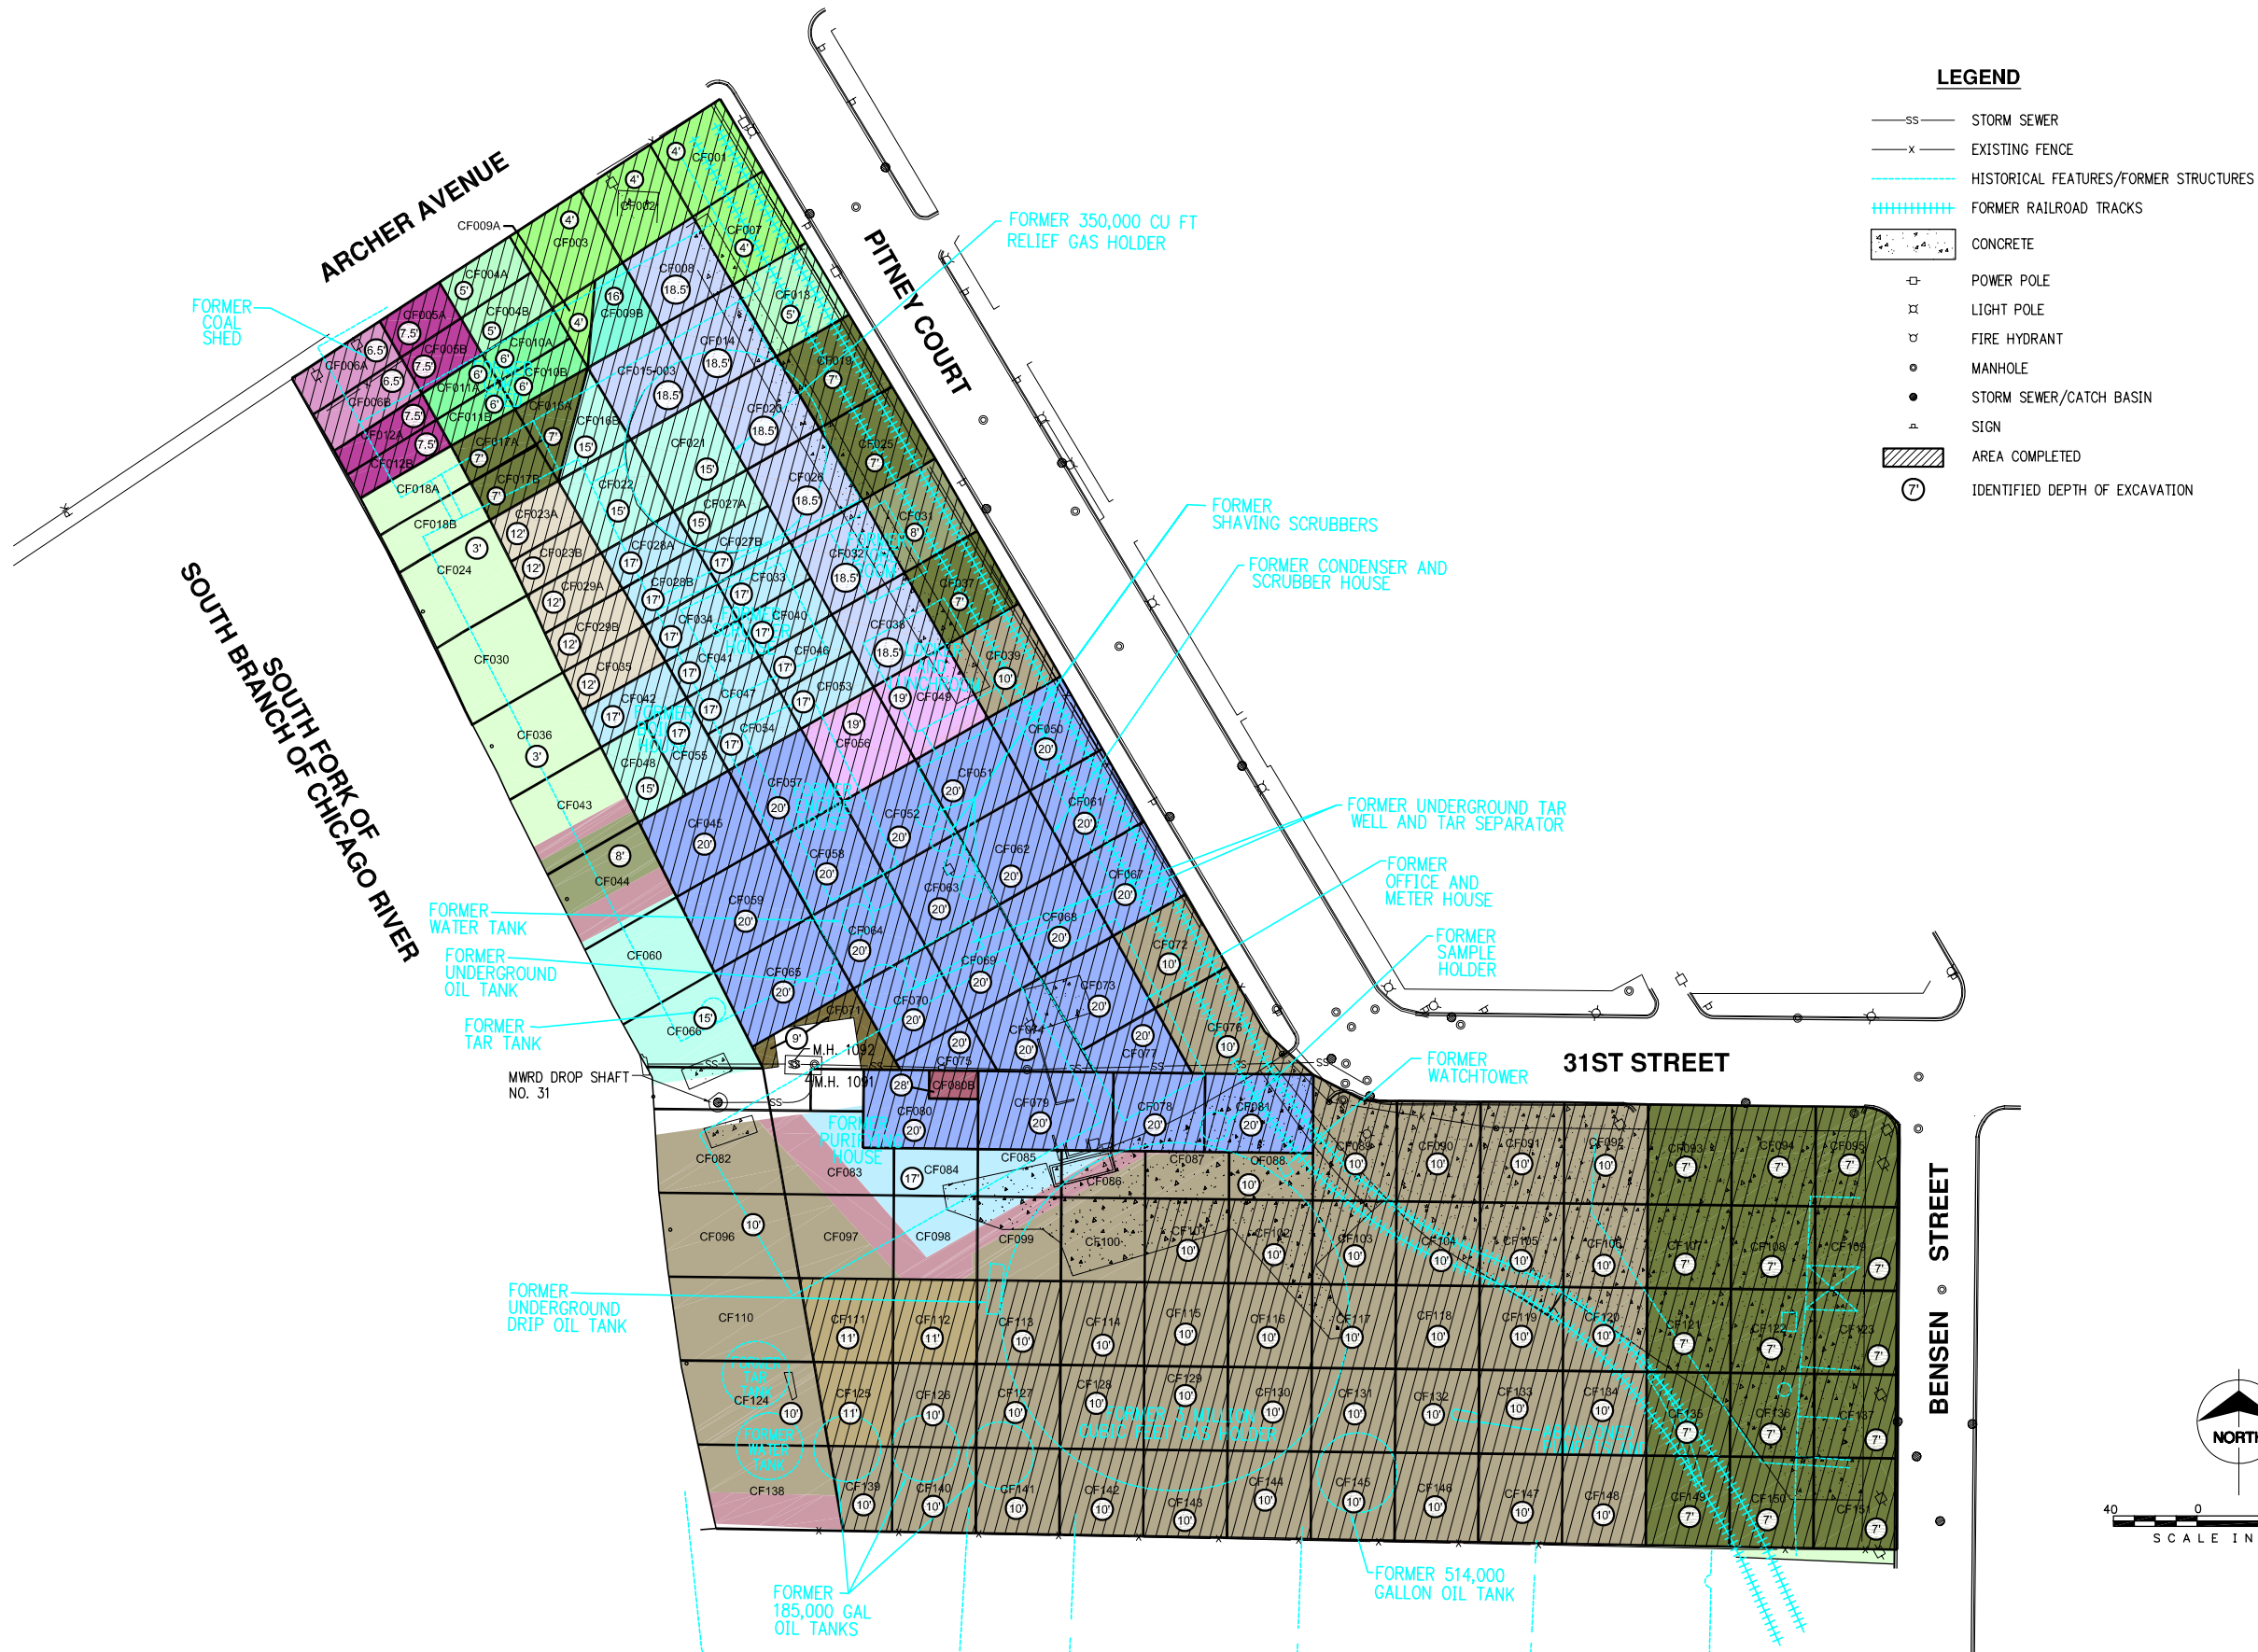


DRAFT

SEPTEMBER 22, 2007


	
date 09-22-07	detailed J. PEREZ
designed A. HANRAHAN	checked
THE PEOPLES GAS LIGHT AND COKE COMPANY CHICAGO, ILLINOIS	
PITNEY COURT 3052 SOUTH PITNEY COURT CHICAGO, ILLINOIS	
Figure 1 AS-BUILT EXCAVATION LAYOUT MAP PITNEY COURT CHICAGO, ILLINOIS	
project 27112	contract
drawing	rev.
sheet 1 of 1 sheets	
file \\PEOPLES GAS\PITNEY COURT\JAG\BENKOR\IN PROGRESS\2007-09-22\PITNEY COURT EXCAVATION	



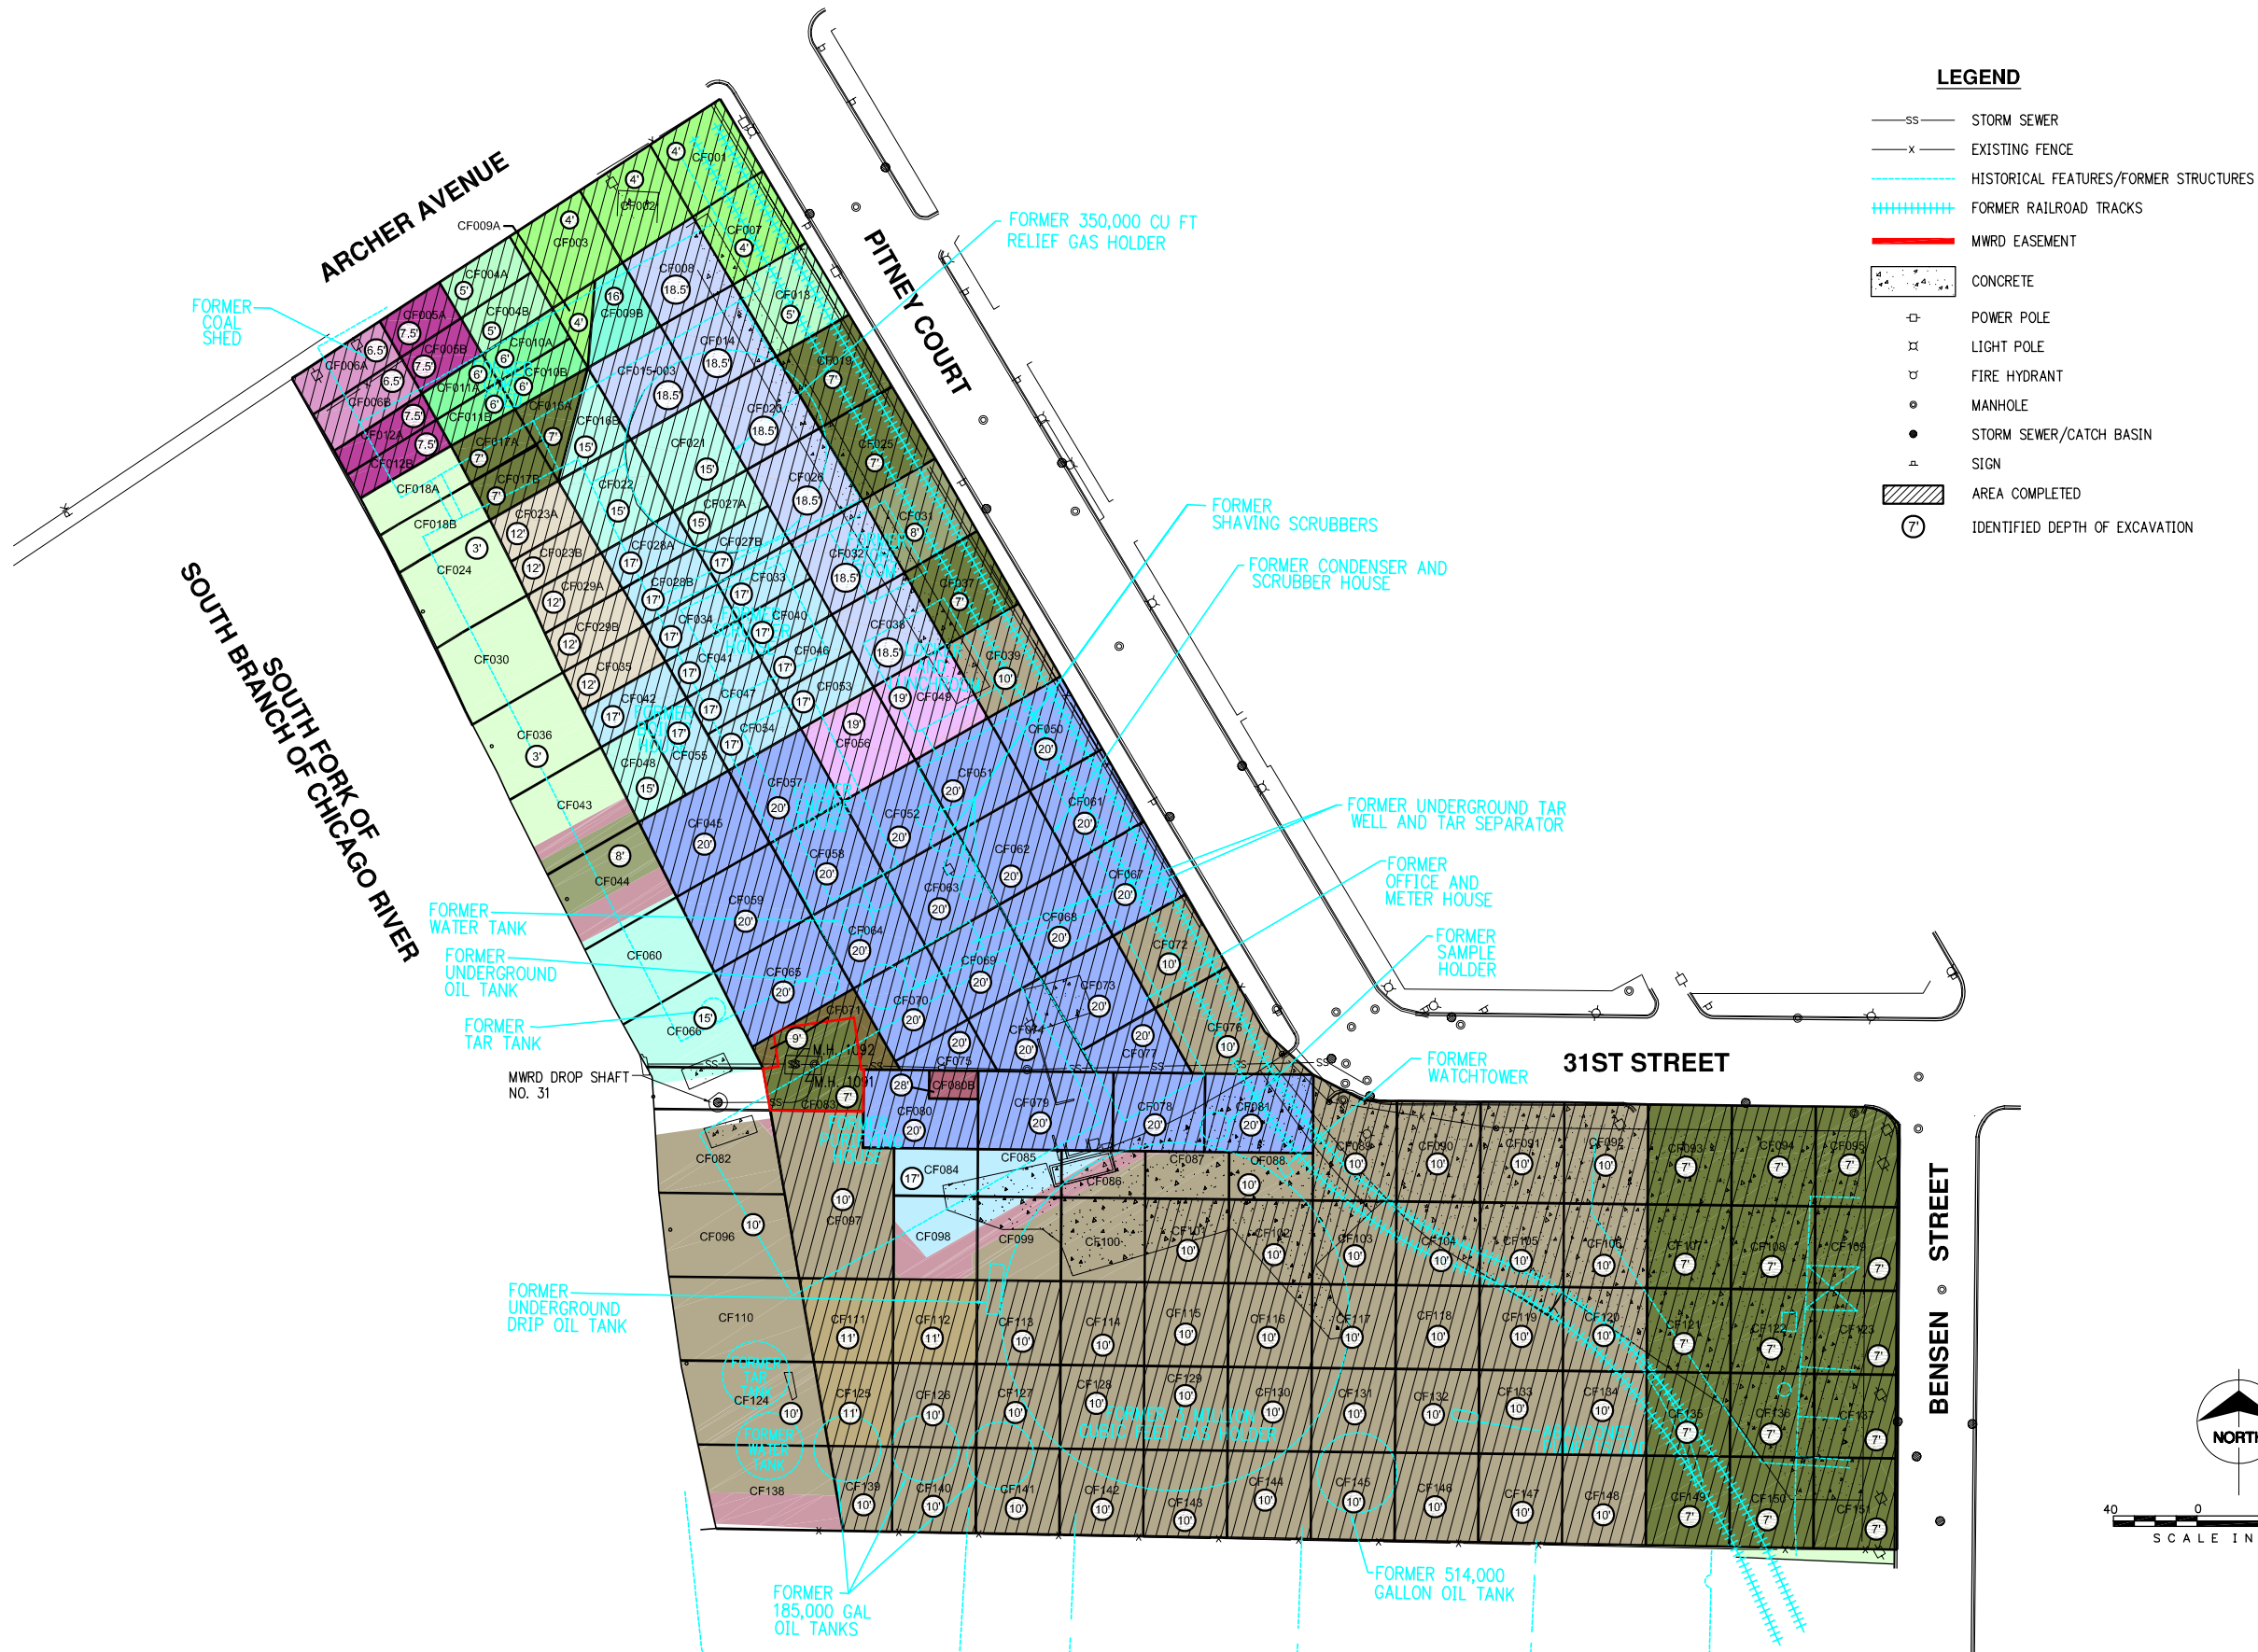


DRAFT

SEPTEMBER 29, 2007

	
date 09-29-07	detailed J. PEREZ
designed A. HANRAHAN	checked
THE PEOPLES GAS LIGHT AND COKE COMPANY CHICAGO, ILLINOIS	
PITNEY COURT 3052 SOUTH PITNEY COURT CHICAGO, ILLINOIS	
Figure 1 AS-BUILT EXCAVATION LAYOUT MAP PITNEY COURT CHICAGO, ILLINOIS	
project 27112	contract
drawing	rev.
sheet 1 of 1 sheets	
file:PEOPLES GAS/PITNEY COURT.../CAD/BENKOR IN PROGRESS/2007-09-29/PITNEY COURT EXCAVATION	



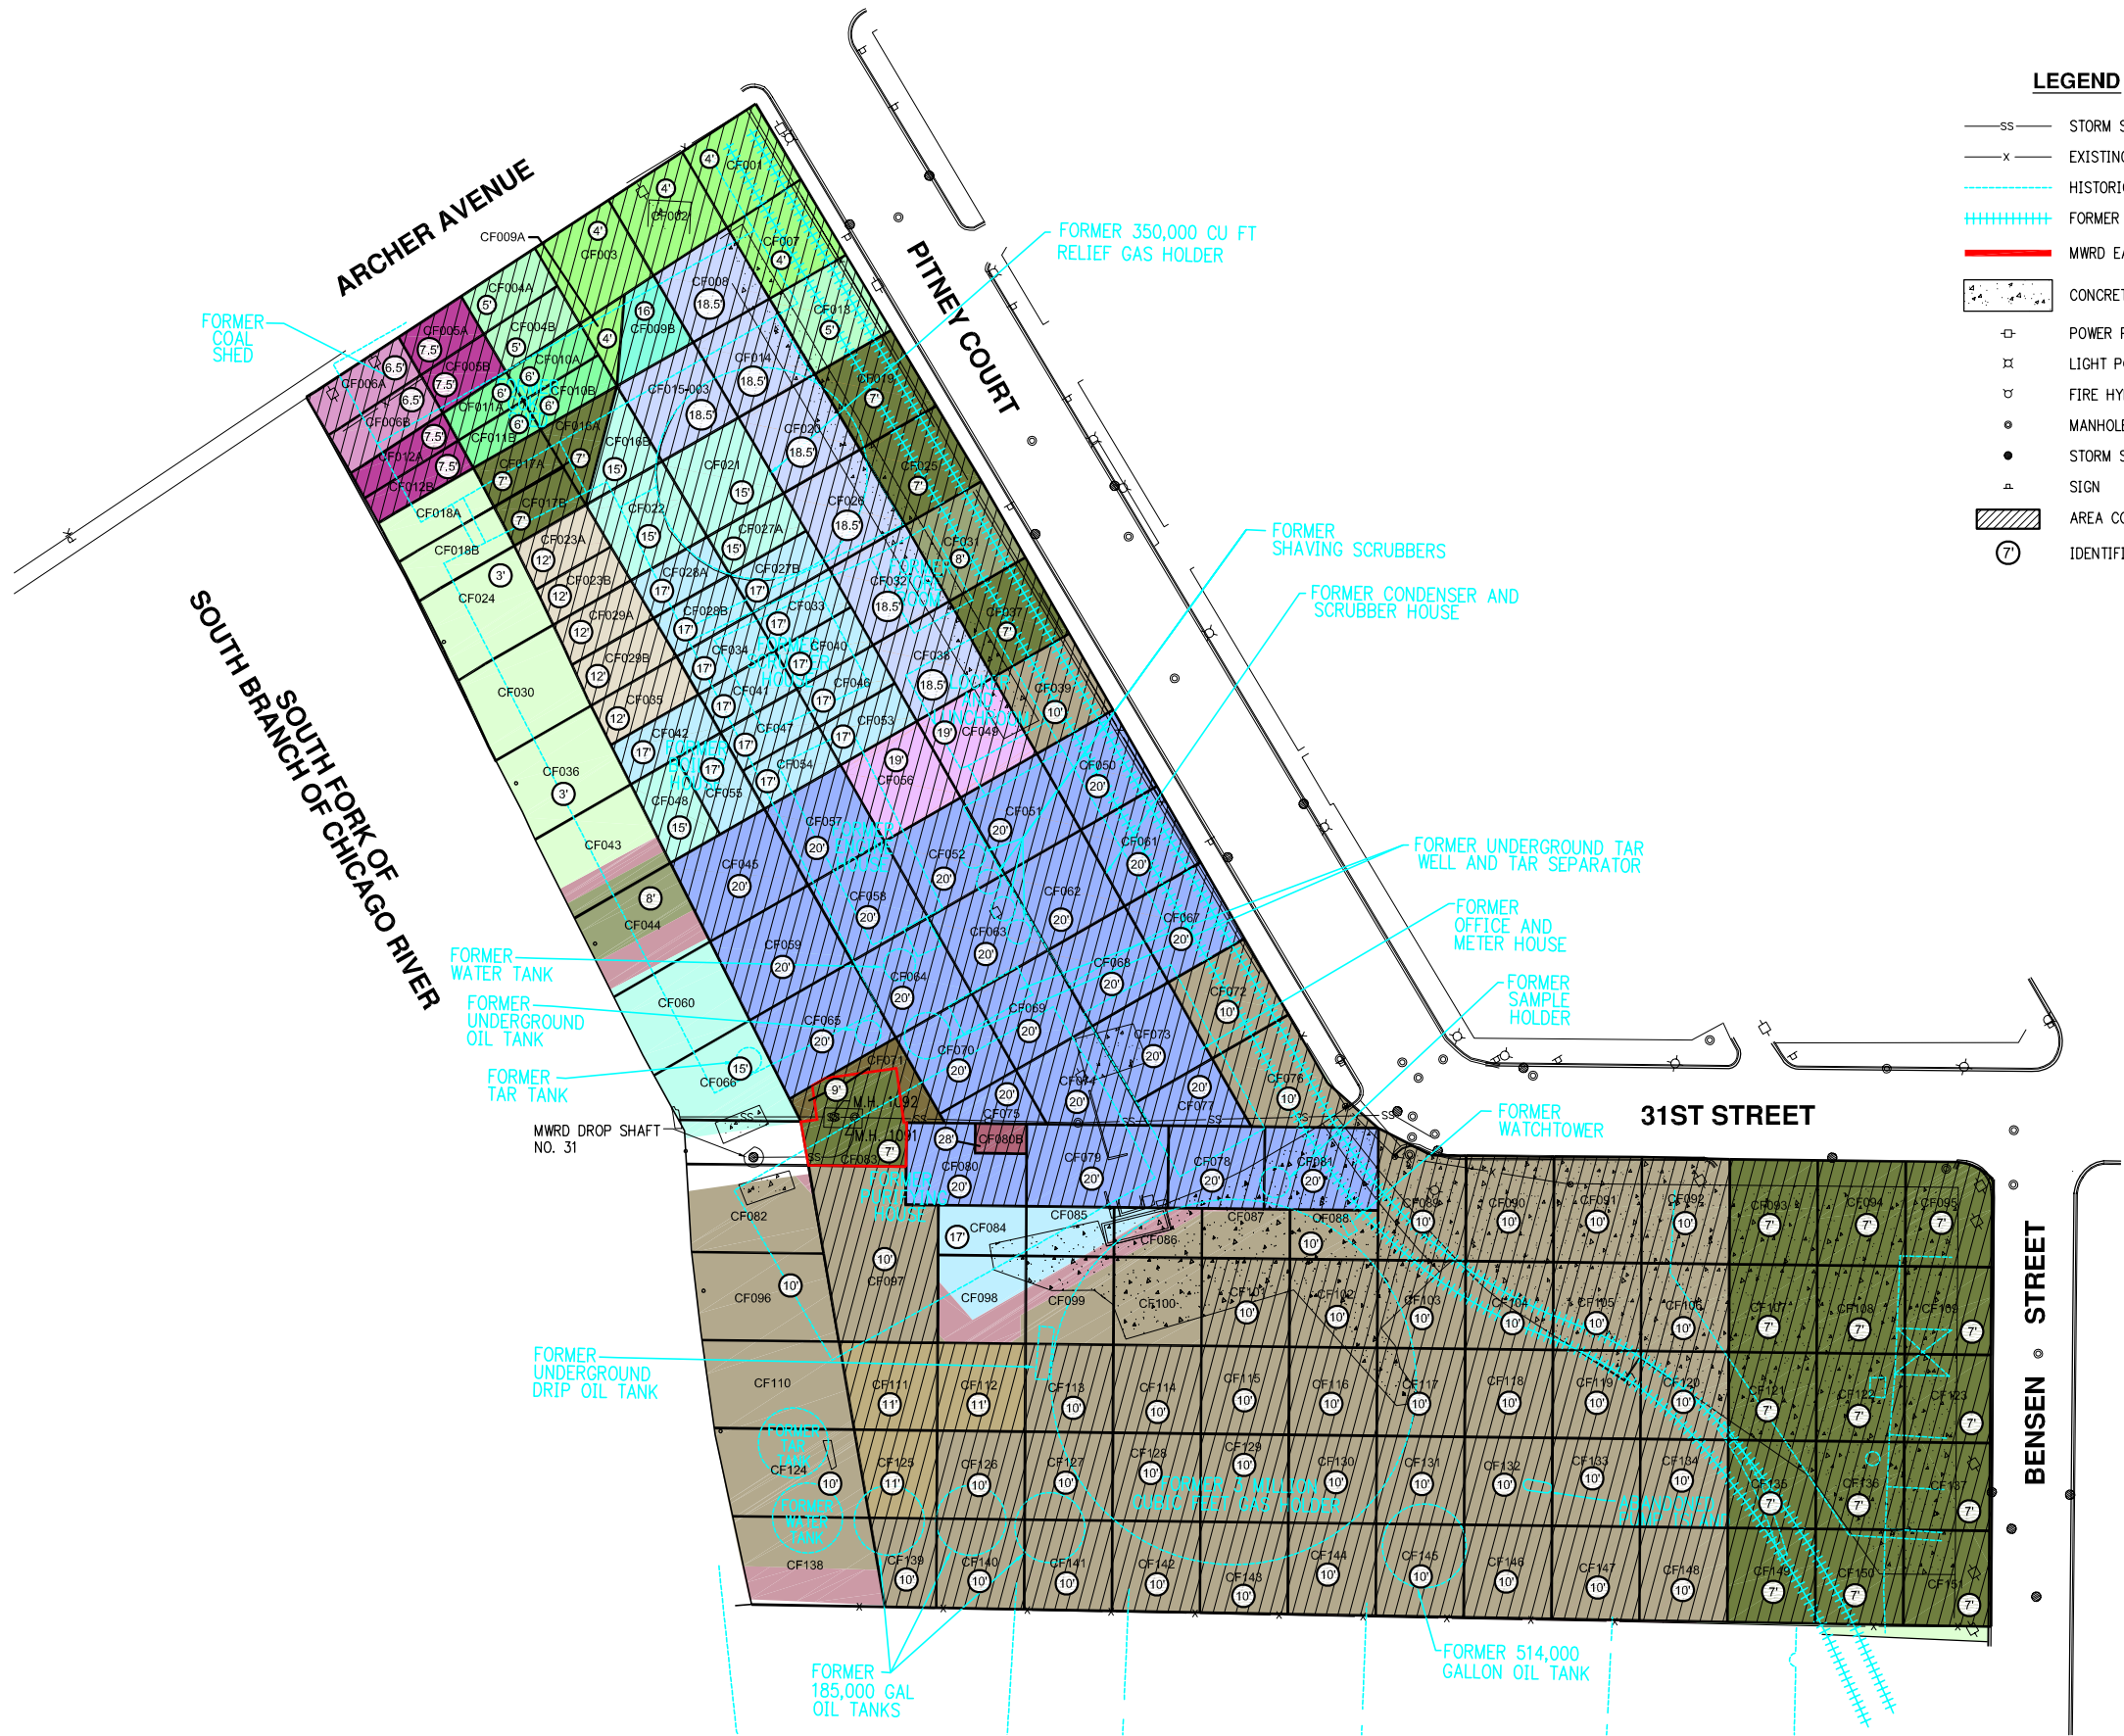

LEGEND

- SS STORM SEWER
- X EXISTING FENCE
- HISTORICAL FEATURES/FORMER STRUCTURES
- ===== FORMER RAILROAD TRACKS
- MWRD EASEMENT
- CONCRETE
- POWER POLE
- LIGHT POLE
- FIRE HYDRANT
- MANHOLE
- STORM SEWER/CATCH BASIN
- SIGN
- AREA COMPLETED
- IDENTIFIED DEPTH OF EXCAVATION



40 0 40 80  
SCALE IN FEET

DRAFT

OCTOBER 13, 2007



date	10-13-07	detailed	J. PEREZ
designed	A. HANRAHAN	checked	

THE PEOPLES GAS LIGHT  
AND COKE COMPANY  
CHICAGO, ILLINOIS

PITNEY COURT  
3052 SOUTH PITNEY COURT  
CHICAGO, ILLINOIS


Figure 1  
AS-BUILT EXCAVATION LAYOUT MAP  
PITNEY COURT  
CHICAGO, ILLINOIS

project	27112	contract	
drawing		rev.	

sheet 1 of 1 sheets


file \\PEOPLES GAS\PITNEY COURT\JAG\BENKOR\IN PROGRESS\007-10-13\PITNEY COURT EXCAVATION



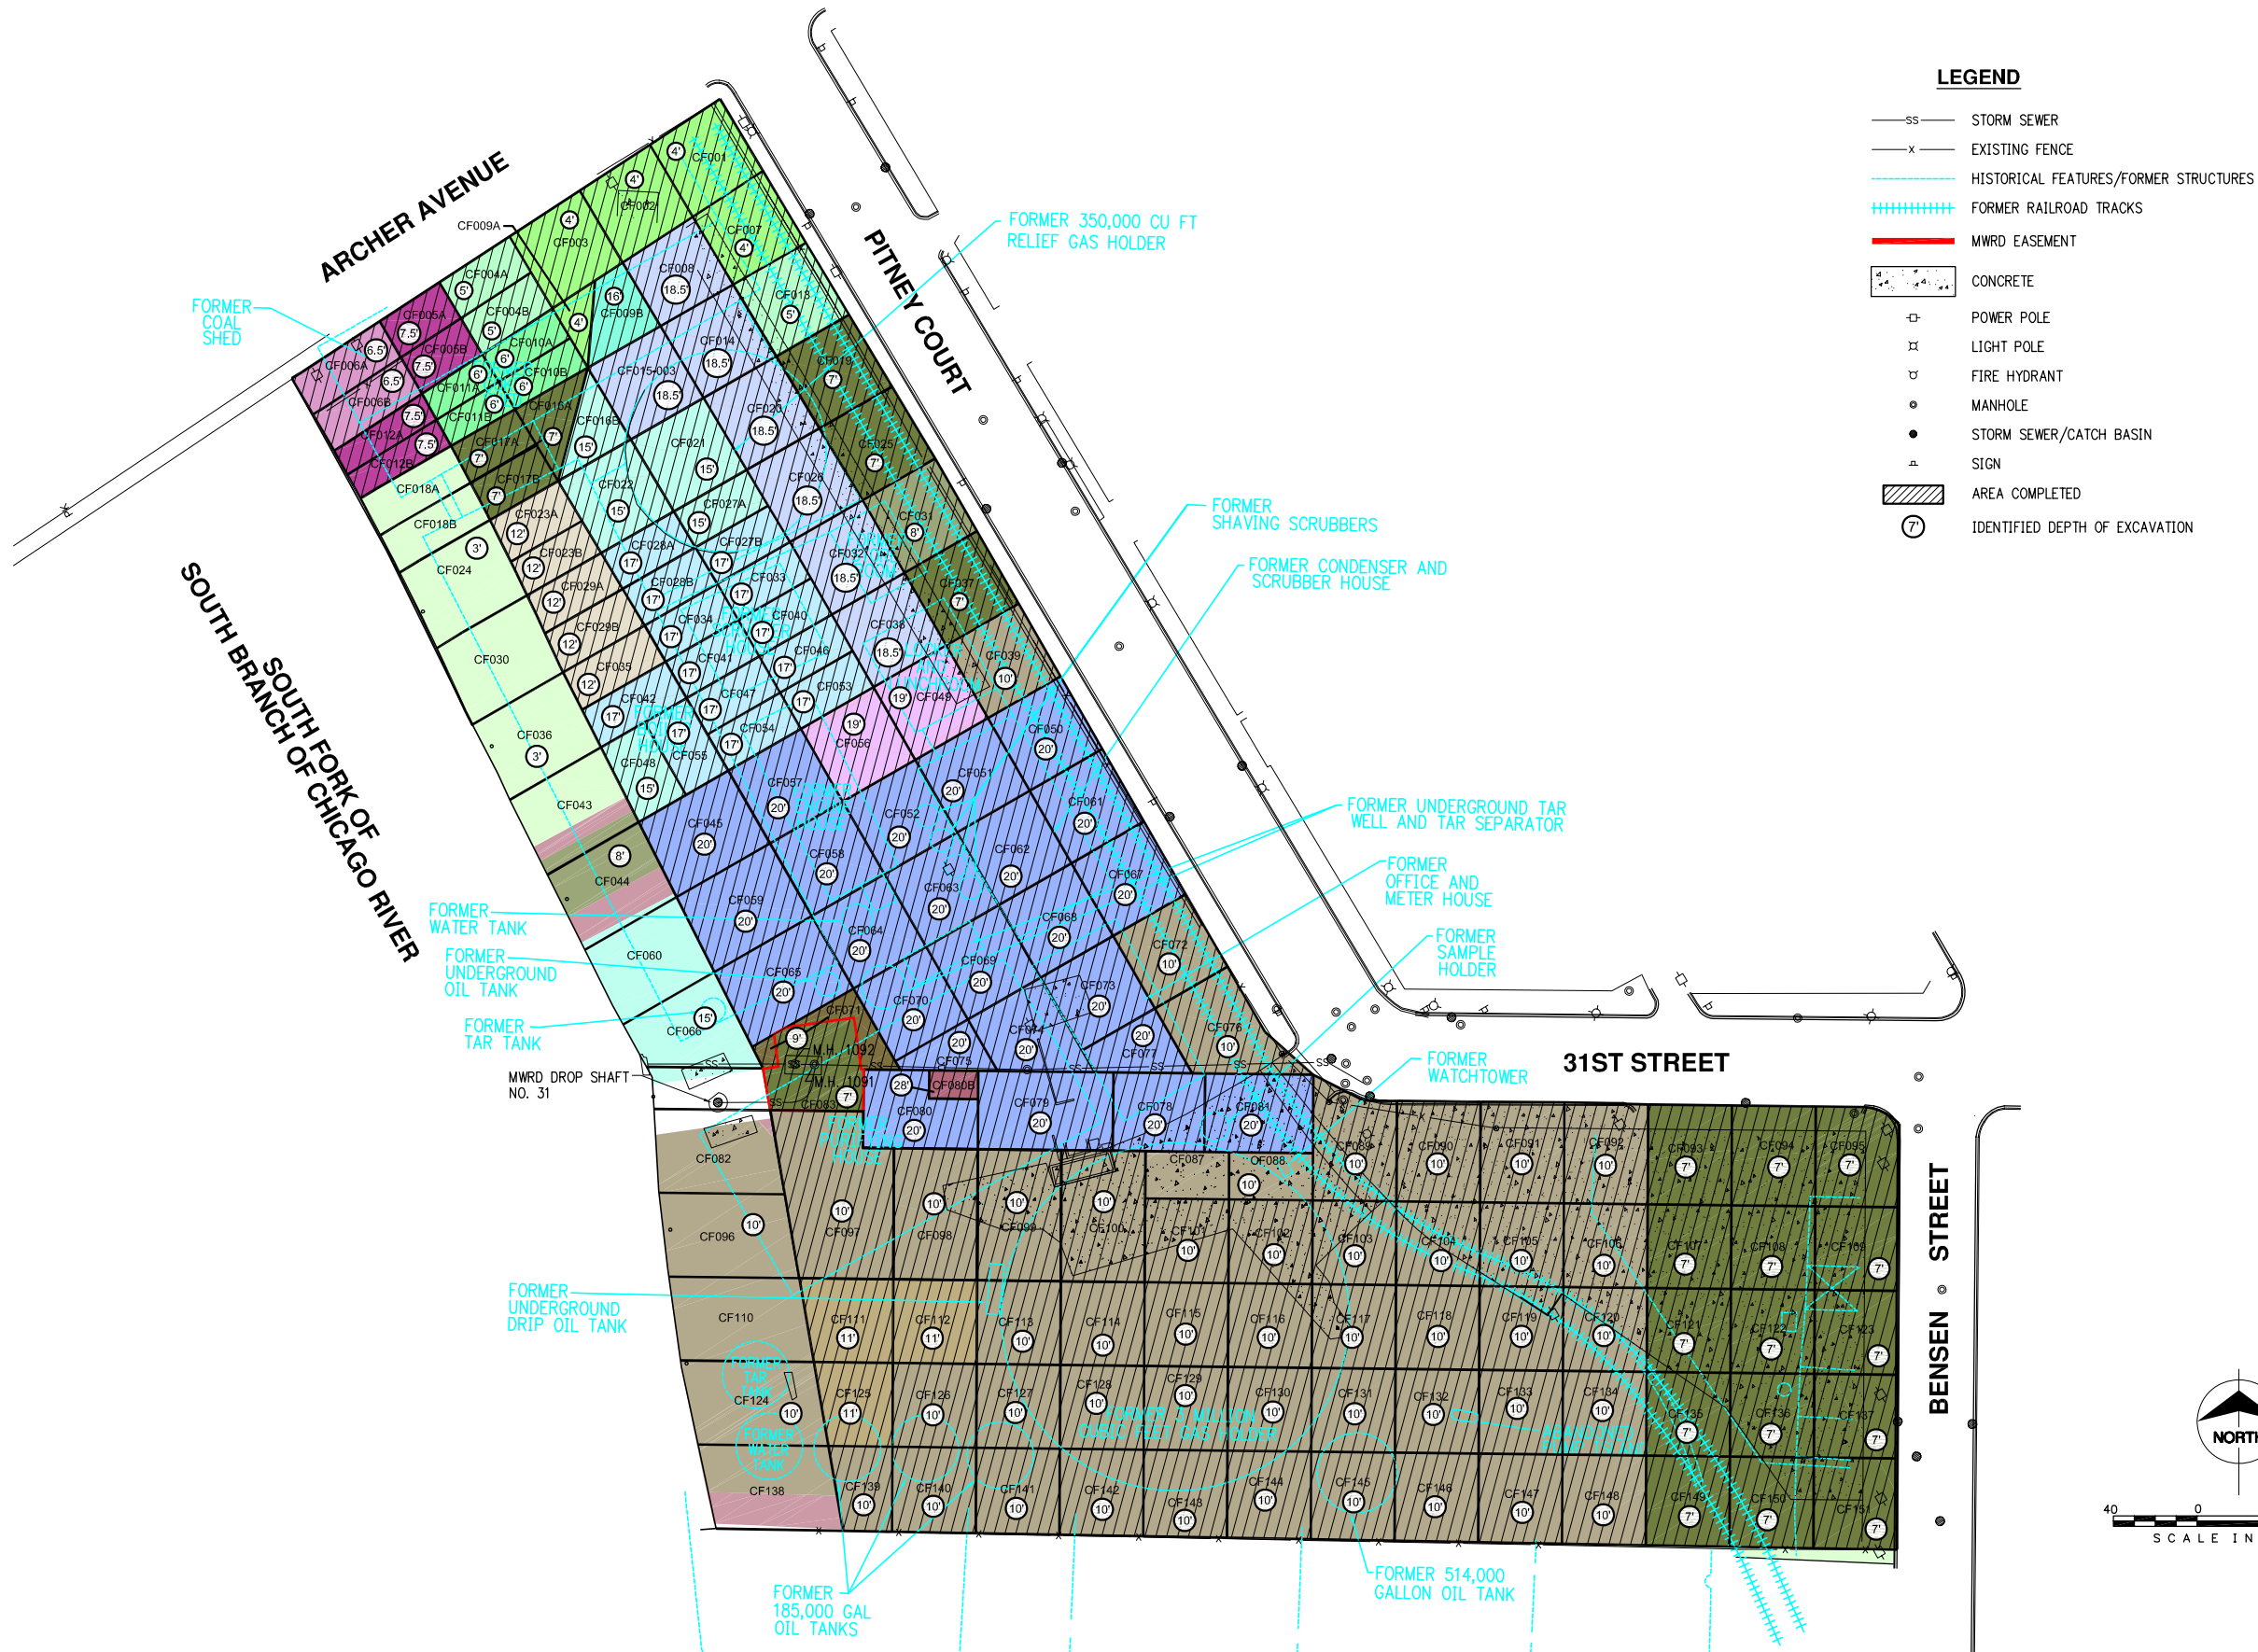


DRAFT

OCTOBER 20, 2007

	
date 10-20-07	detailed J. PEREZ
designed A. HANRAHAN	checked
THE PEOPLES GAS LIGHT AND COKE COMPANY CHICAGO, ILLINOIS	
PITNEY COURT 3052 SOUTH PITNEY COURT CHICAGO, ILLINOIS	
Figure 1 AS-BUILT EXCAVATION LAYOUT MAP PITNEY COURT CHICAGO, ILLINOIS	
project 27112	contract
drawing	rev.
sheet 1 of 1 sheets	
file \\PEOPLES GAS\PITNEY COURT\JAG\BENKOR\IN PROGRESS\2007-10-20\PITNEY COURT EXCAVATION	



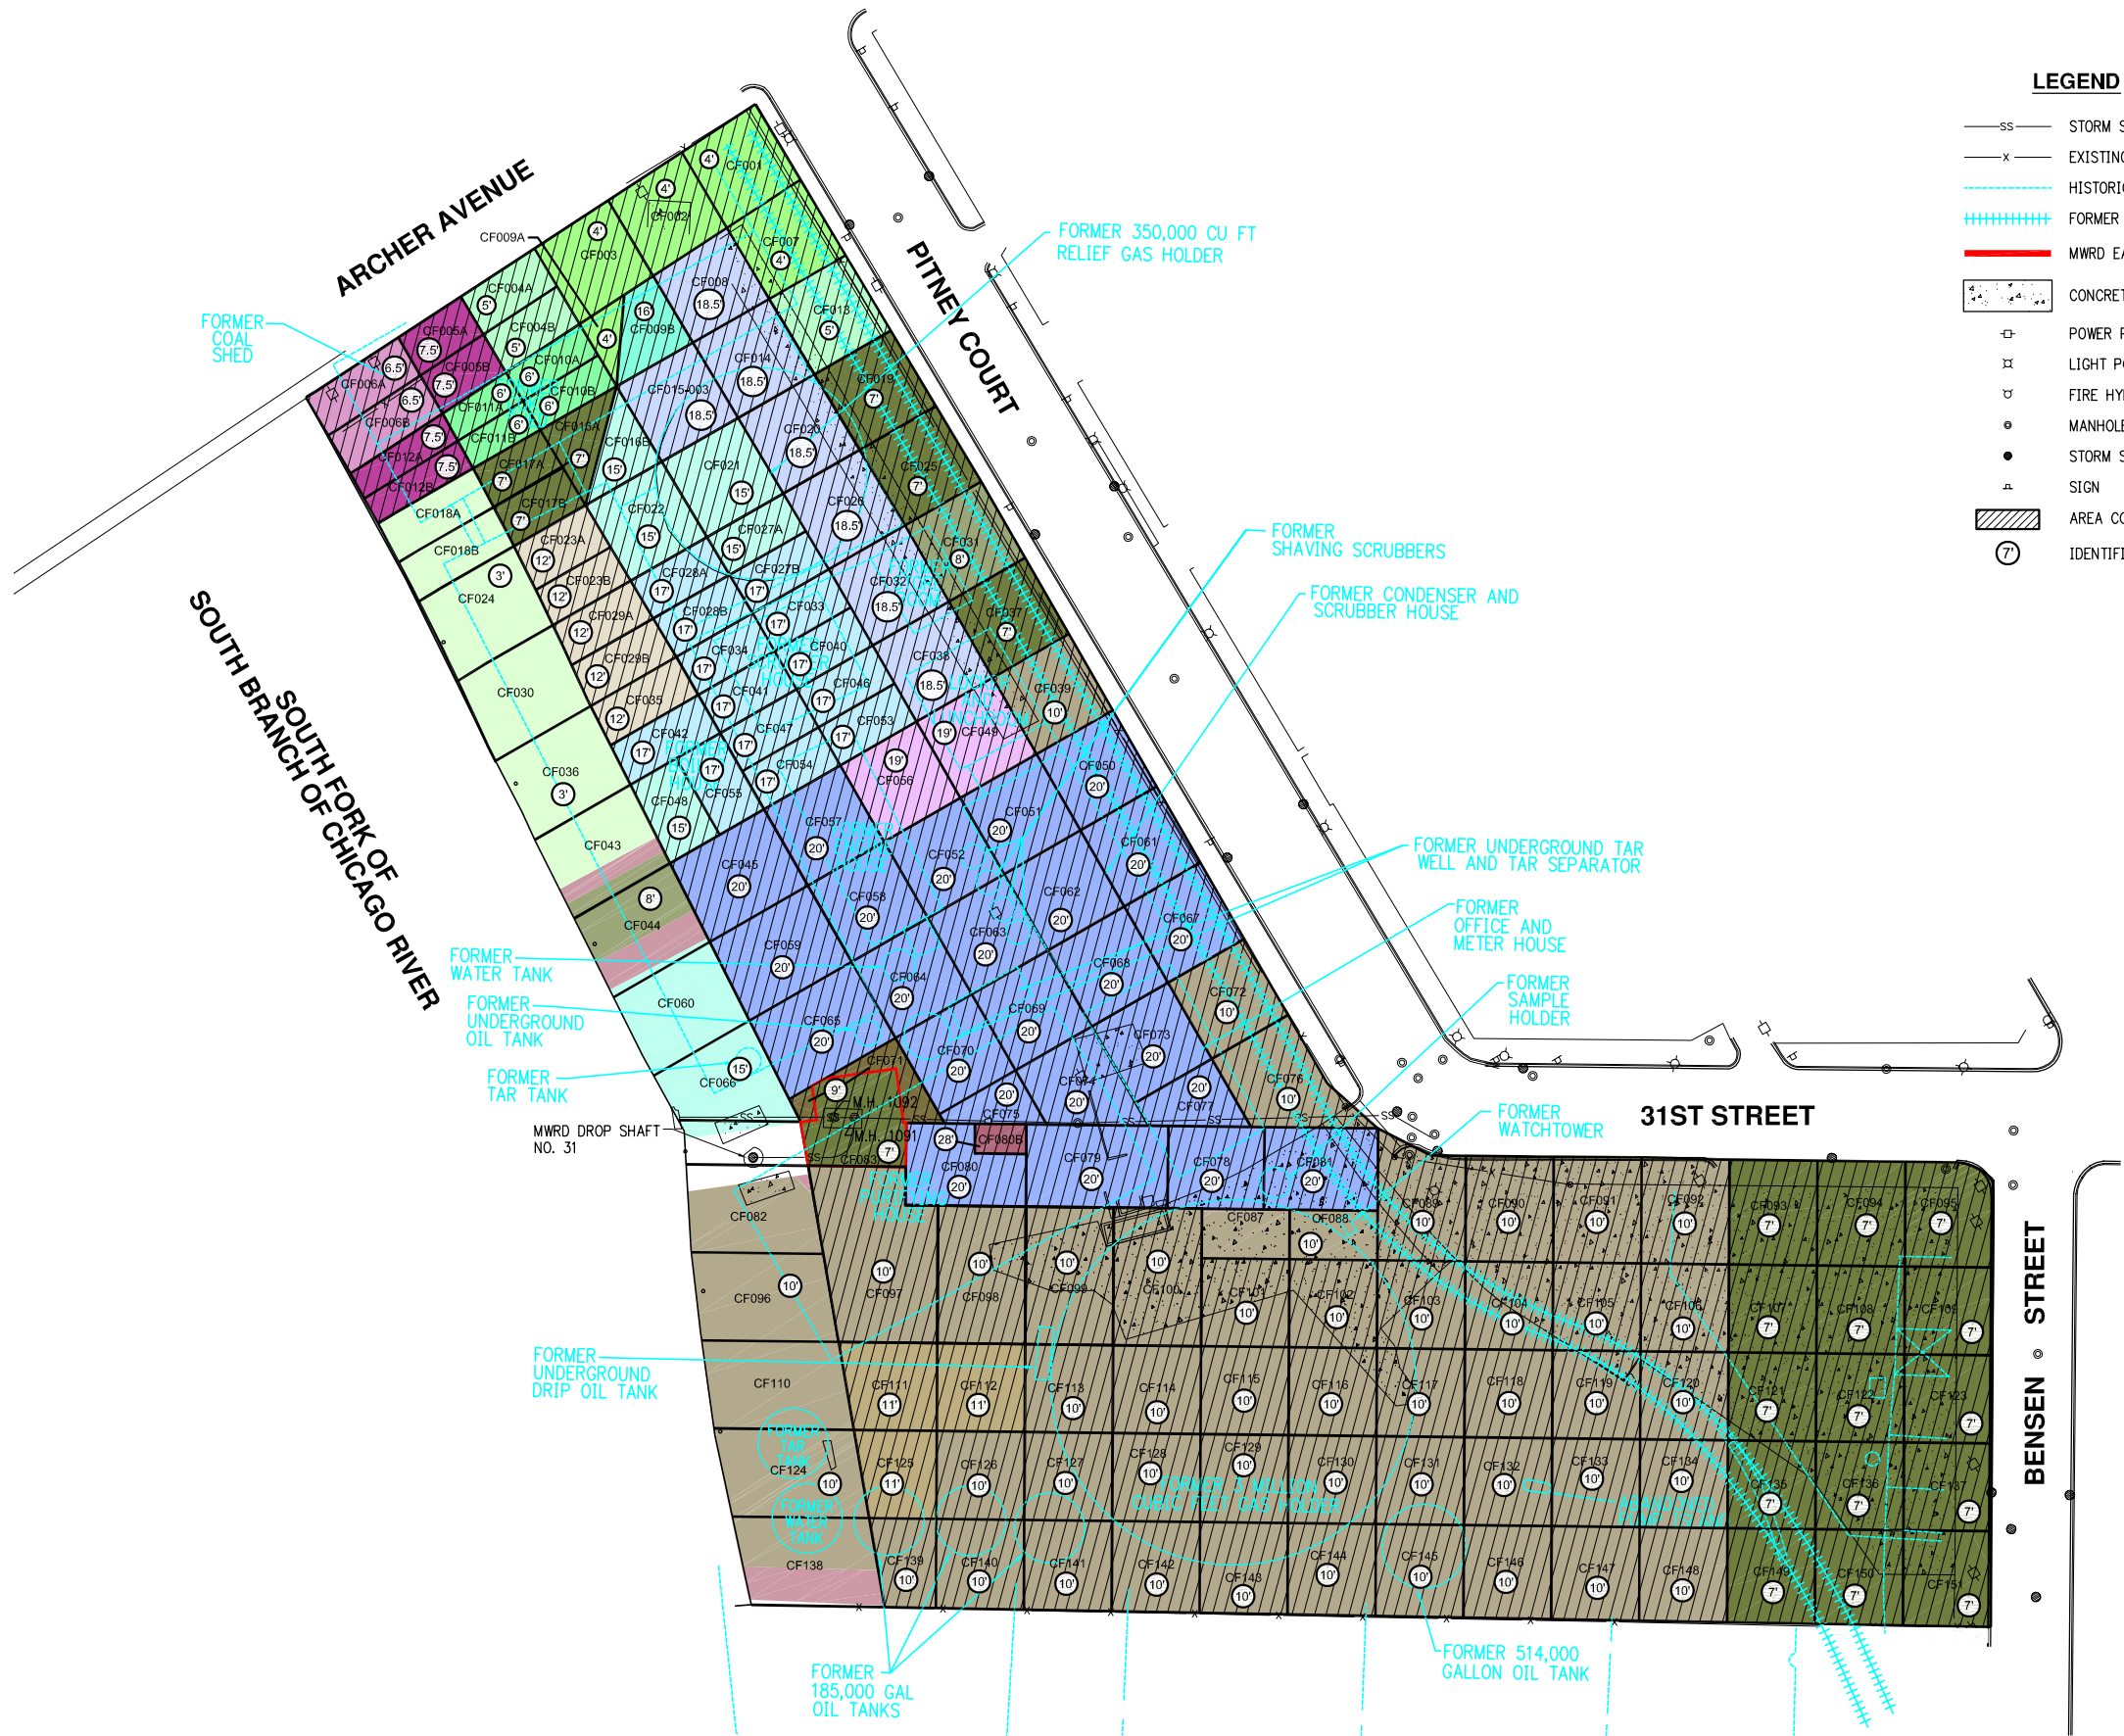

LEGEND

- SS STORM SEWER
- X EXISTING FENCE
- HISTORICAL FEATURES/FORMER STRUCTURES
- FORMER RAILROAD TRACKS
- MWRD EASEMENT
- CONCRETE
- POWER POLE
- LIGHT POLE
- FIRE HYDRANT
- MANHOLE
- STORM SEWER/CATCH BASIN
- SIGN
- AREA COMPLETED
- IDENTIFIED DEPTH OF EXCAVATION



40 0 40 80  
SCALE IN FEET

DRAFT

OCTOBER 27, 2007



date	10-27-07	detailed	J. PEREZ
designed	A. HANRAHAN	checked	

THE PEOPLES GAS LIGHT  
AND COKE COMPANY  
CHICAGO, ILLINOIS

PITNEY COURT  
3052 SOUTH PITNEY COURT  
CHICAGO, ILLINOIS

Figure 1  
AS-BUILT EXCAVATION LAYOUT MAP  
PITNEY COURT  
CHICAGO, ILLINOIS


project	27112	contract	
---------	-------	----------	--

drawing		rev.	
---------	--	------	--

sheet	1	of	1	sheets
-------	---	----	---	--------

file: E:\PEOPLES GAS\PITNEY COURT\_CAD\BROWIN IN PROGRESS\2007-10-27\PITNEY COURT EXCAVATION



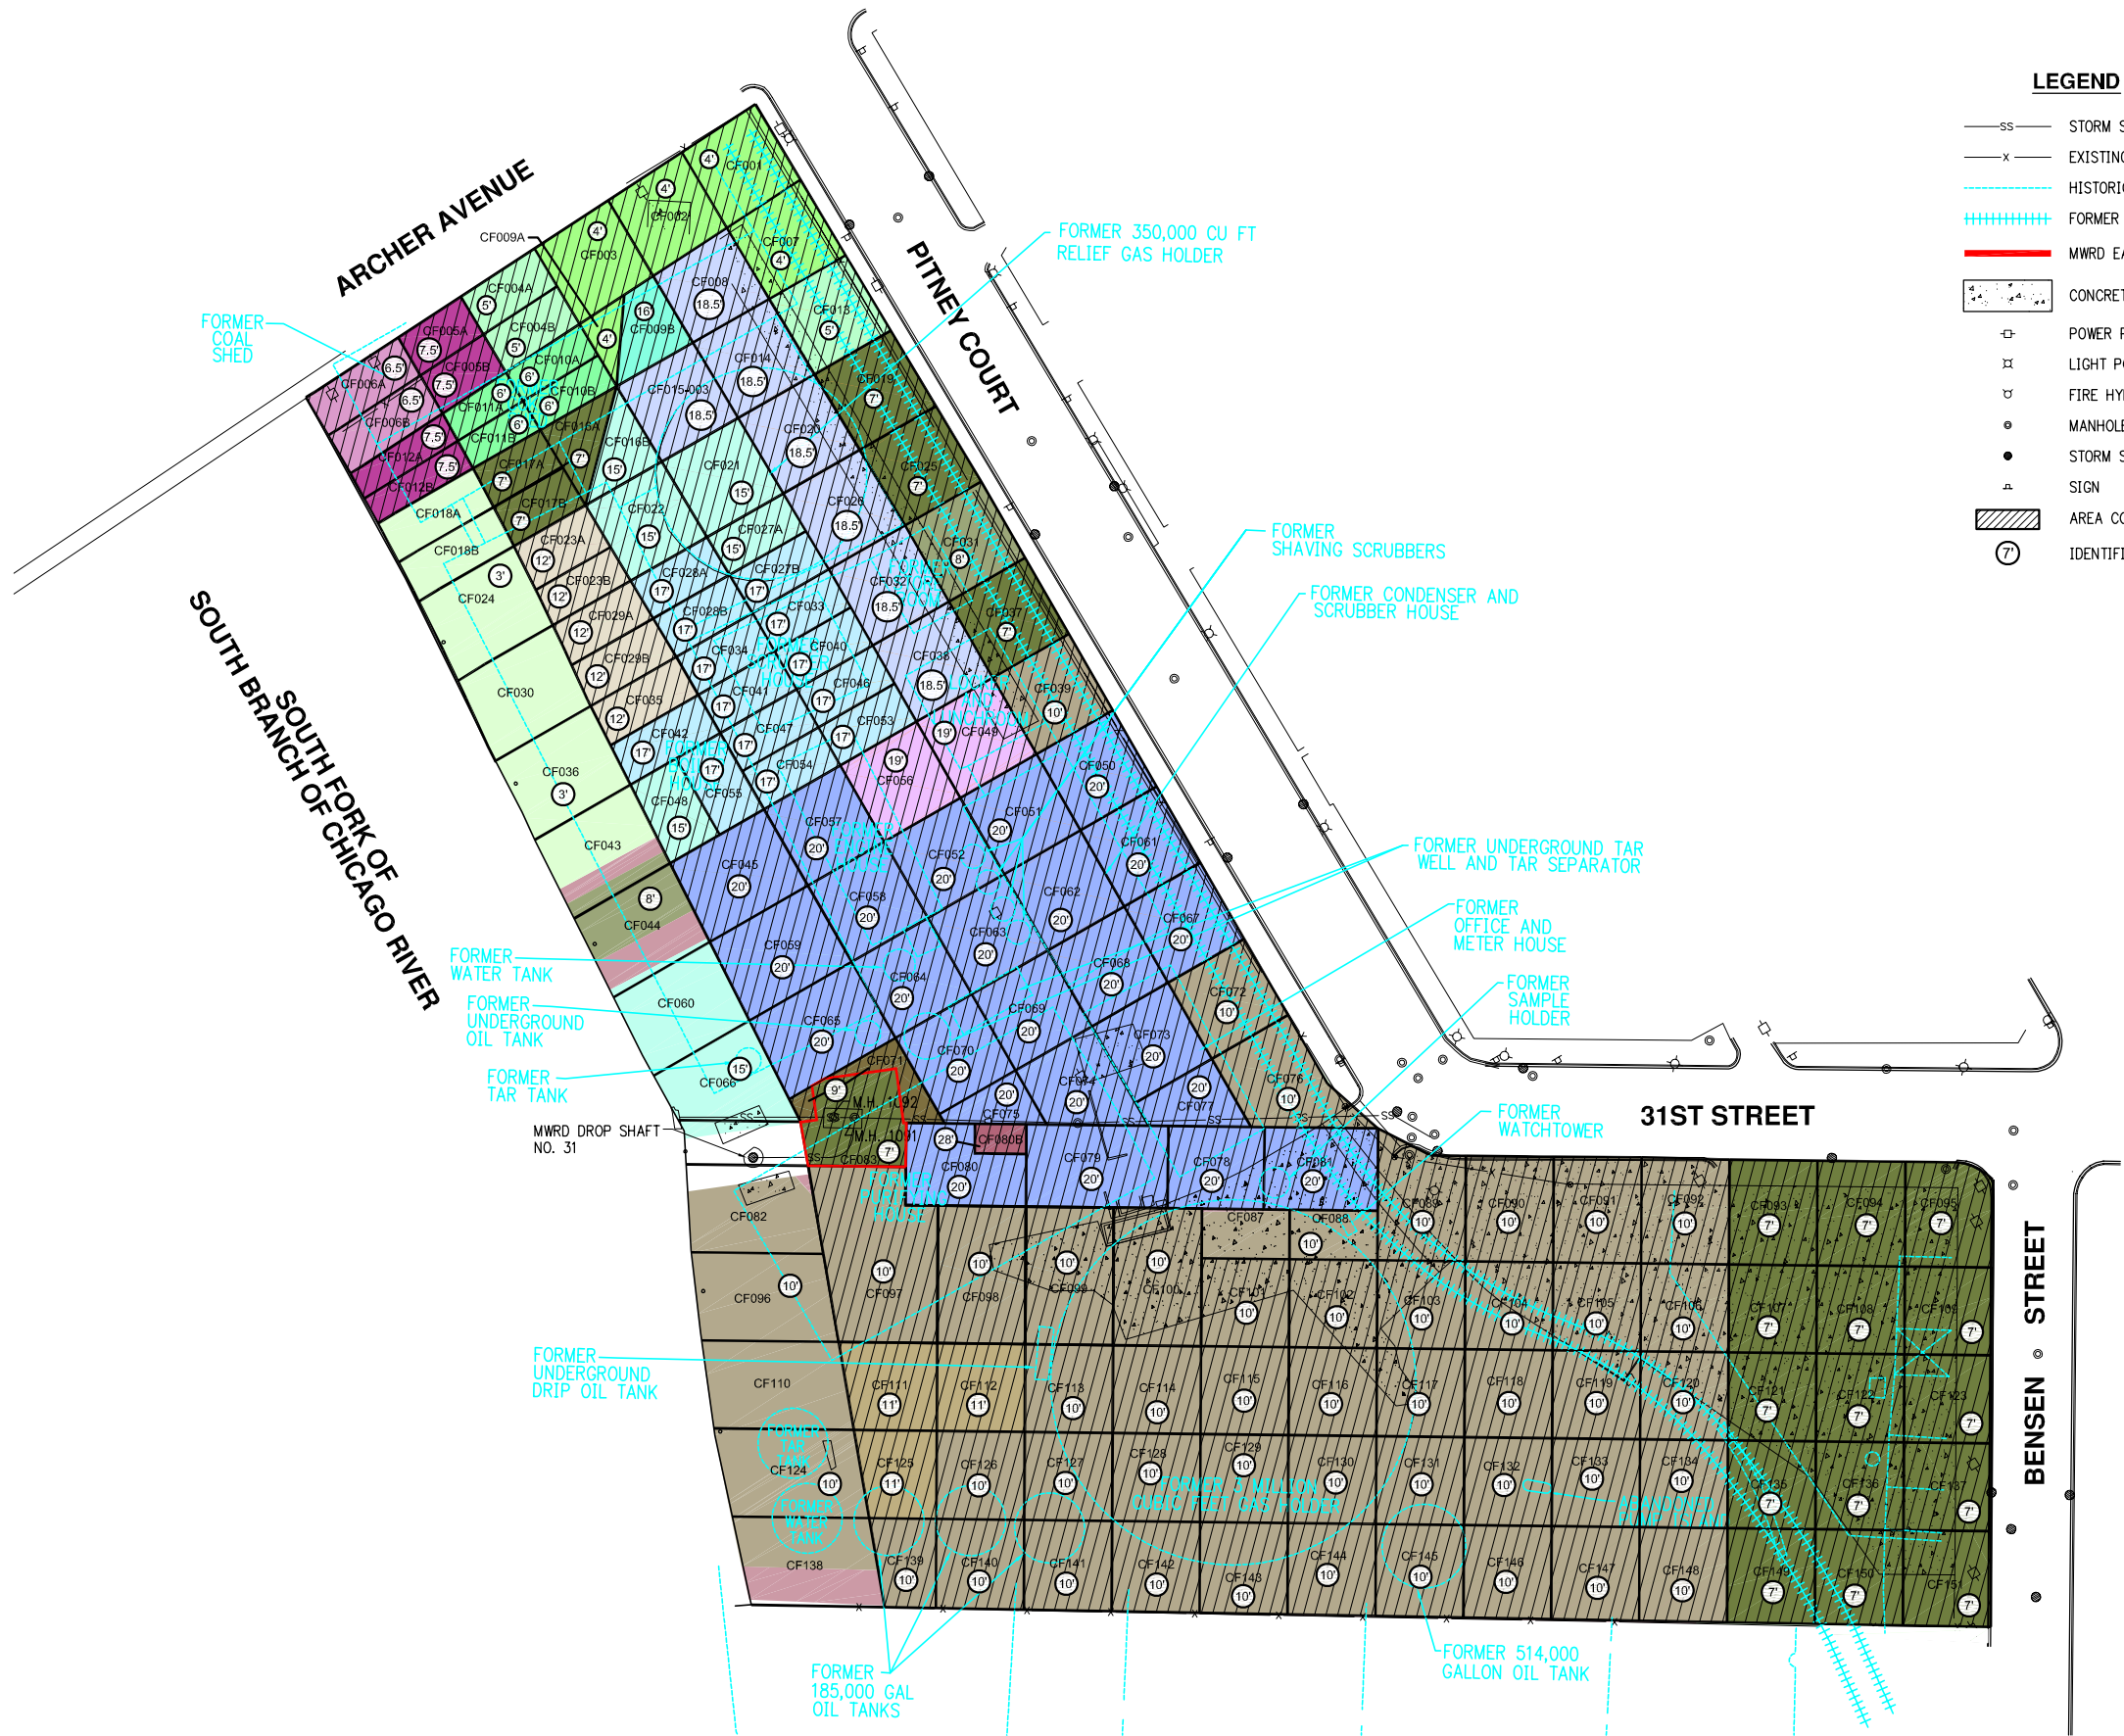

LEGEND

- SS STORM SEWER
- X EXISTING FENCE
- HISTORICAL FEATURES/FORMER STRUCTURES
- ===== FORMER RAILROAD TRACKS
- MWRD EASEMENT
- CONCRETE
- POWER POLE
- LIGHT POLE
- FIRE HYDRANT
- MANHOLE
- STORM SEWER/CATCH BASIN
- SIGN
- AREA COMPLETED
- IDENTIFIED DEPTH OF EXCAVATION



40 0 40 80  
SCALE IN FEET

DRAFT

NOVEMBER 03, 2007



date	11-03-07	detailed	J. PEREZ
designed	A. HANRAHAN	checked	

THE PEOPLES GAS LIGHT  
AND COKE COMPANY  
CHICAGO, ILLINOIS

PITNEY COURT  
3052 SOUTH PITNEY COURT  
CHICAGO, ILLINOIS


Figure 1  
AS-BUILT EXCAVATION LAYOUT MAP  
PITNEY COURT  
CHICAGO, ILLINOIS

project	27112	contract	
drawing		rev.	

sheet 1 of 1 sheets

file:PEOPLES GAS/PITNEY COURT\_CAD/BUILDING IN PROGRESS/2007-11-03/PITNEY COURT EXCAVATION



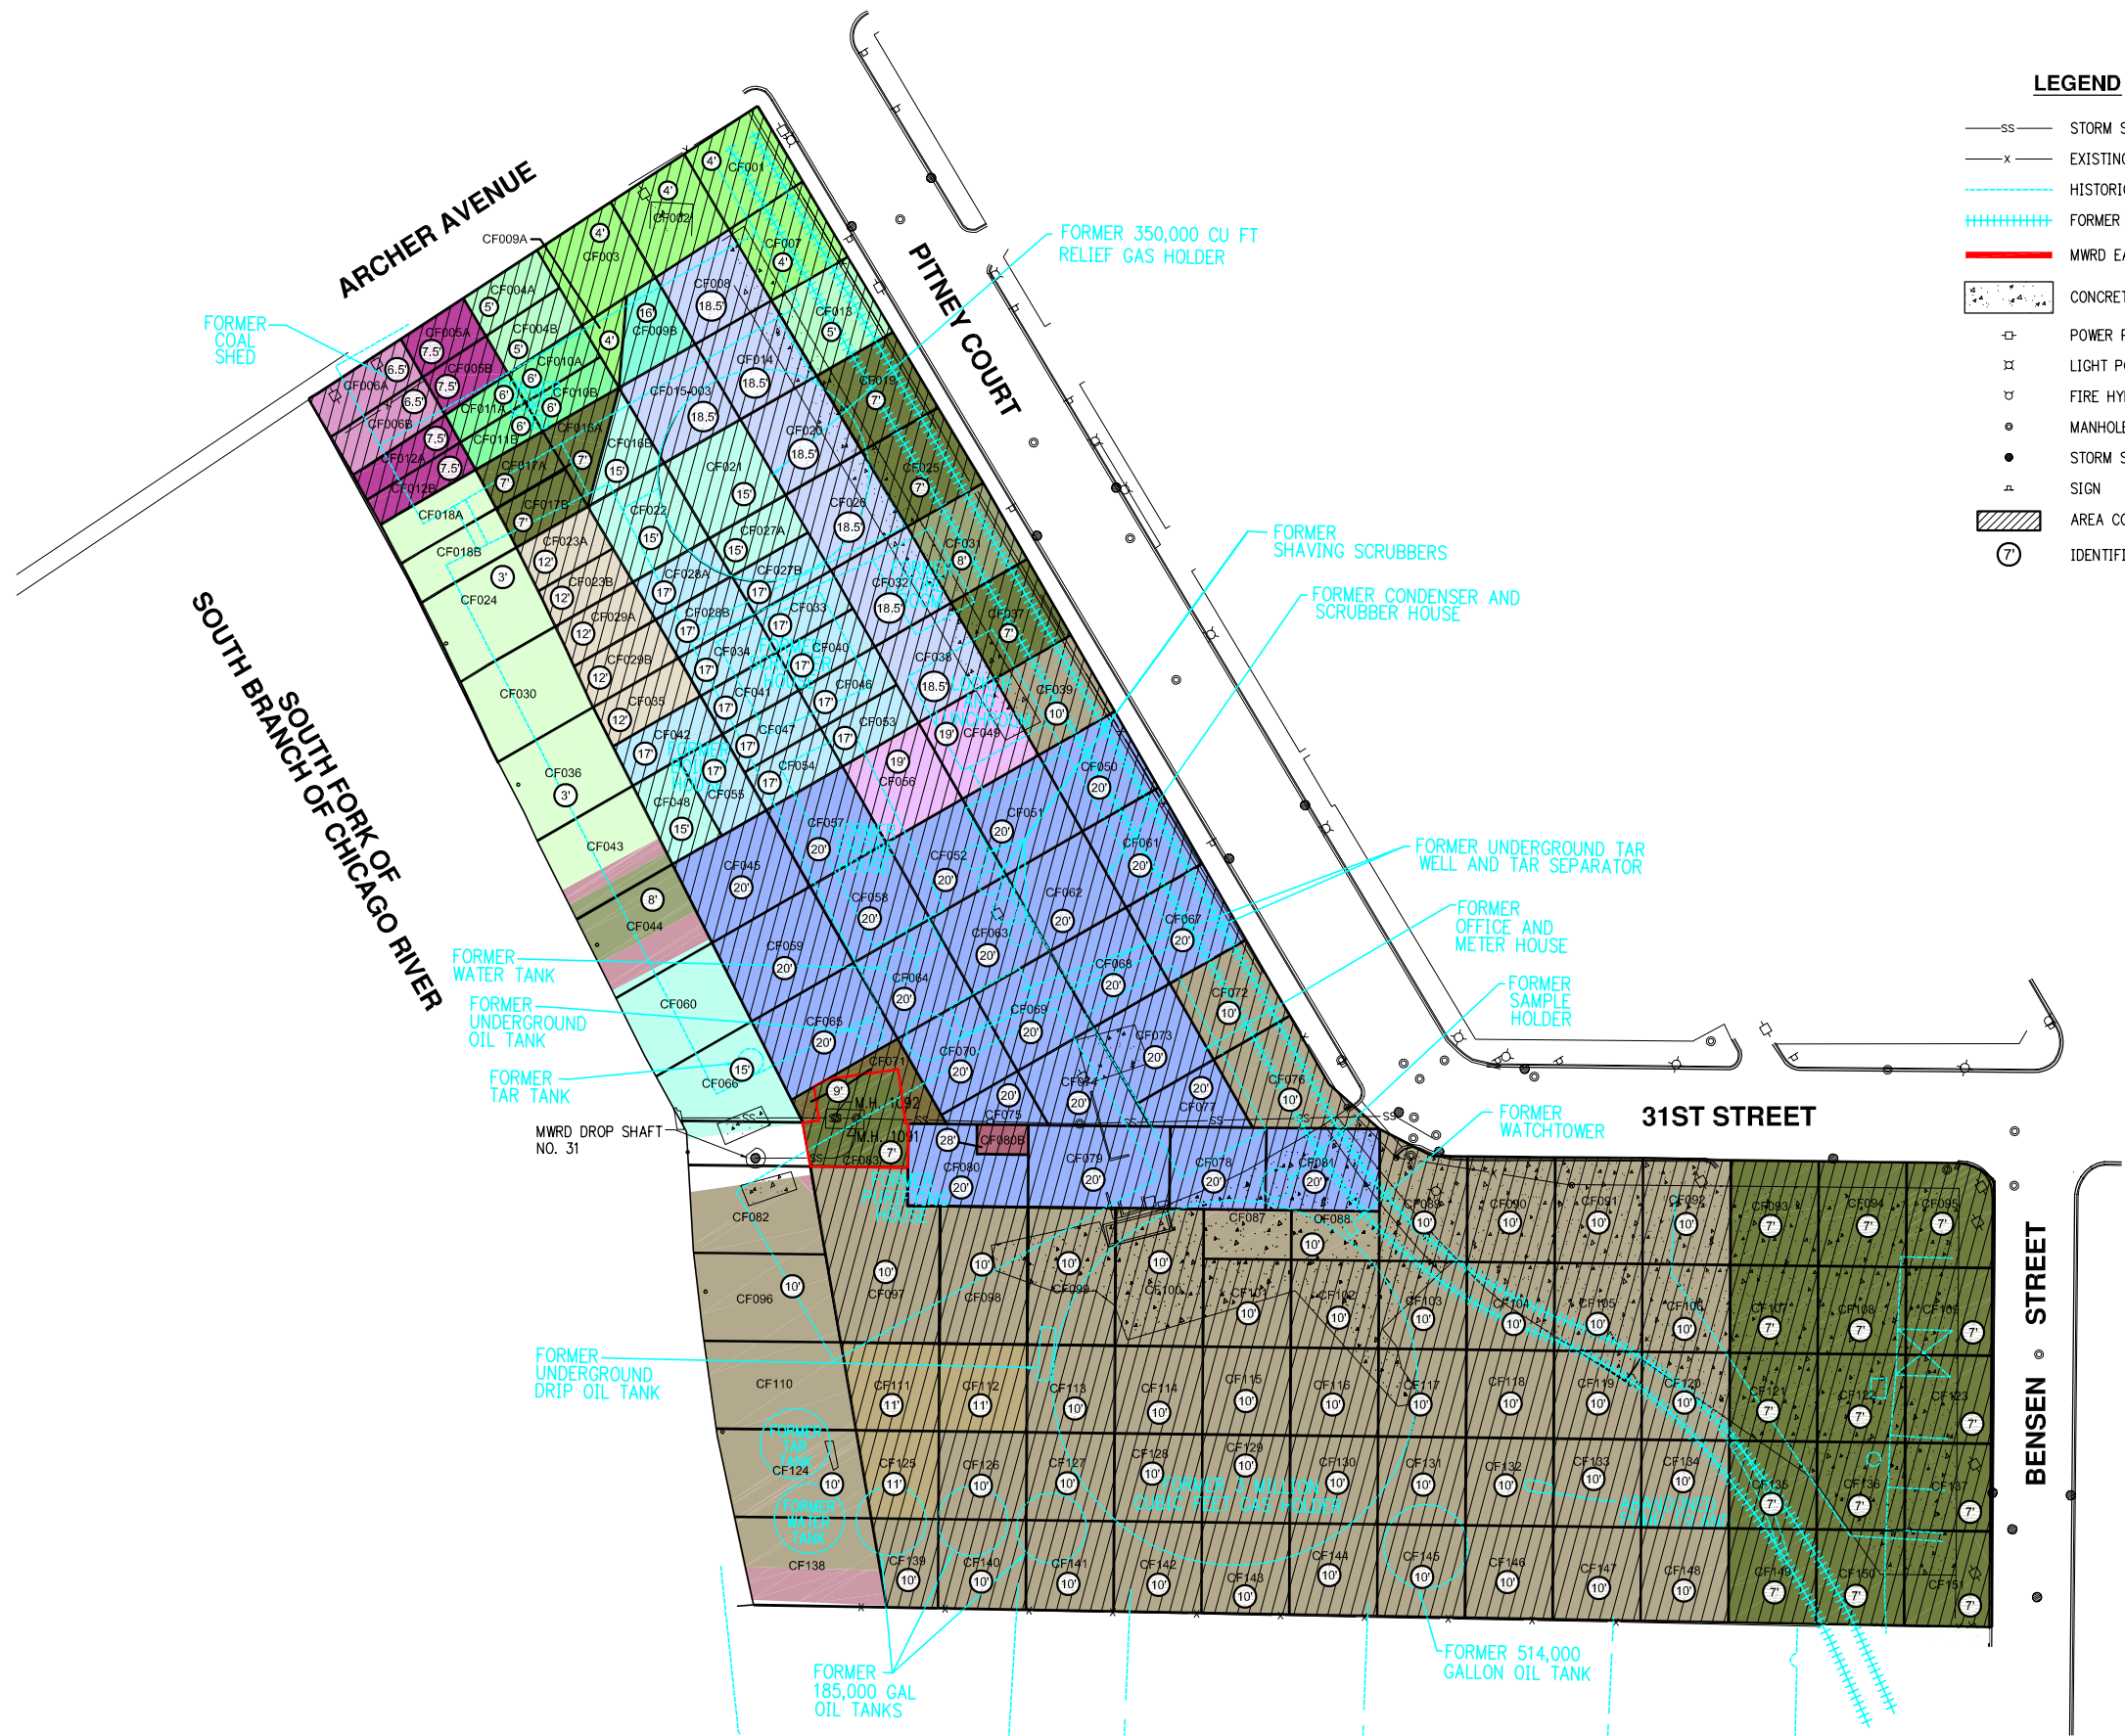

LEGEND

- SS STORM SEWER
- X EXISTING FENCE
- HISTORICAL FEATURES/FORMER STRUCTURES
- ===== FORMER RAILROAD TRACKS
- MWRD EASEMENT
- CONCRETE
- POWER POLE
- LIGHT POLE
- FIRE HYDRANT
- MANHOLE
- STORM SEWER/CATCH BASIN
- SIGN
- AREA COMPLETED
- IDENTIFIED DEPTH OF EXCAVATION



40 0 40 80  
SCALE IN FEET

DRAFT

NOVEMBER 10, 2007




date	11-10-07	detailed	J. PEREZ
designed	A. HANRAHAN	checked	

THE PEOPLES GAS LIGHT  
AND COKE COMPANY  
CHICAGO, ILLINOIS

PITNEY COURT  
3052 SOUTH PITNEY COURT  
CHICAGO, ILLINOIS

Figure 1 AS-BUILT EXCAVATION LAYOUT MAP PITNEY COURT CHICAGO, ILLINOIS			
project	27112	contract	
drawing		rev.	
sheet	1	of	1
file:PEOPLES GAS/PITNEY COURT_CAD/BENSON IN PROGRESS/2007-11-10/PITNEY COURT EXCAVATION			



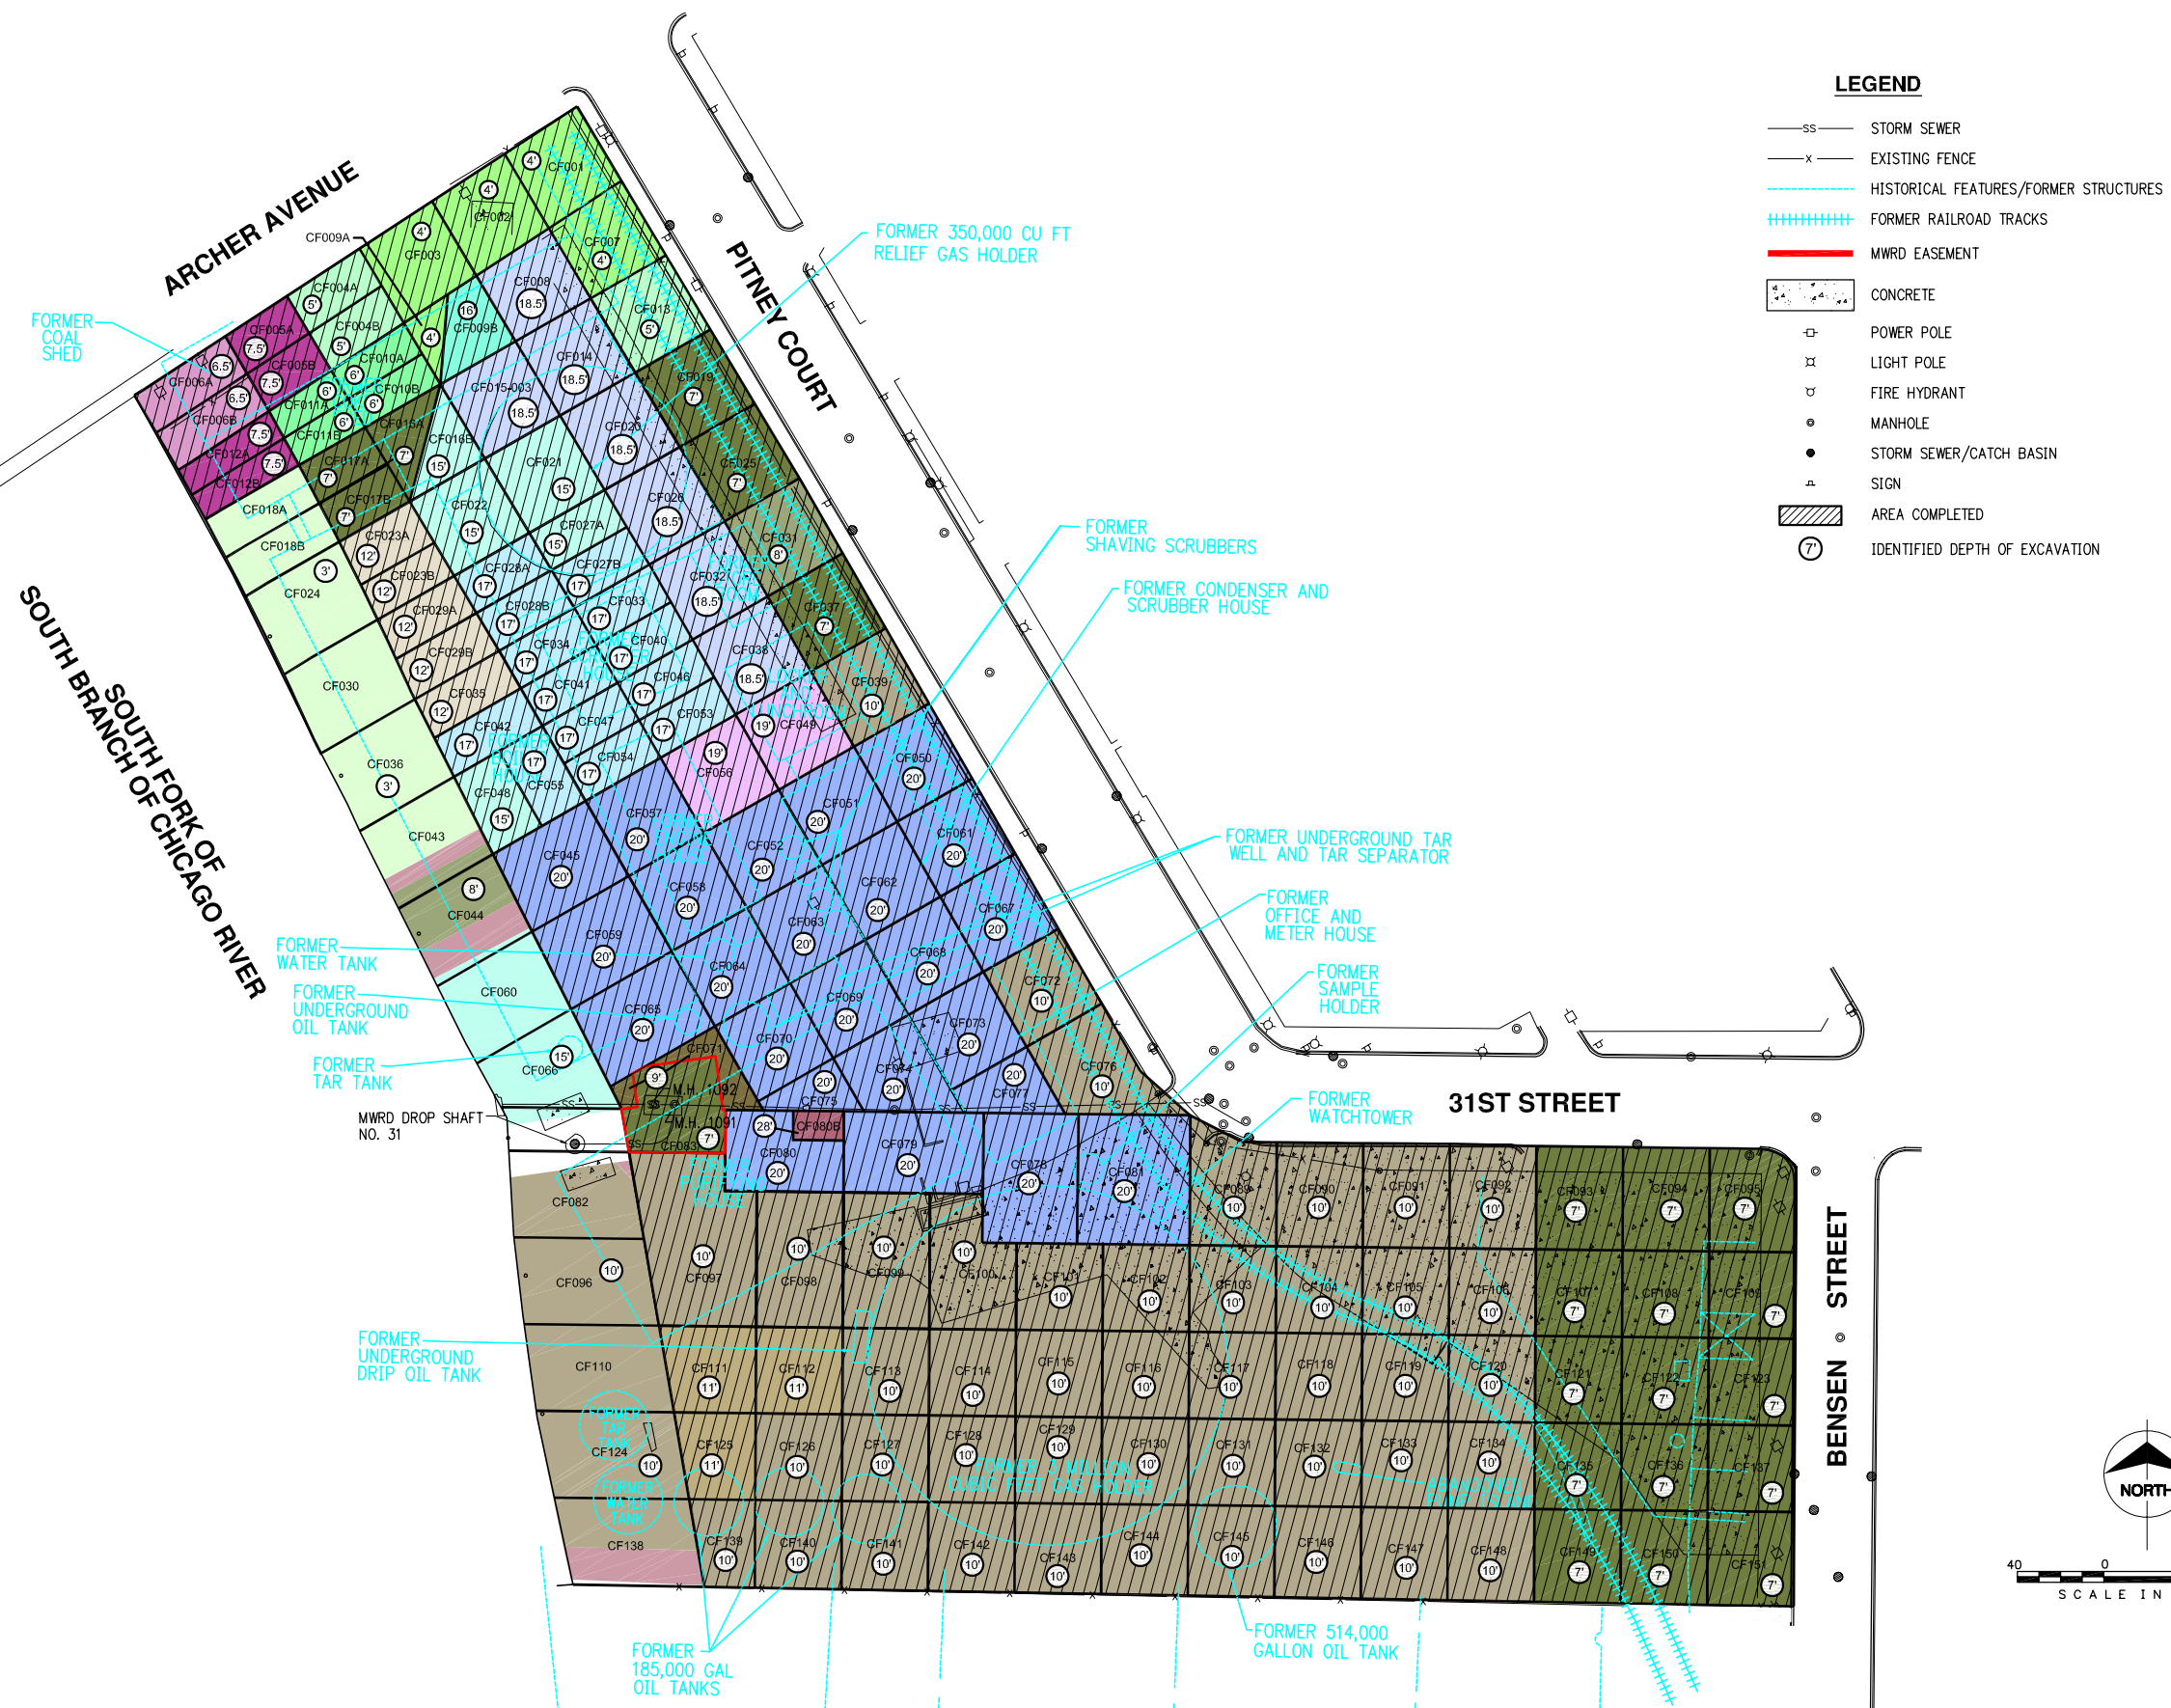

**DRAFT**

**NOVEMBER 17, 2007**

no.	date	by	ckd	description
-----	------	----	-----	-------------



date 11-17-07	detailed J. PEREZ
designed A. HANRAHAN	checked

THE PEOPLES GAS LIGHT  
AND COKE COMPANY  
CHICAGO, ILLINOIS

PITNEY COURT  
3052 SOUTH PITNEY COURT  
CHICAGO, ILLINOIS


<p align="center"><b>Figure 1</b></p> <p align="center"><b>AS-BUILT EXCAVATION LAYOUT MAP</b></p> <p align="center"><b>PITNEY COURT</b></p> <p align="center"><b>CHICAGO, ILLINOIS</b></p>			
project		contract	
27112			
drawing		rev.	
		<p align="center"><b>1</b></p>	
sheet	1	of	1
		sheets	
<p><b>file</b> E:\PEOPLES GAS\PITNEY COURT_ICAD\BID\WORK IN PROGRESS\2007-11-17 PITNEY COURT EXCAVATION</p>			





no.		date		by		ckd		description	



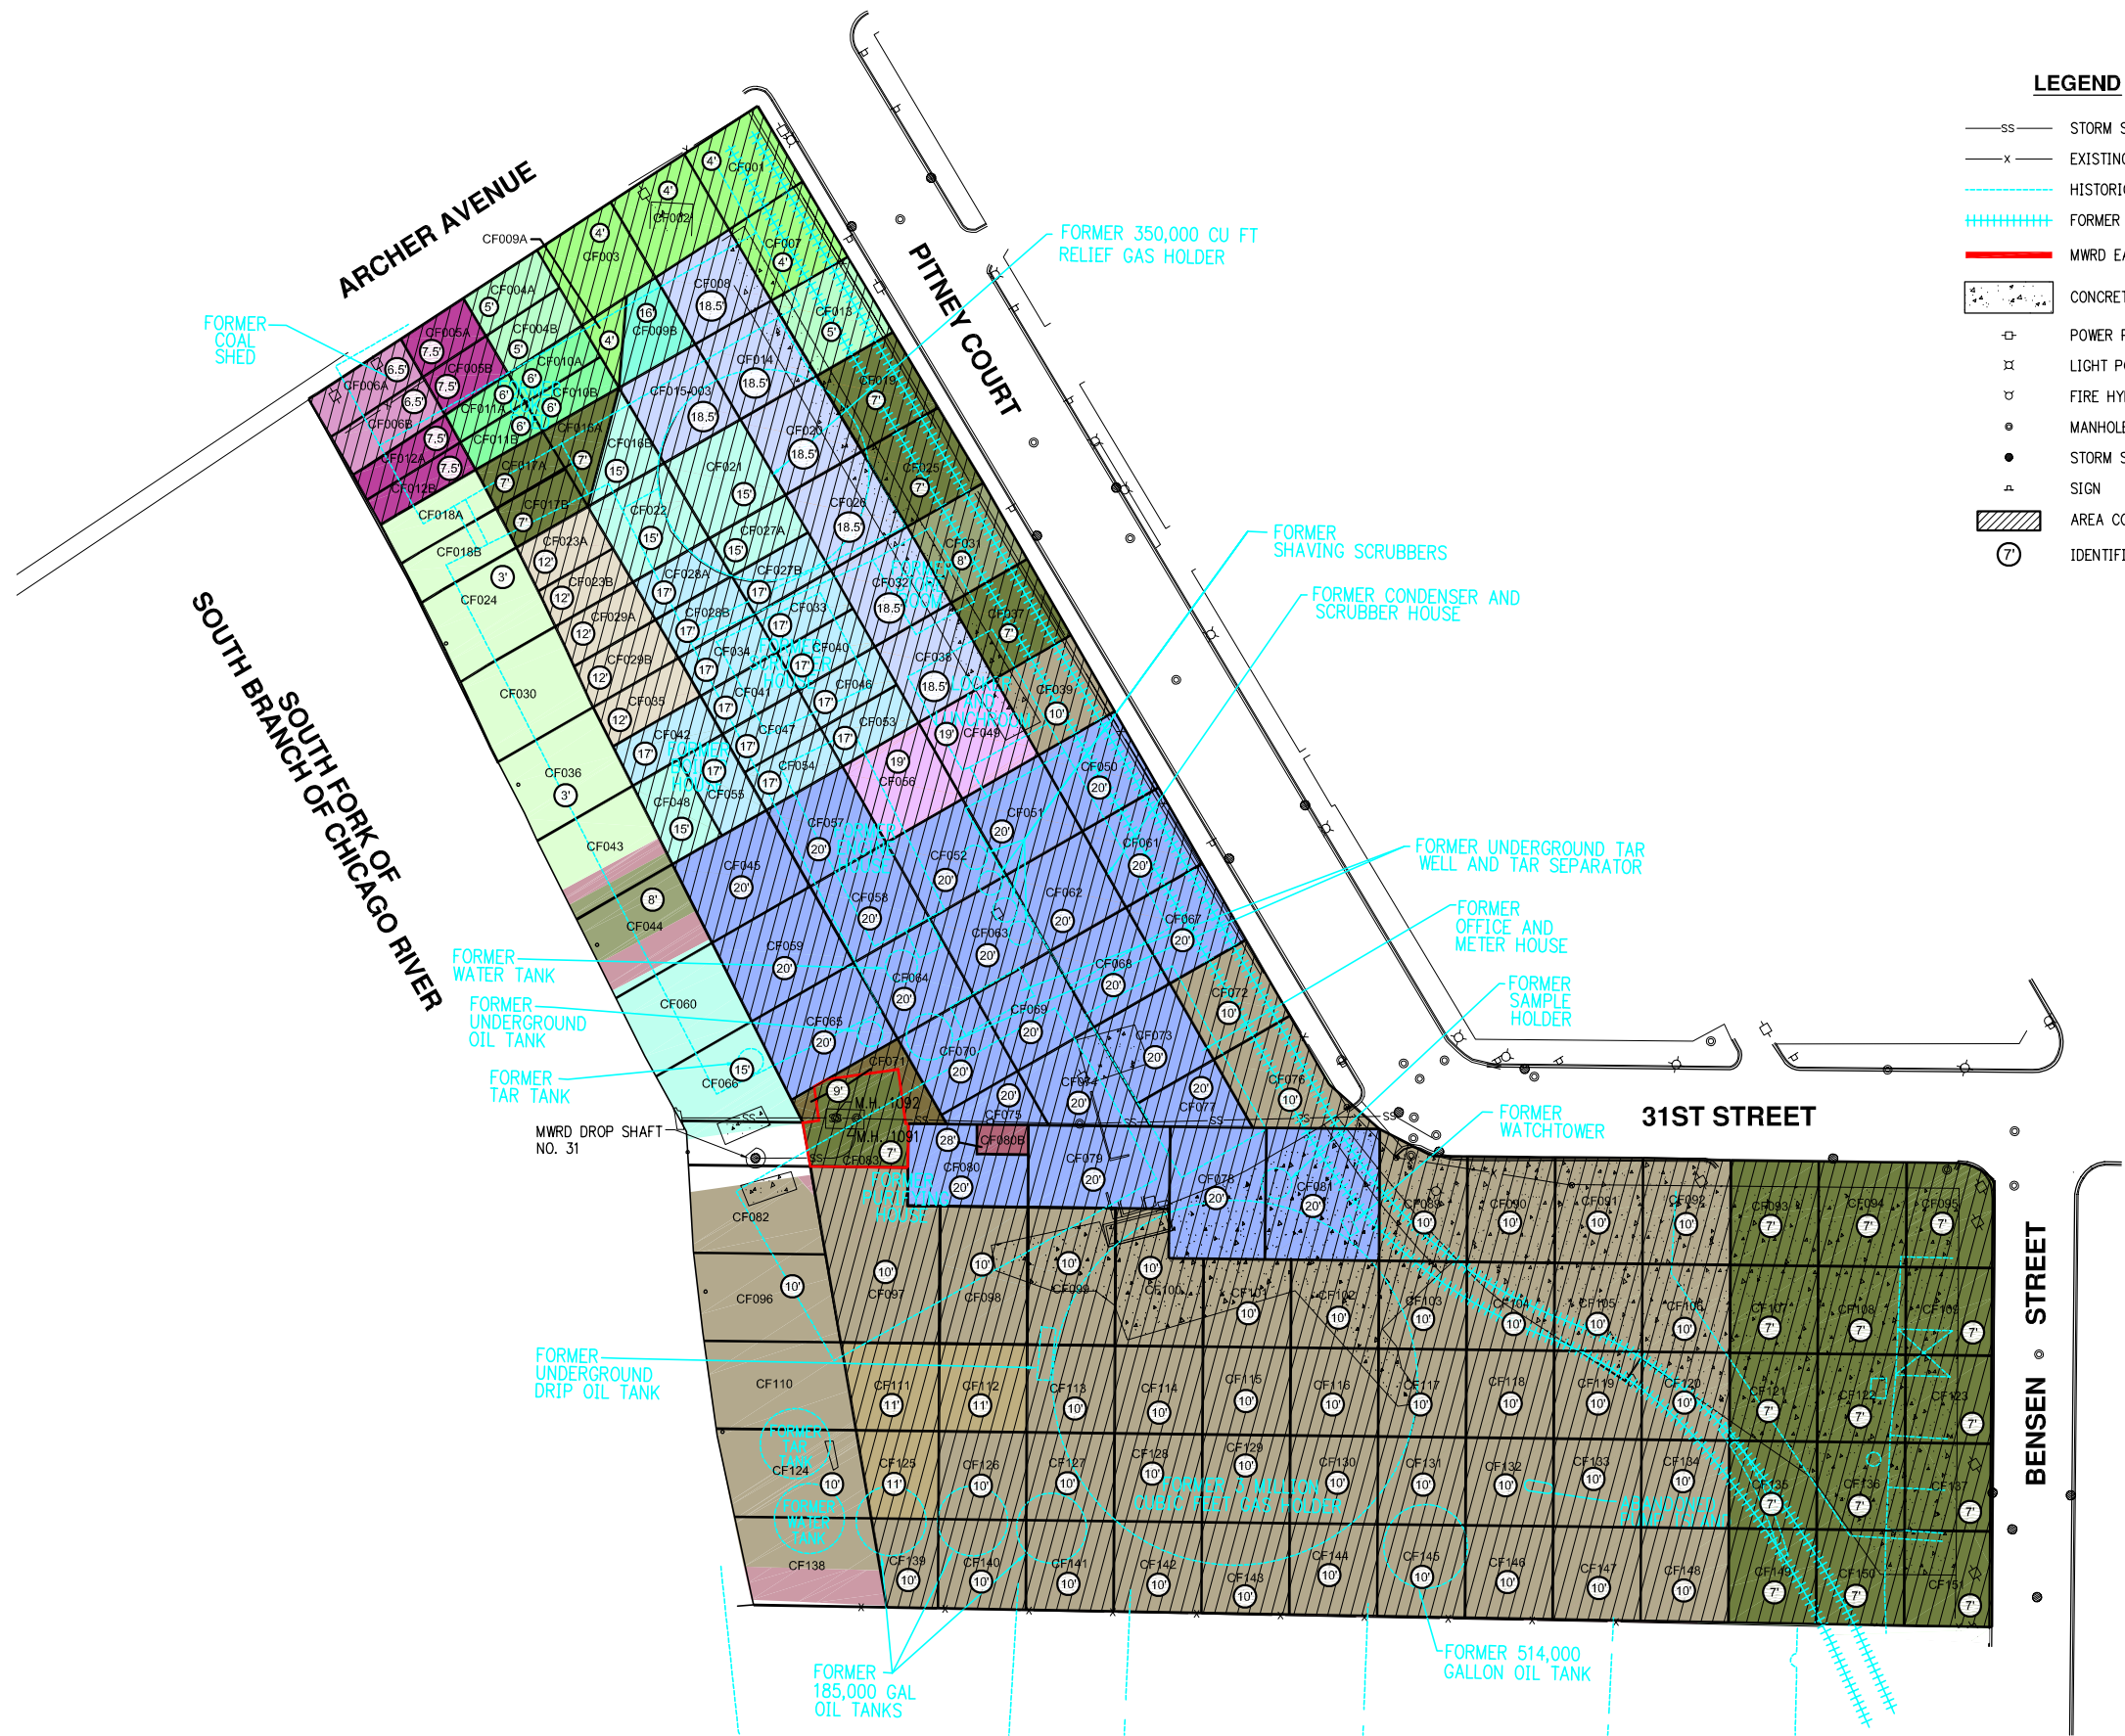

LEGEND

- SS STORM SEWER
- X EXISTING FENCE
- HISTORICAL FEATURES/FORMER STRUCTURES
- FORMER RAILROAD TRACKS
- MWRD EASEMENT
- CONCRETE
- POWER POLE
- LIGHT POLE
- FIRE HYDRANT
- MANHOLE
- STORM SEWER/CATCH BASIN
- SIGN
- AREA COMPLETED
- IDENTIFIED DEPTH OF EXCAVATION



40 0 40 80  
SCALE IN FEET

DRAFT

DECEMBER 01, 2007




date	12-01-07	detailed	J. PEREZ
designed	A. HANRAHAN	checked	

THE PEOPLES GAS LIGHT  
AND COKE COMPANY  
CHICAGO, ILLINOIS

PITNEY COURT  
3052 SOUTH PITNEY COURT  
CHICAGO, ILLINOIS

Figure 1 AS-BUILT EXCAVATION LAYOUT MAP PITNEY COURT CHICAGO, ILLINOIS			
project	27112	contract	
drawing		rev.	
sheet	1	of	1
file E:\PEOPLES GAS\PITNEY COURT_CAD\BIDDING\INPROGRESS\2007-12-01\PITNEY COURT EXCAVATION			



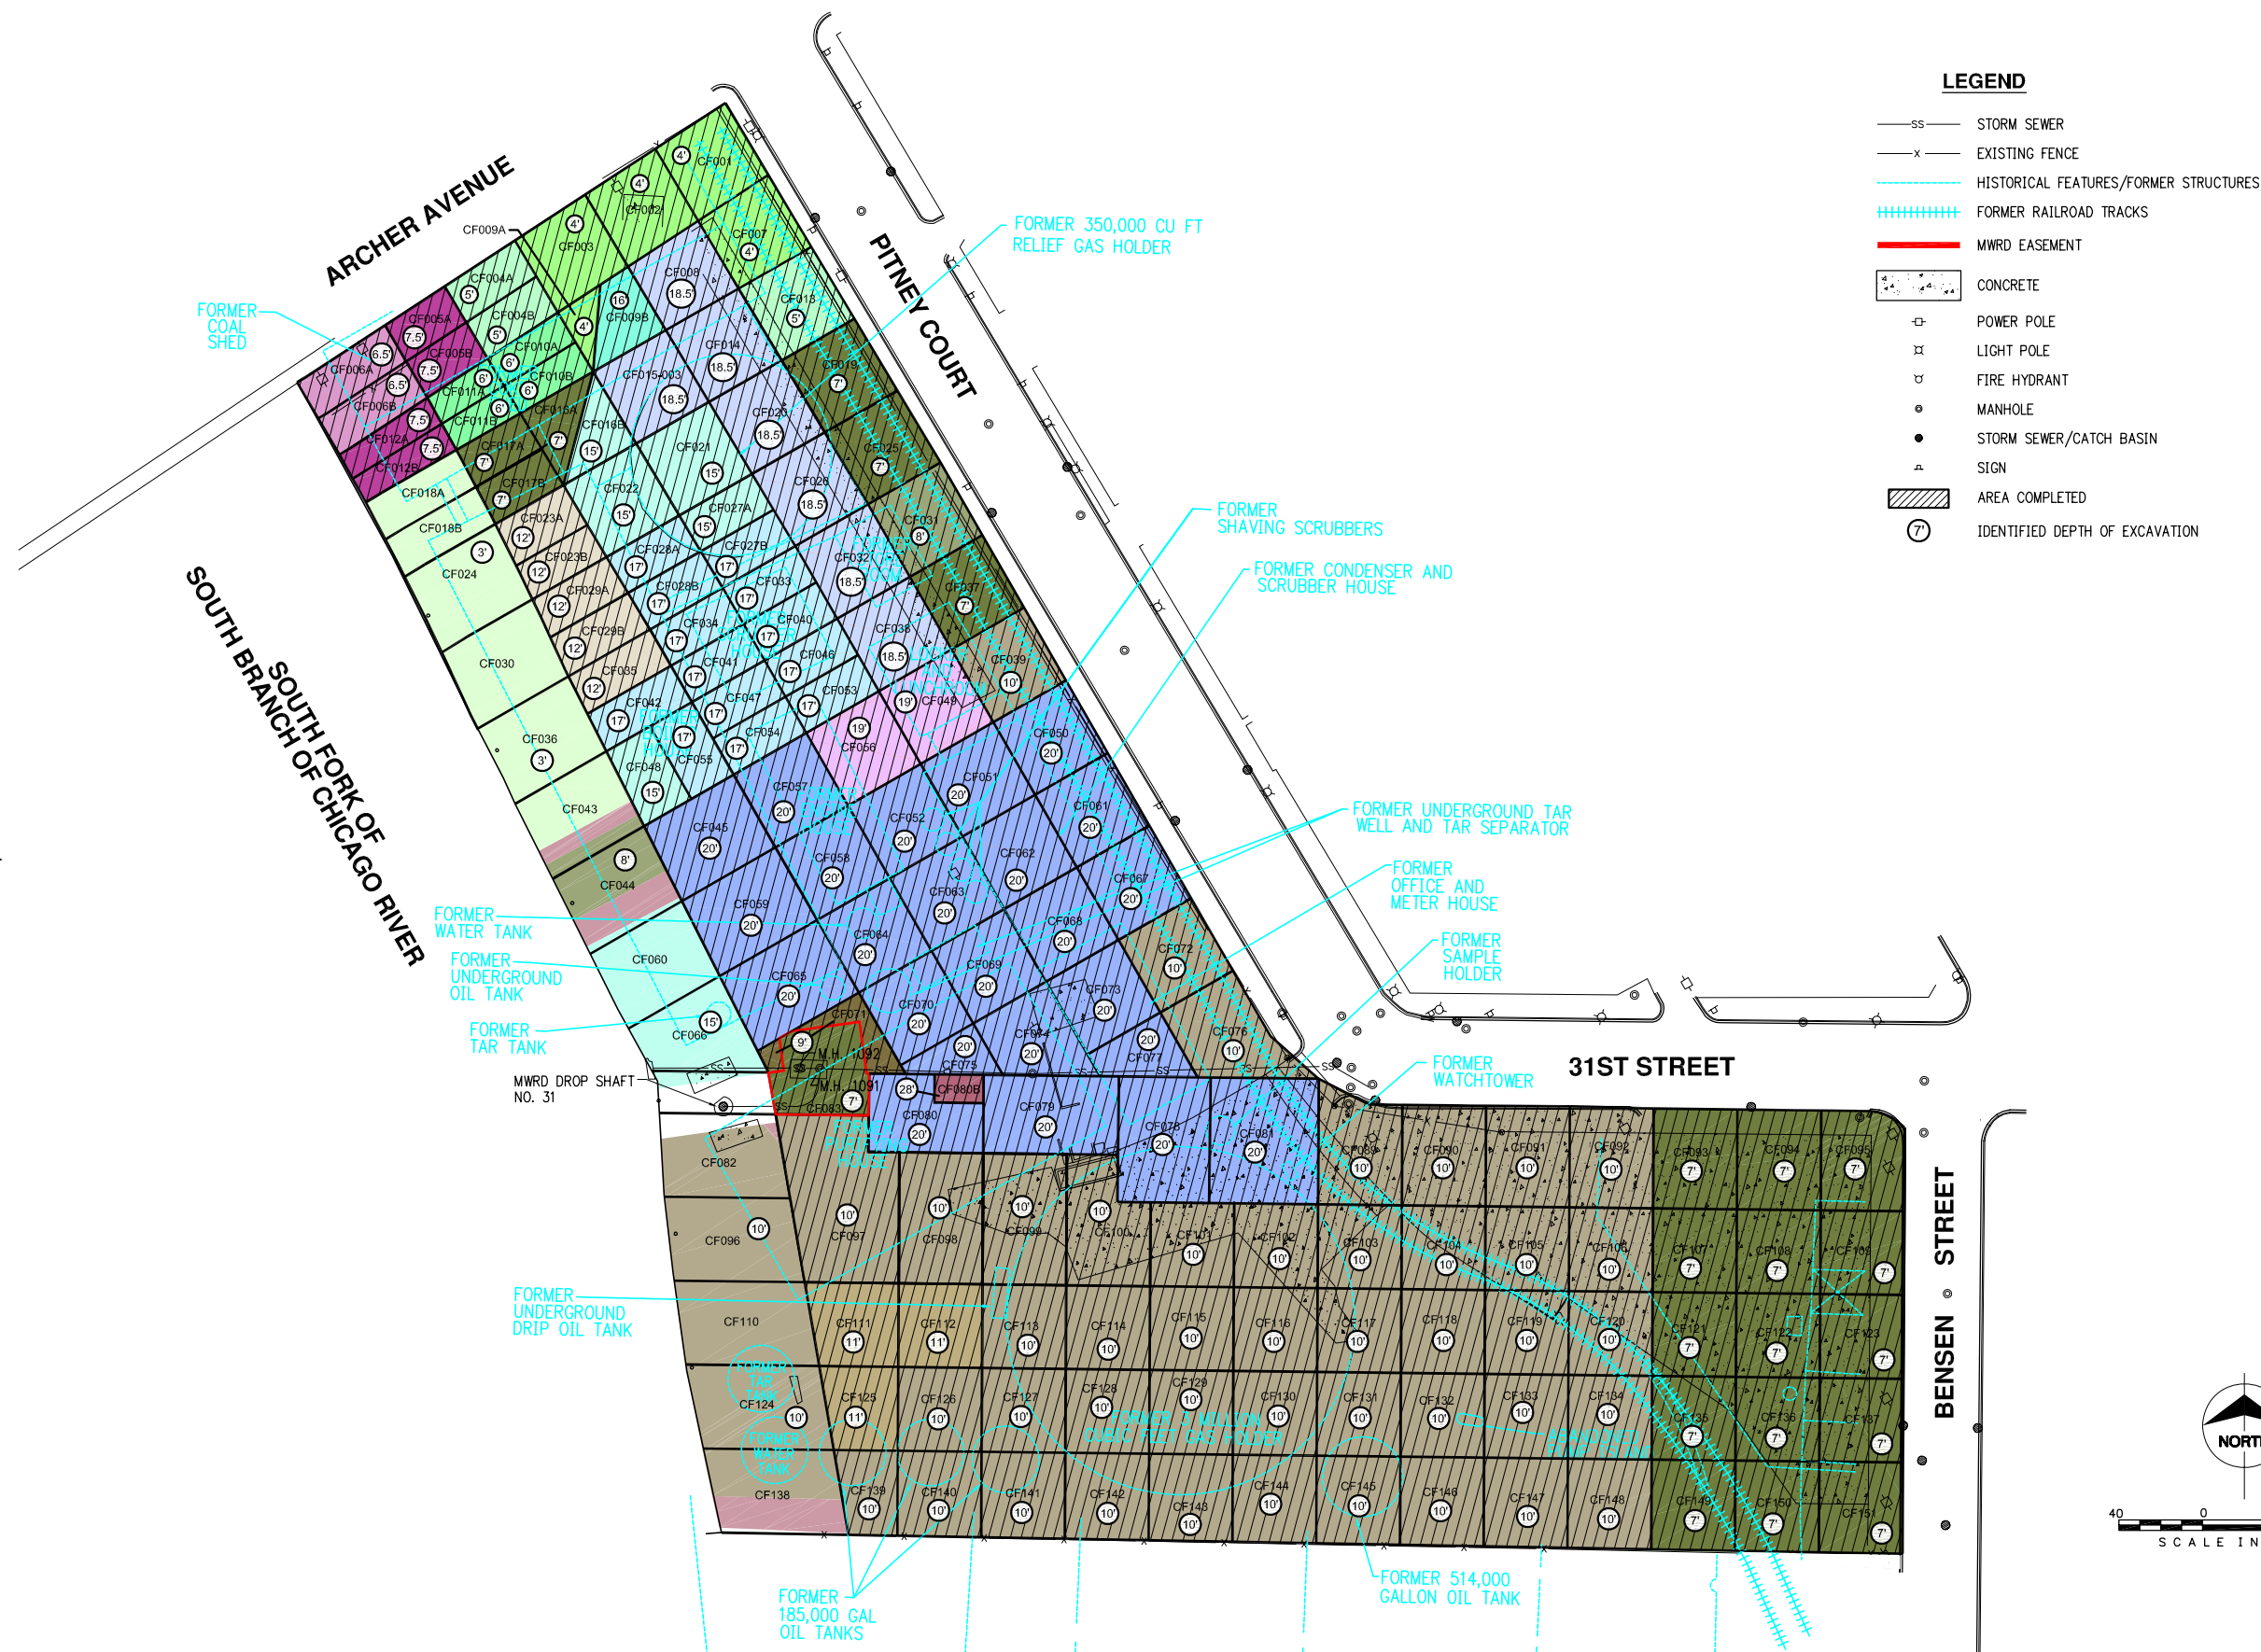




**DRAFT**

**DECEMBER 08, 2007**

no.	date	by	ckd	description
-----	------	----	-----	-------------


	
date 12-08-07	detailed J. PEREZ
designed A. HANRAHAN	checked
<p>THE PEOPLES GAS LIGHT AND COKE COMPANY CHICAGO, ILLINOIS</p> <p>PITNEY COURT 3052 SOUTH PITNEY COURT CHICAGO, ILLINOIS</p>	
<p>Figure 1</p> <p>AS-BUILT EXCAVATION LAYOUT MAP PITNEY COURT CHICAGO, ILLINOIS</p>	
project 27112	contract
drawing	rev.
<div style="text-align: center;">  </div>	
sheet 1	of 1 sheets
file \\PEOPLES GAS\PITNEY COURT_ICAD\BID\WORK IN PROGRESS\2007-12-08 PITNEY COURT EXCAVATION	




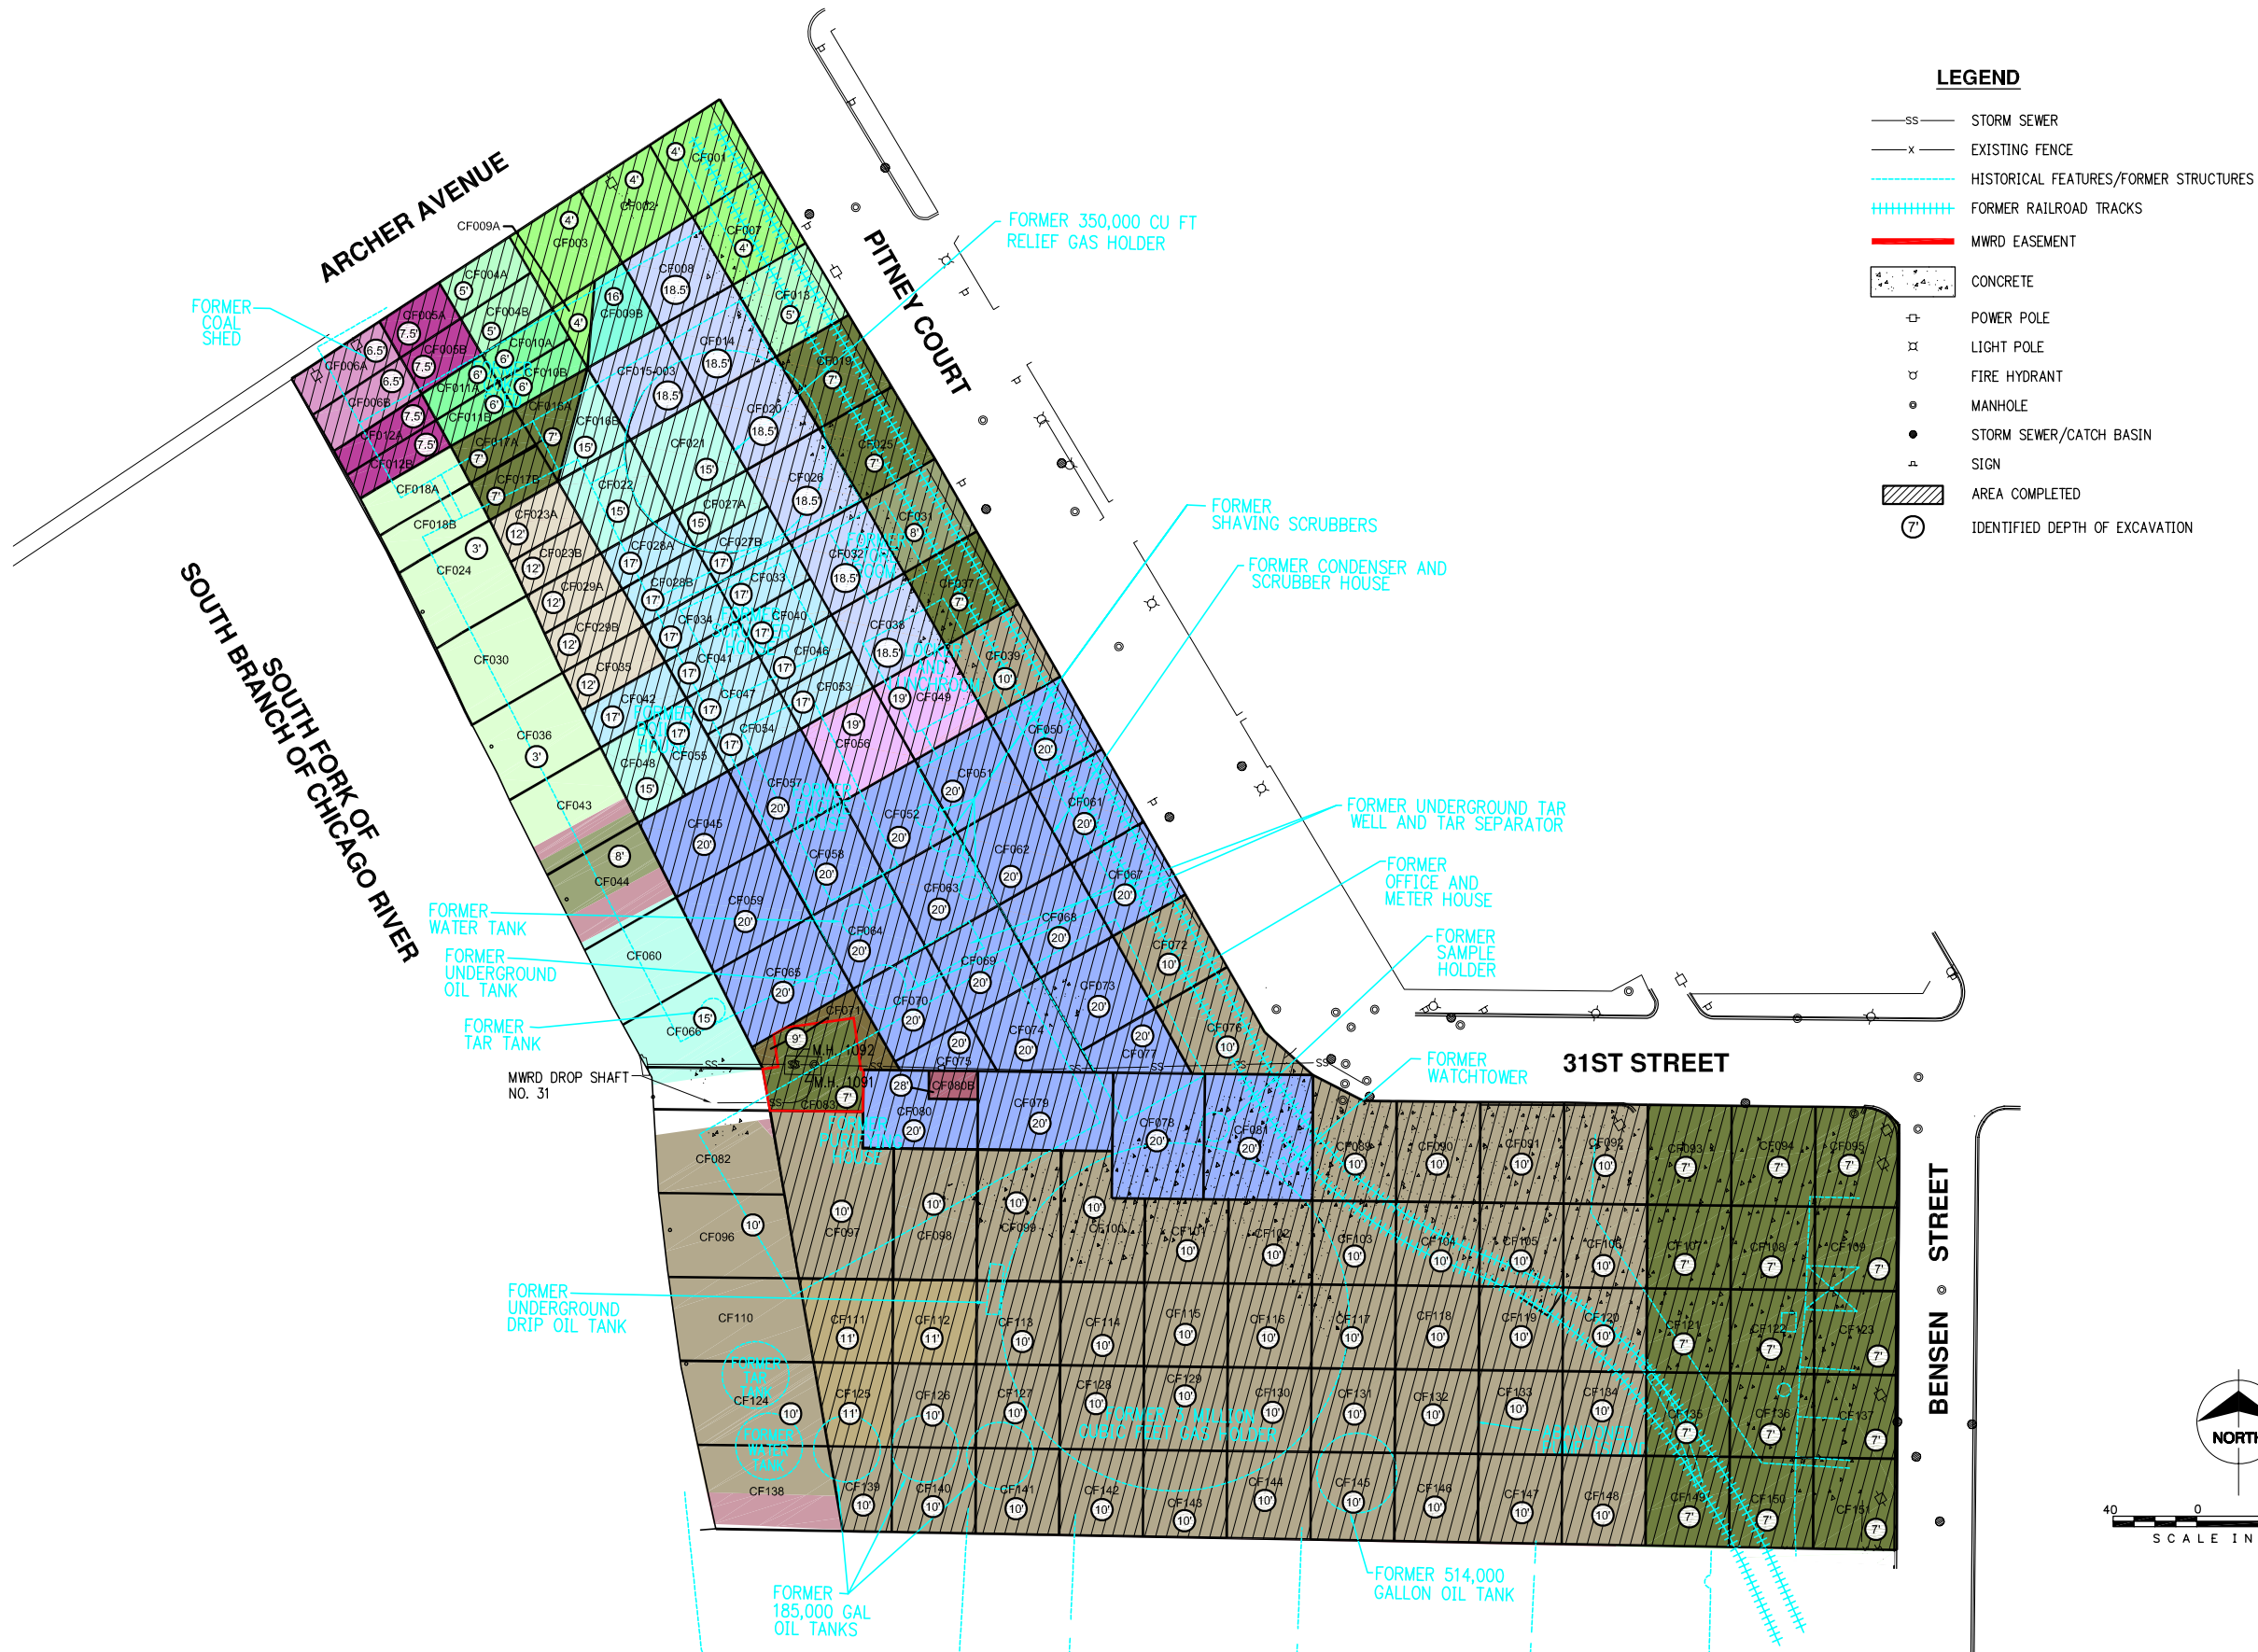

**DRAFT**

**DECEMBER 15, 2007**


	
date 12-15-07	detailed J. PEREZ
designed A. HANRAHAN	checked
<b>THE PEOPLES GAS LIGHT AND COKE COMPANY CHICAGO, ILLINOIS</b>	
<b>PITNEY COURT 3052 SOUTH PITNEY COURT CHICAGO, ILLINOIS</b>	
Figure 1 AS-BUILT EXCAVATION LAYOUT MAP PITNEY COURT CHICAGO, ILLINOIS	
project 27112	contract
drawing	rev.
sheet 1 of 1 sheets	
file EPEOPLES GAS PITNEY COURT_IAD\BENSON IN PROGRESS\2007-12-15 PITNEY COURT EXCAVATION	

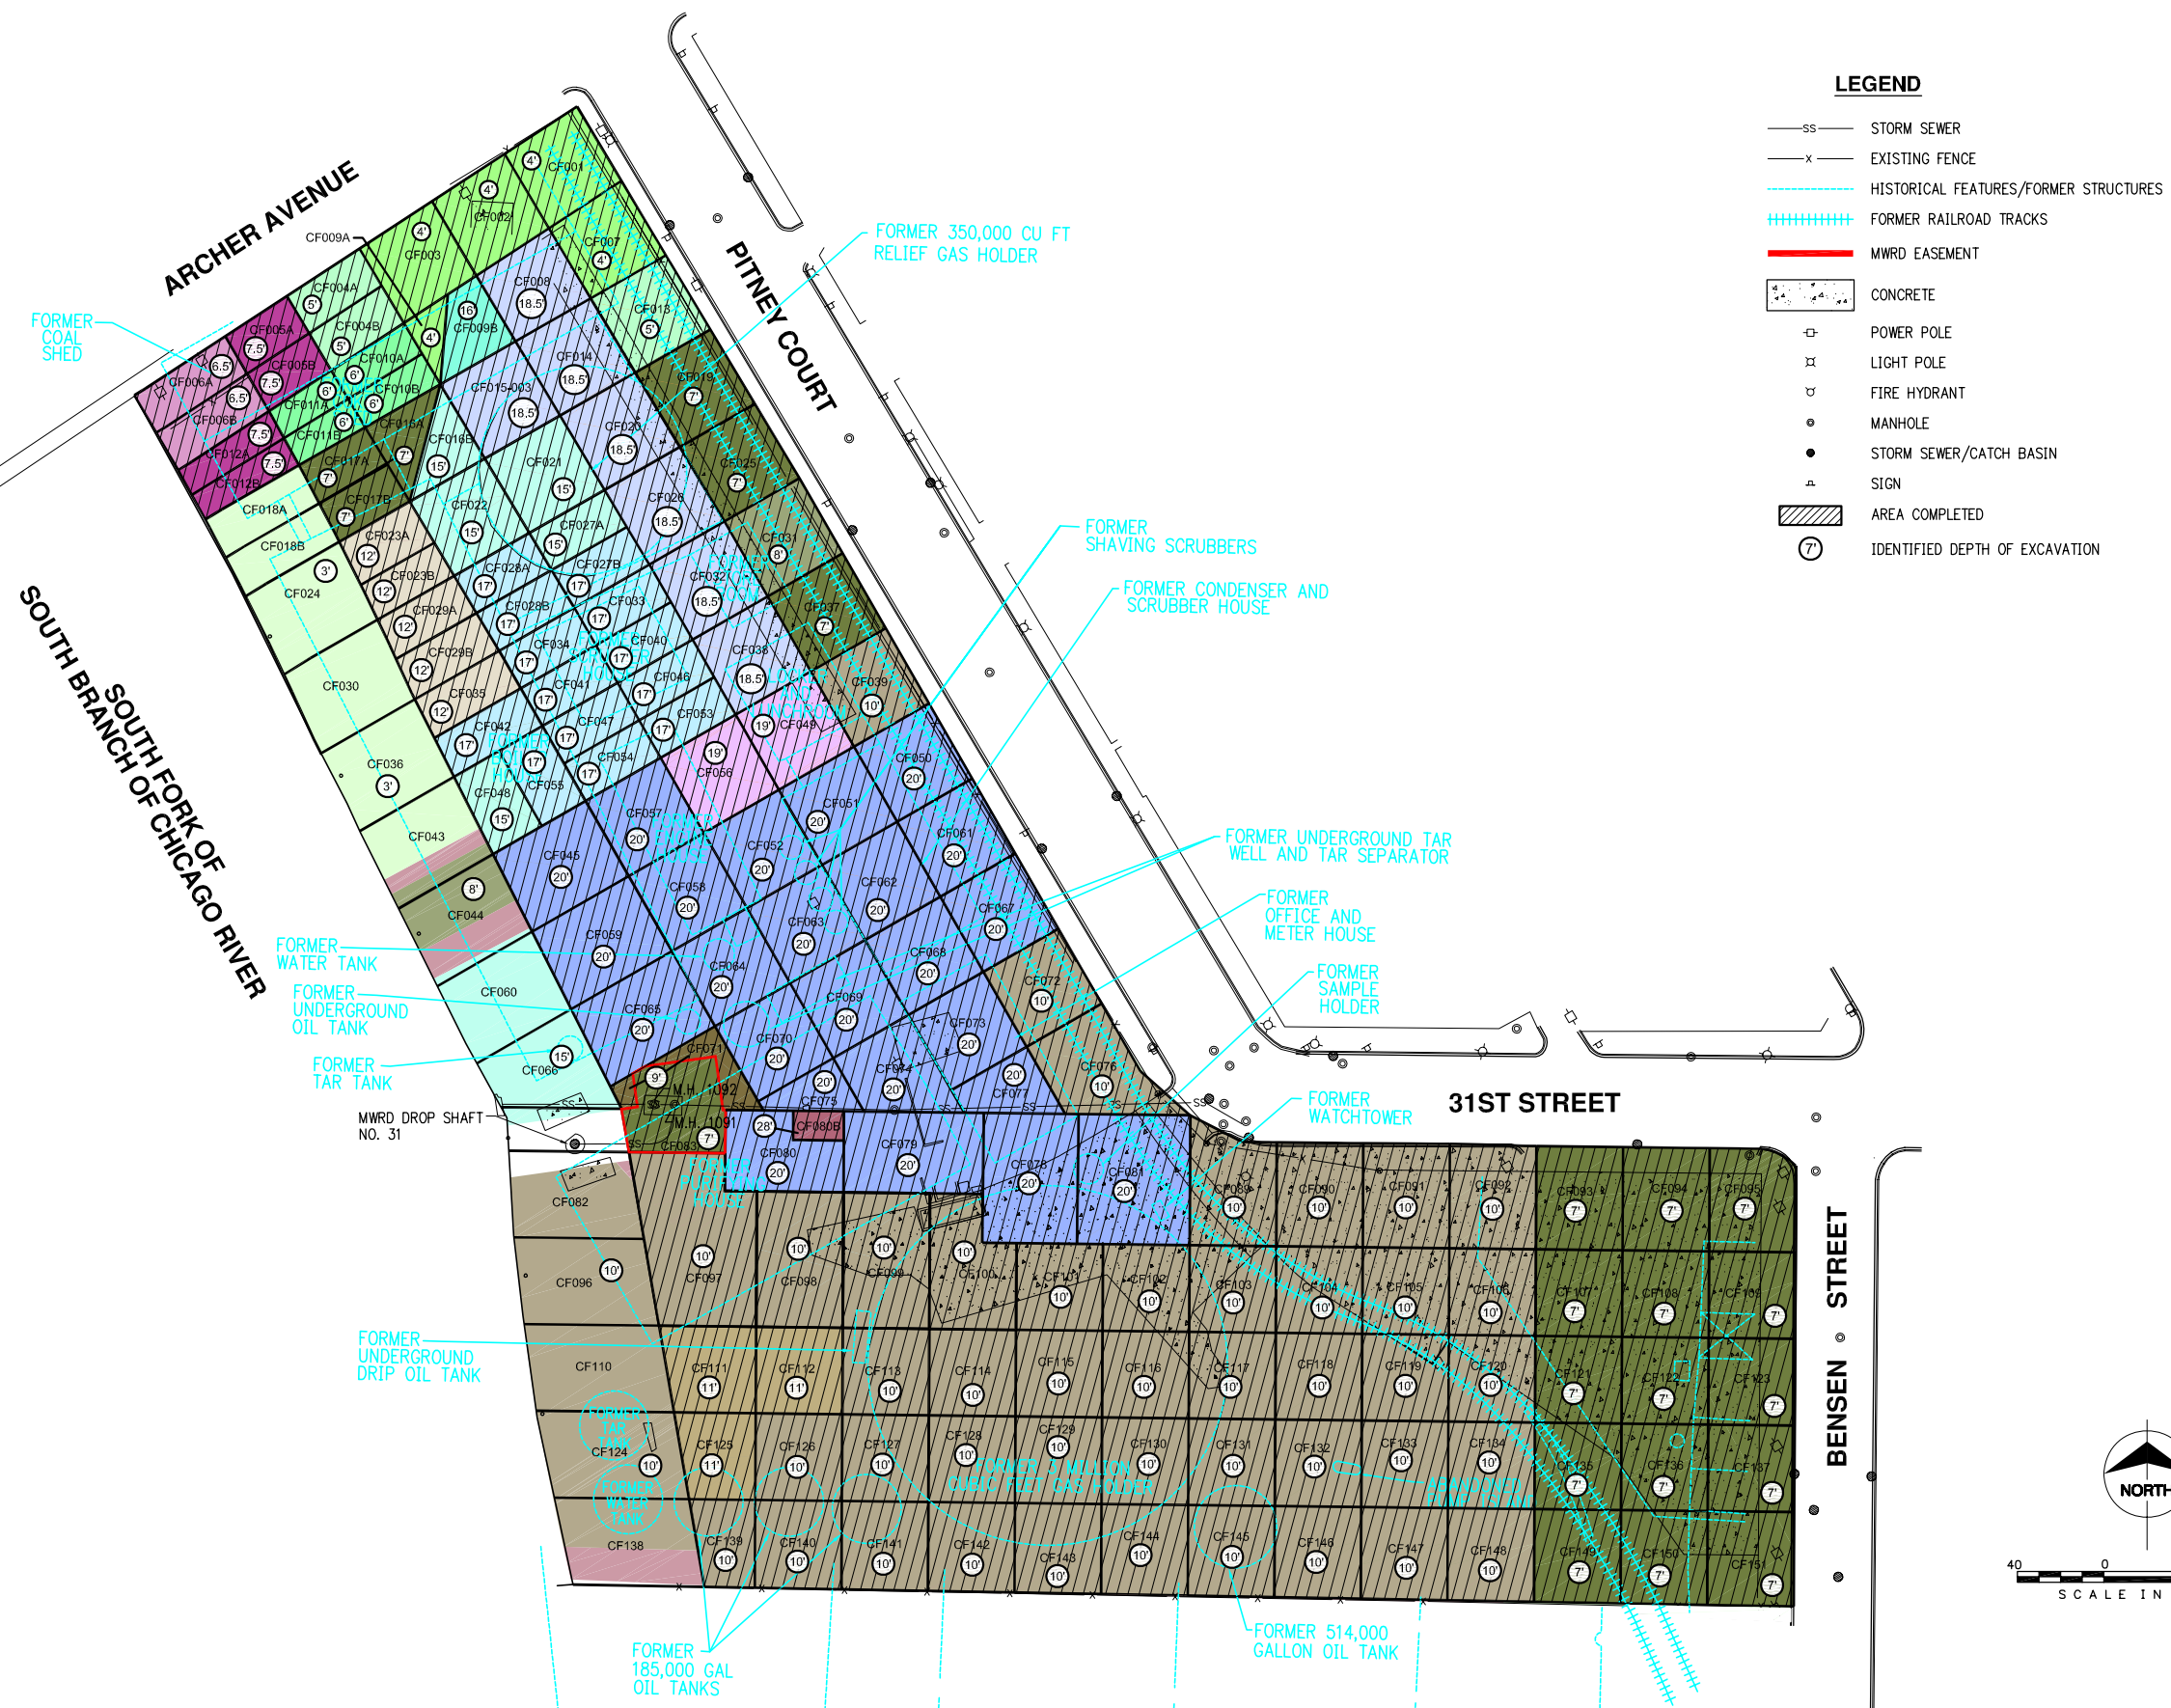


**DRAFT**

**DECEMBER 22, 2007**

no.	date	by	ckd	description
-----	------	----	-----	-------------

	
date 12-22-07	<div> <div>detailed</div> <div>J. PEREZ</div> </div>
<div> <div>designed</div> <div>A. HANRAHAN</div> </div>	<div> <div>checked</div> </div>
<p>THE PEOPLES GAS LIGHT AND COKE COMPANY CHICAGO, ILLINOIS</p> <p>PITNEY COURT 3052 SOUTH PITNEY COURT CHICAGO, ILLINOIS</p>	
<p>Figure 1</p> <p>AS-BUILT EXCAVATION LAYOUT MAP PITNEY COURT CHICAGO, ILLINOIS</p>	
<div> <div>project</div> <div>27112</div> </div>	<div> <div>contract</div> </div>
<div> <div>drawing</div> </div>	<div> <div>rev.</div> </div>
<div> <div>sheet 1 of 1 sheets</div> </div>	
<div> <div>file</div> <div>EPEOPLES GAS PITNEY COURT_ICAD/BUILDWORK/IN PROGRESS/2007-12-22 PITNEY COURT EXCAVATION</div> </div>	



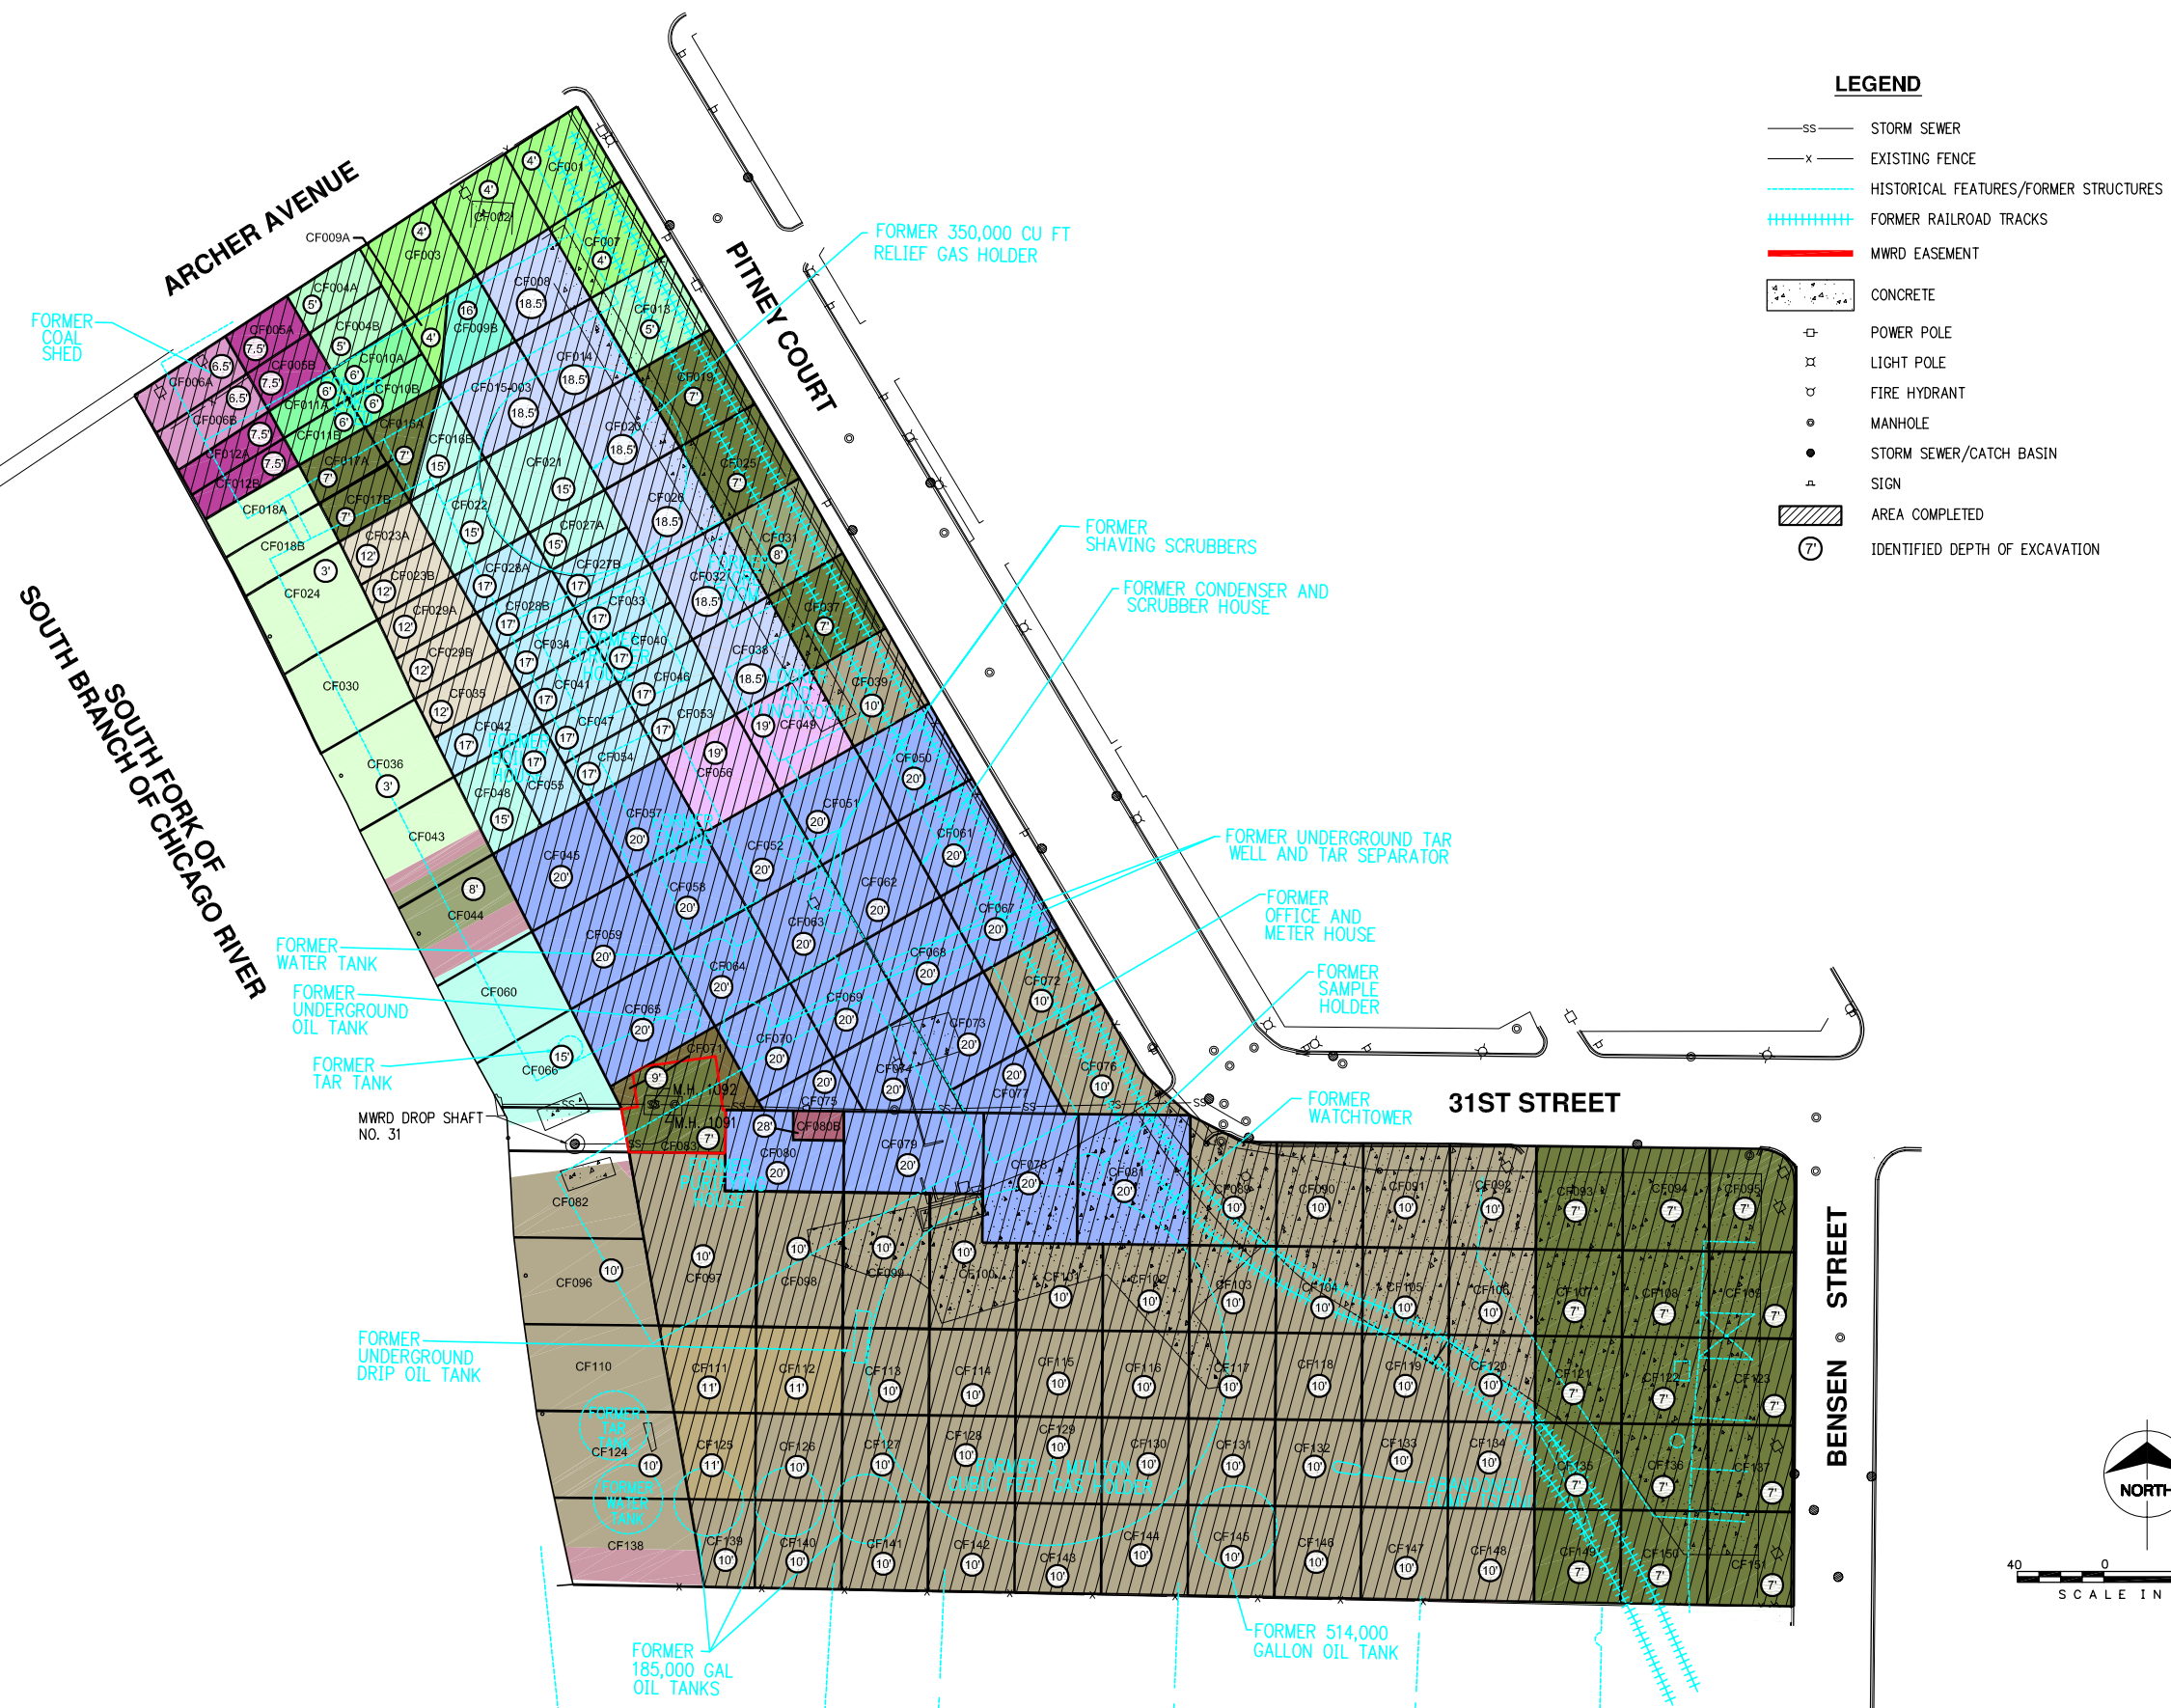

**DRAFT**

**DECEMBER 29, 2007**

no.	date	by	ckd	description
-----	------	----	-----	-------------



date 12-29-07	detailed J. PEREZ
designed A. HANRAHAN	checked

THE PEOPLES GAS LIGHT  
AND COKE COMPANY  
CHICAGO, ILLINOIS

PITNEY COURT  
3052 SOUTH PITNEY COURT  
CHICAGO, ILLINOIS


Figure 1  
AS-BUILT EXCAVATION LAYOUT MAP  
PITNEY COURT  
CHICAGO, ILLINOIS

CHICAGO, ILLINOIS	
project 27112	contract
drawing	rev.

sheet 1 of 1 sheets

file INPEOPLES GAS PITNEY COURT, JCAD BROWWORK IN PROGRESS 2007-12-29 PITNEY COURT EXCAVATION



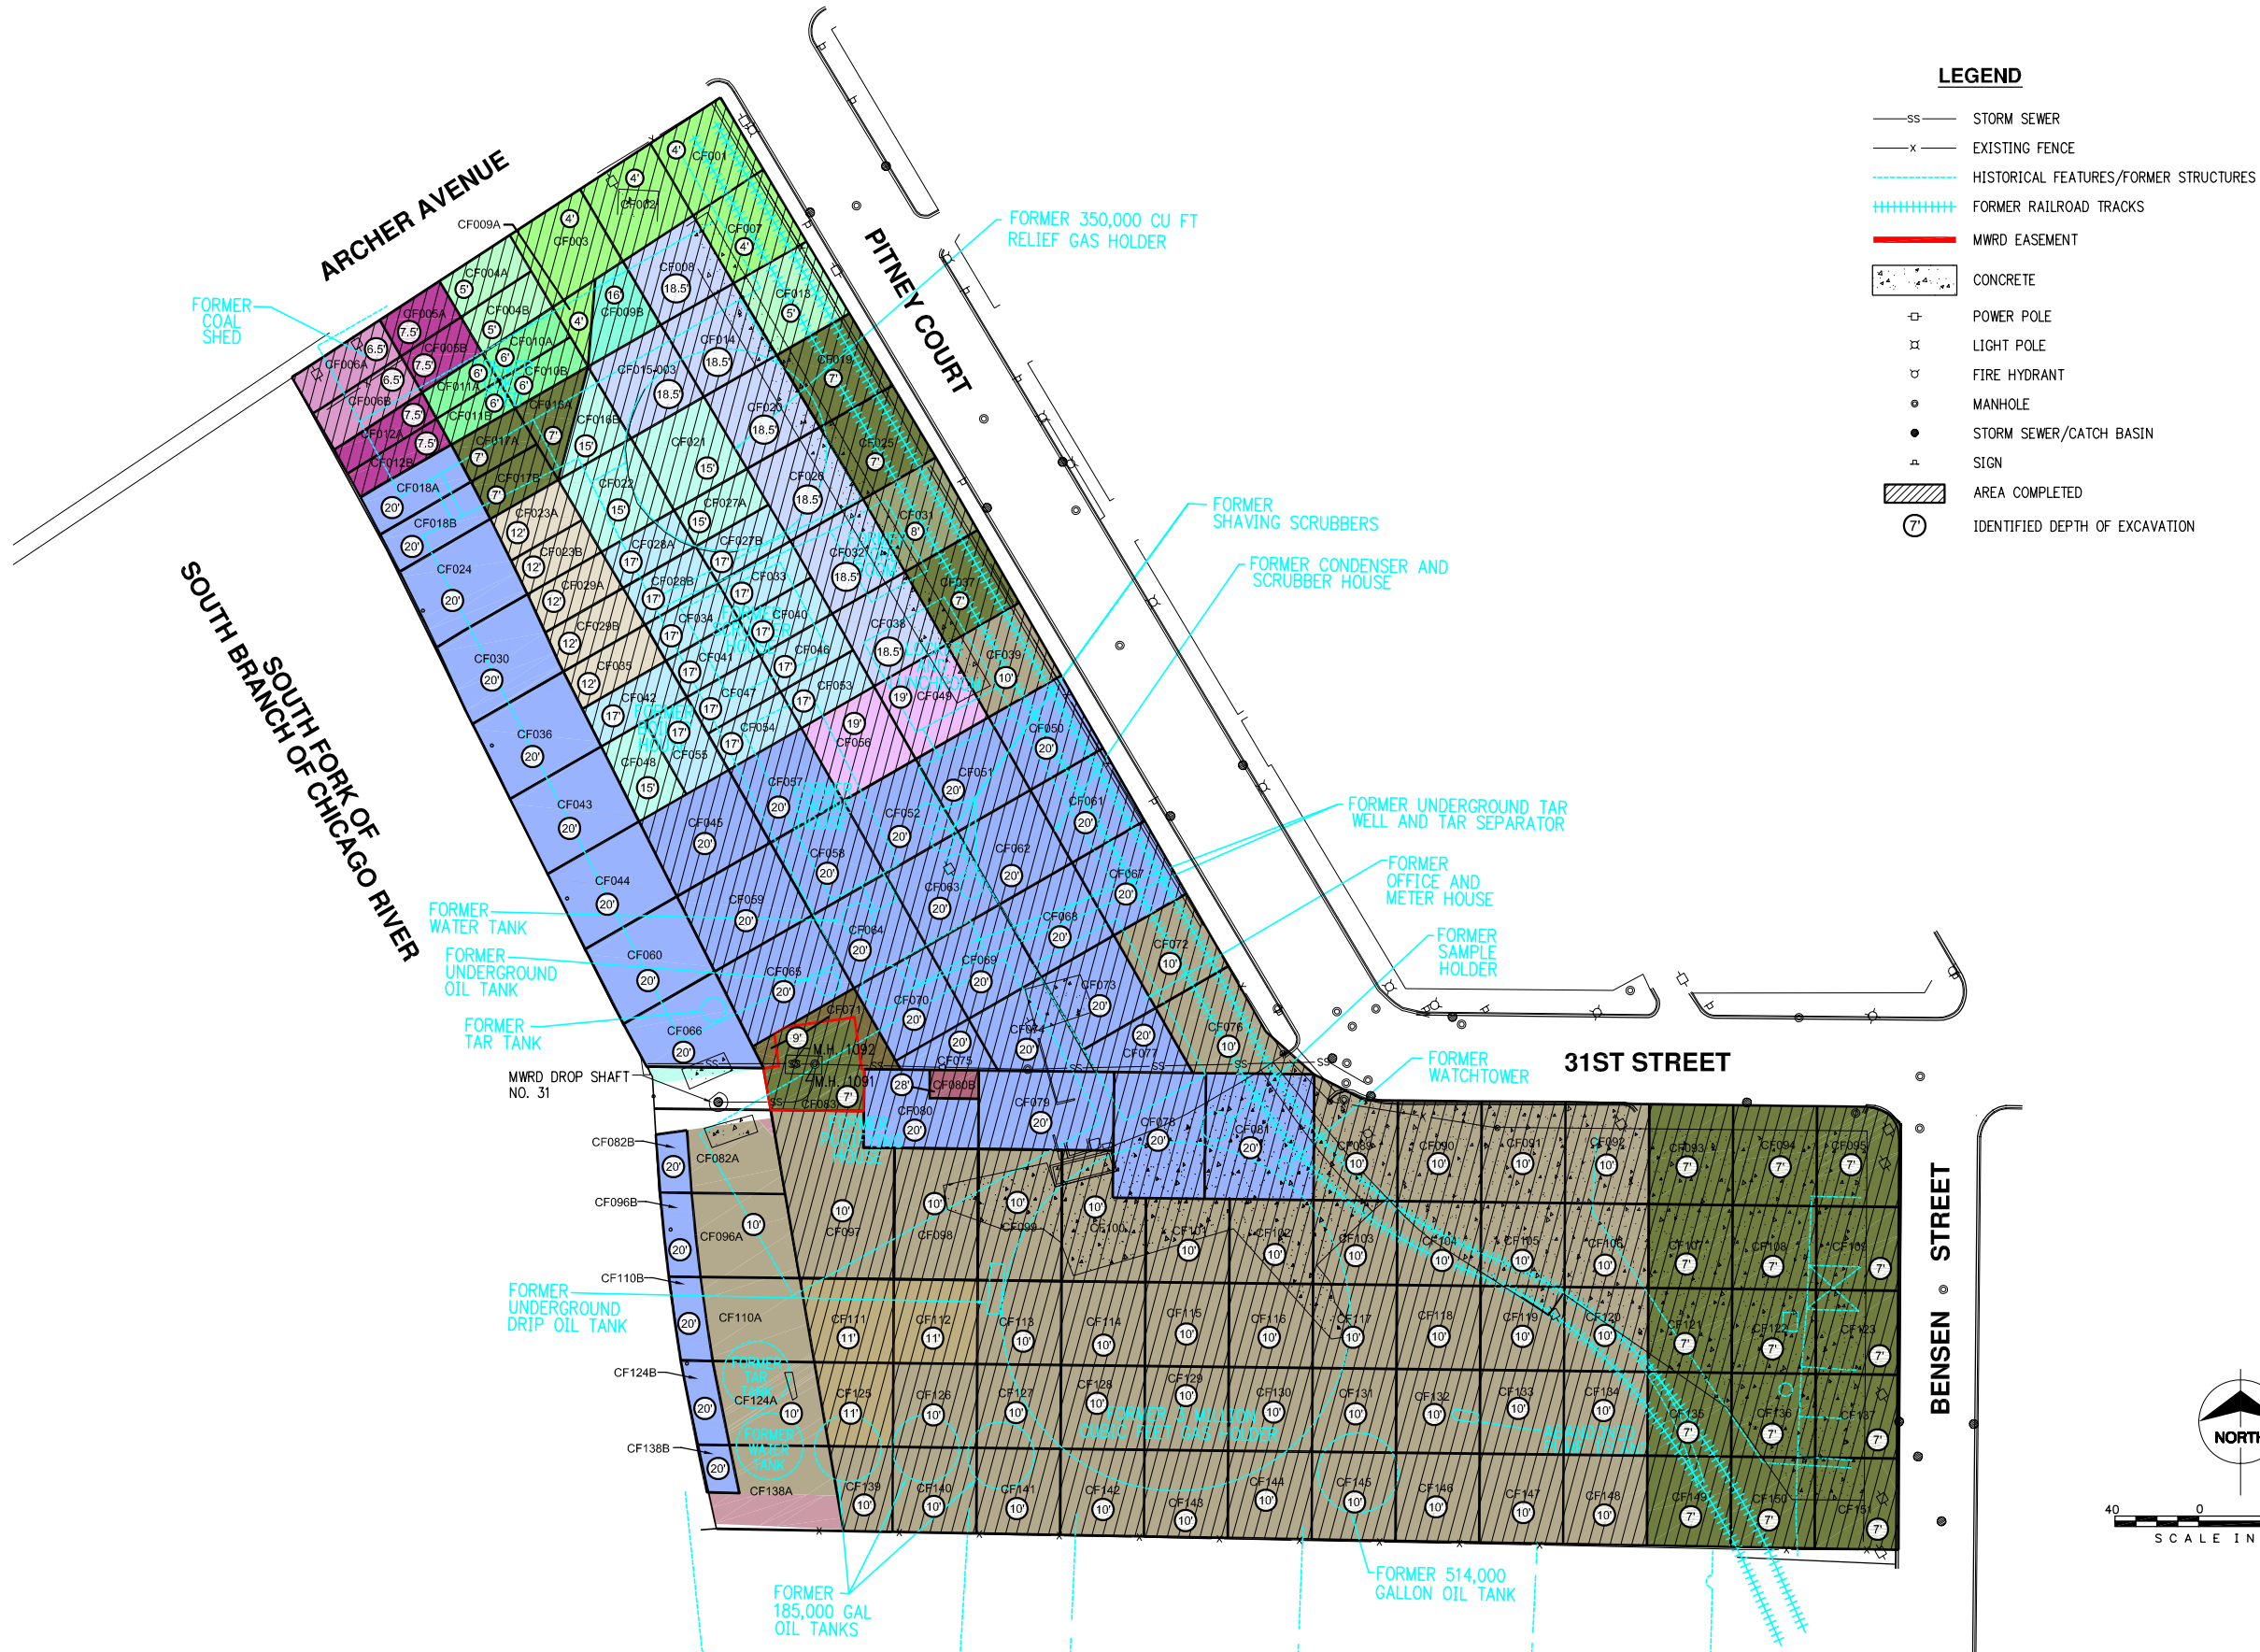

40 0 40 80  
SCALE IN FEET

**DRAFT**

**JANUARY 05, 2008**



date	01-05-08	detailed	J. PEREZ
designed	A. HANRAHAN	checked	

THE PEOPLES GAS LIGHT  
AND COKE COMPANY  
CHICAGO, ILLINOIS

PITNEY COURT  
3052 SOUTH PITNEY COURT  
CHICAGO, ILLINOIS


Figure 1  
AS-BUILT EXCAVATION LAYOUT MAP  
PITNEY COURT  
CHICAGO, ILLINOIS

project	27112	contract	
drawing		rev.	

sheet 1 of 1 sheets


file E:\PEOPLES GAS\PITNEY COURT\_CAD\BROWIN IN PROGRESS\2008-01-05 PITNEY COURT EXCAVATION



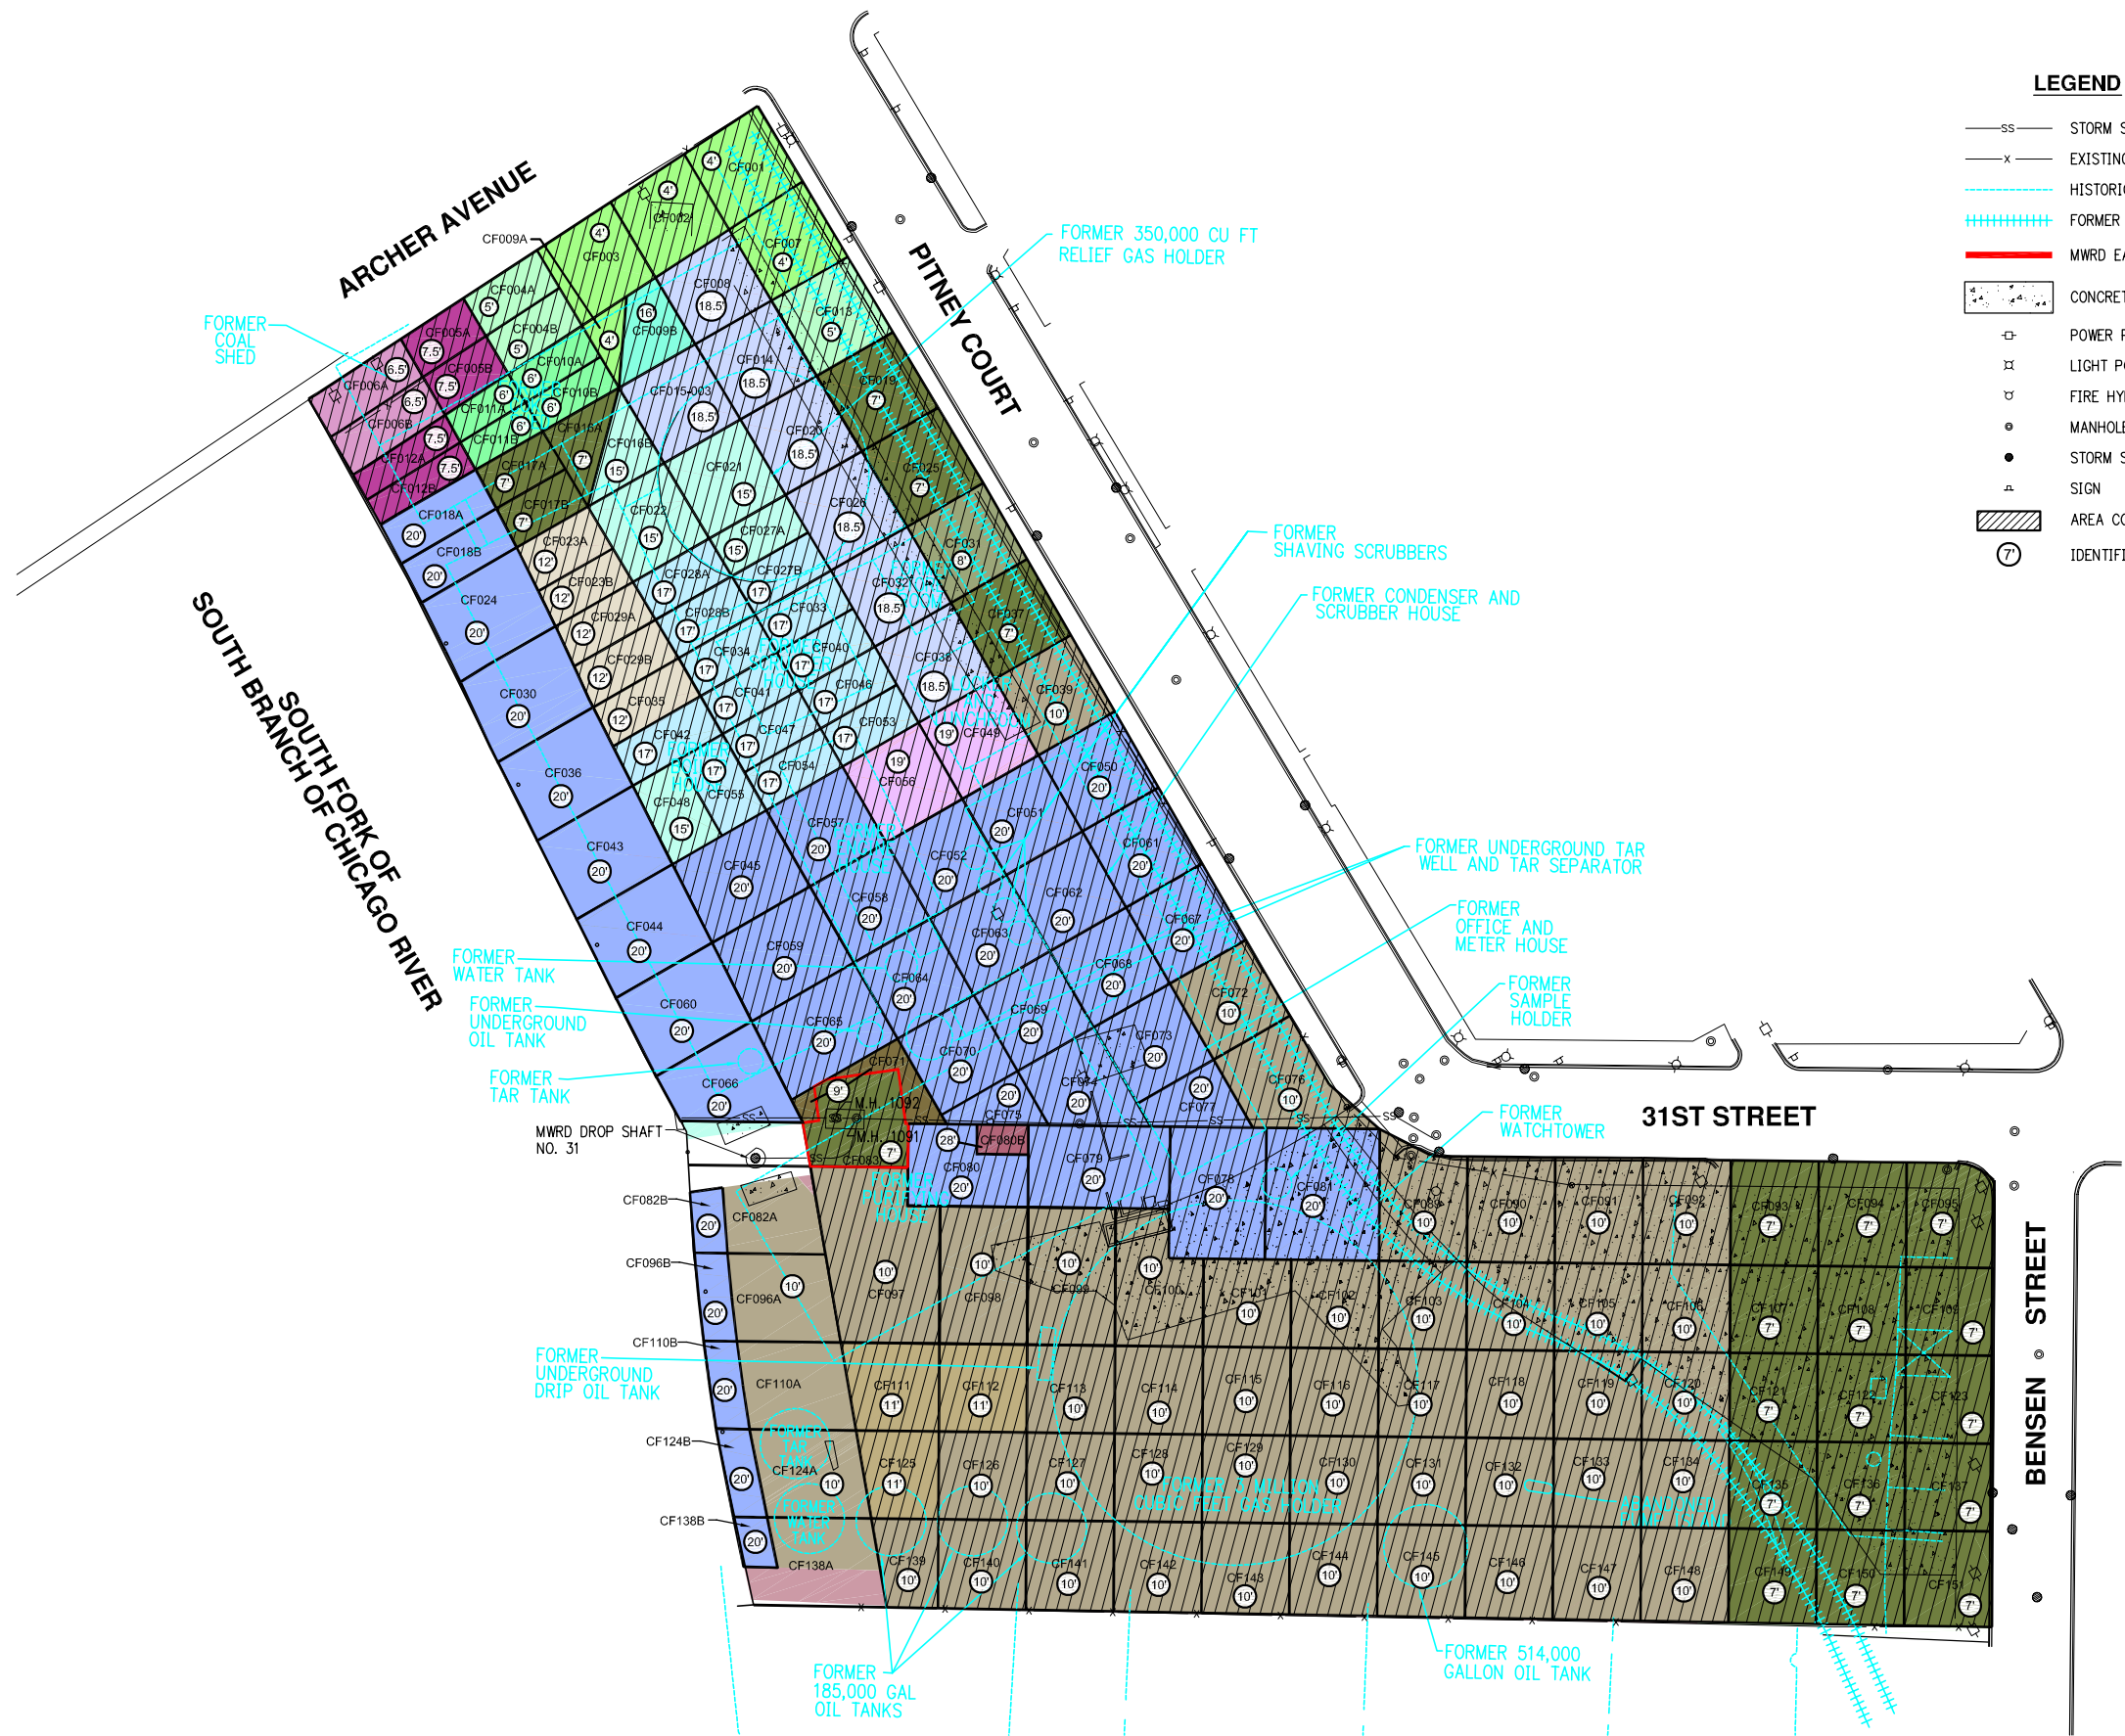


DRAFT

JANUARY 12, 2008


	
date 01-12-08	detailed J. PEREZ
designed A. HANRAHAN	checked
THE PEOPLES GAS LIGHT AND COKE COMPANY CHICAGO, ILLINOIS	
PITNEY COURT 3052 SOUTH PITNEY COURT CHICAGO, ILLINOIS	
Figure 1 AS-BUILT EXCAVATION LAYOUT MAP PITNEY COURT CHICAGO, ILLINOIS	
project 27112	contract
drawing	rev.
sheet 1 of 1 sheets	
file E:\PEOPLES GAS\PITNEY COURT_3052\BROWIN IN PROGRESS\2008-01-12\PITNEY COURT EXCAVATION	



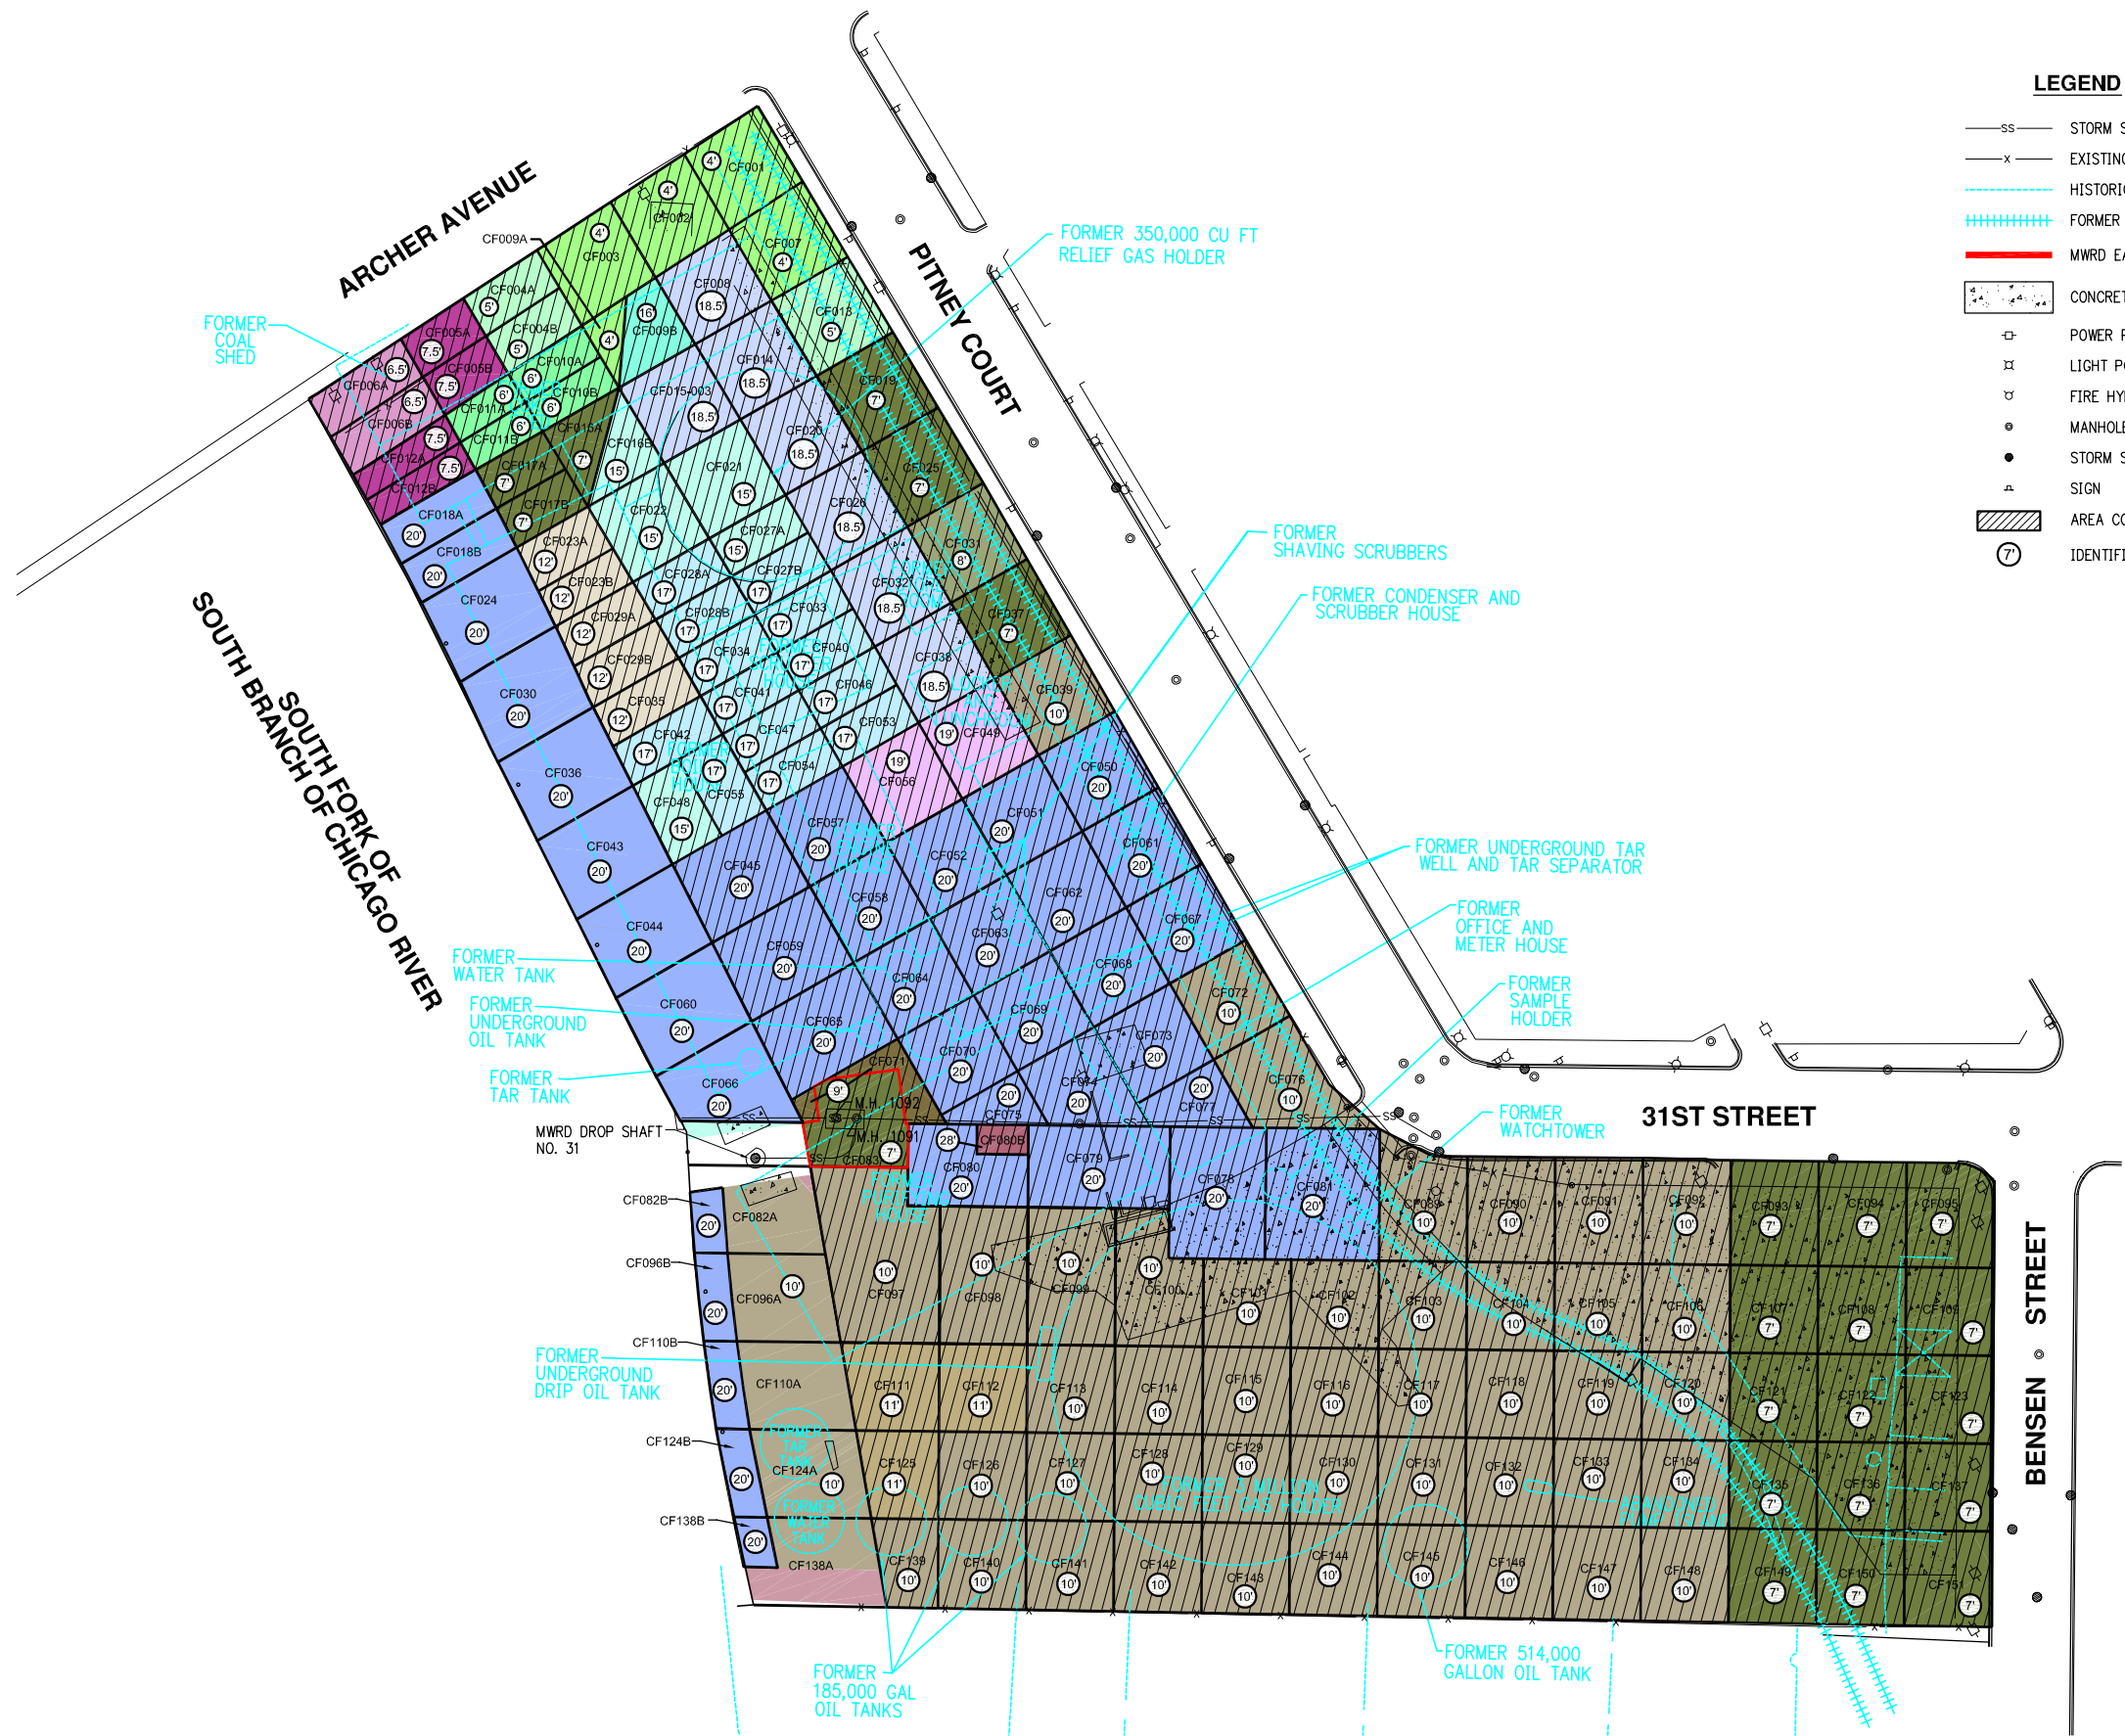


DRAFT

JANUARY 19, 2008


	
date 01-19-08	detailed J. PEREZ
designed A. HANRAHAN	checked
THE PEOPLES GAS LIGHT AND COKE COMPANY CHICAGO, ILLINOIS	
PITNEY COURT 3052 SOUTH PITNEY COURT CHICAGO, ILLINOIS	
Figure 1 AS-BUILT EXCAVATION LAYOUT MAP PITNEY COURT CHICAGO, ILLINOIS	
project 27112	contract
drawing	rev.
sheet 1 of 1 sheets	
file E:\PEOPLES GAS\PITNEY COURT\CAD\BROWER IN PROGRESS\2008-01-19\PITNEY COURT EXCAVATION	



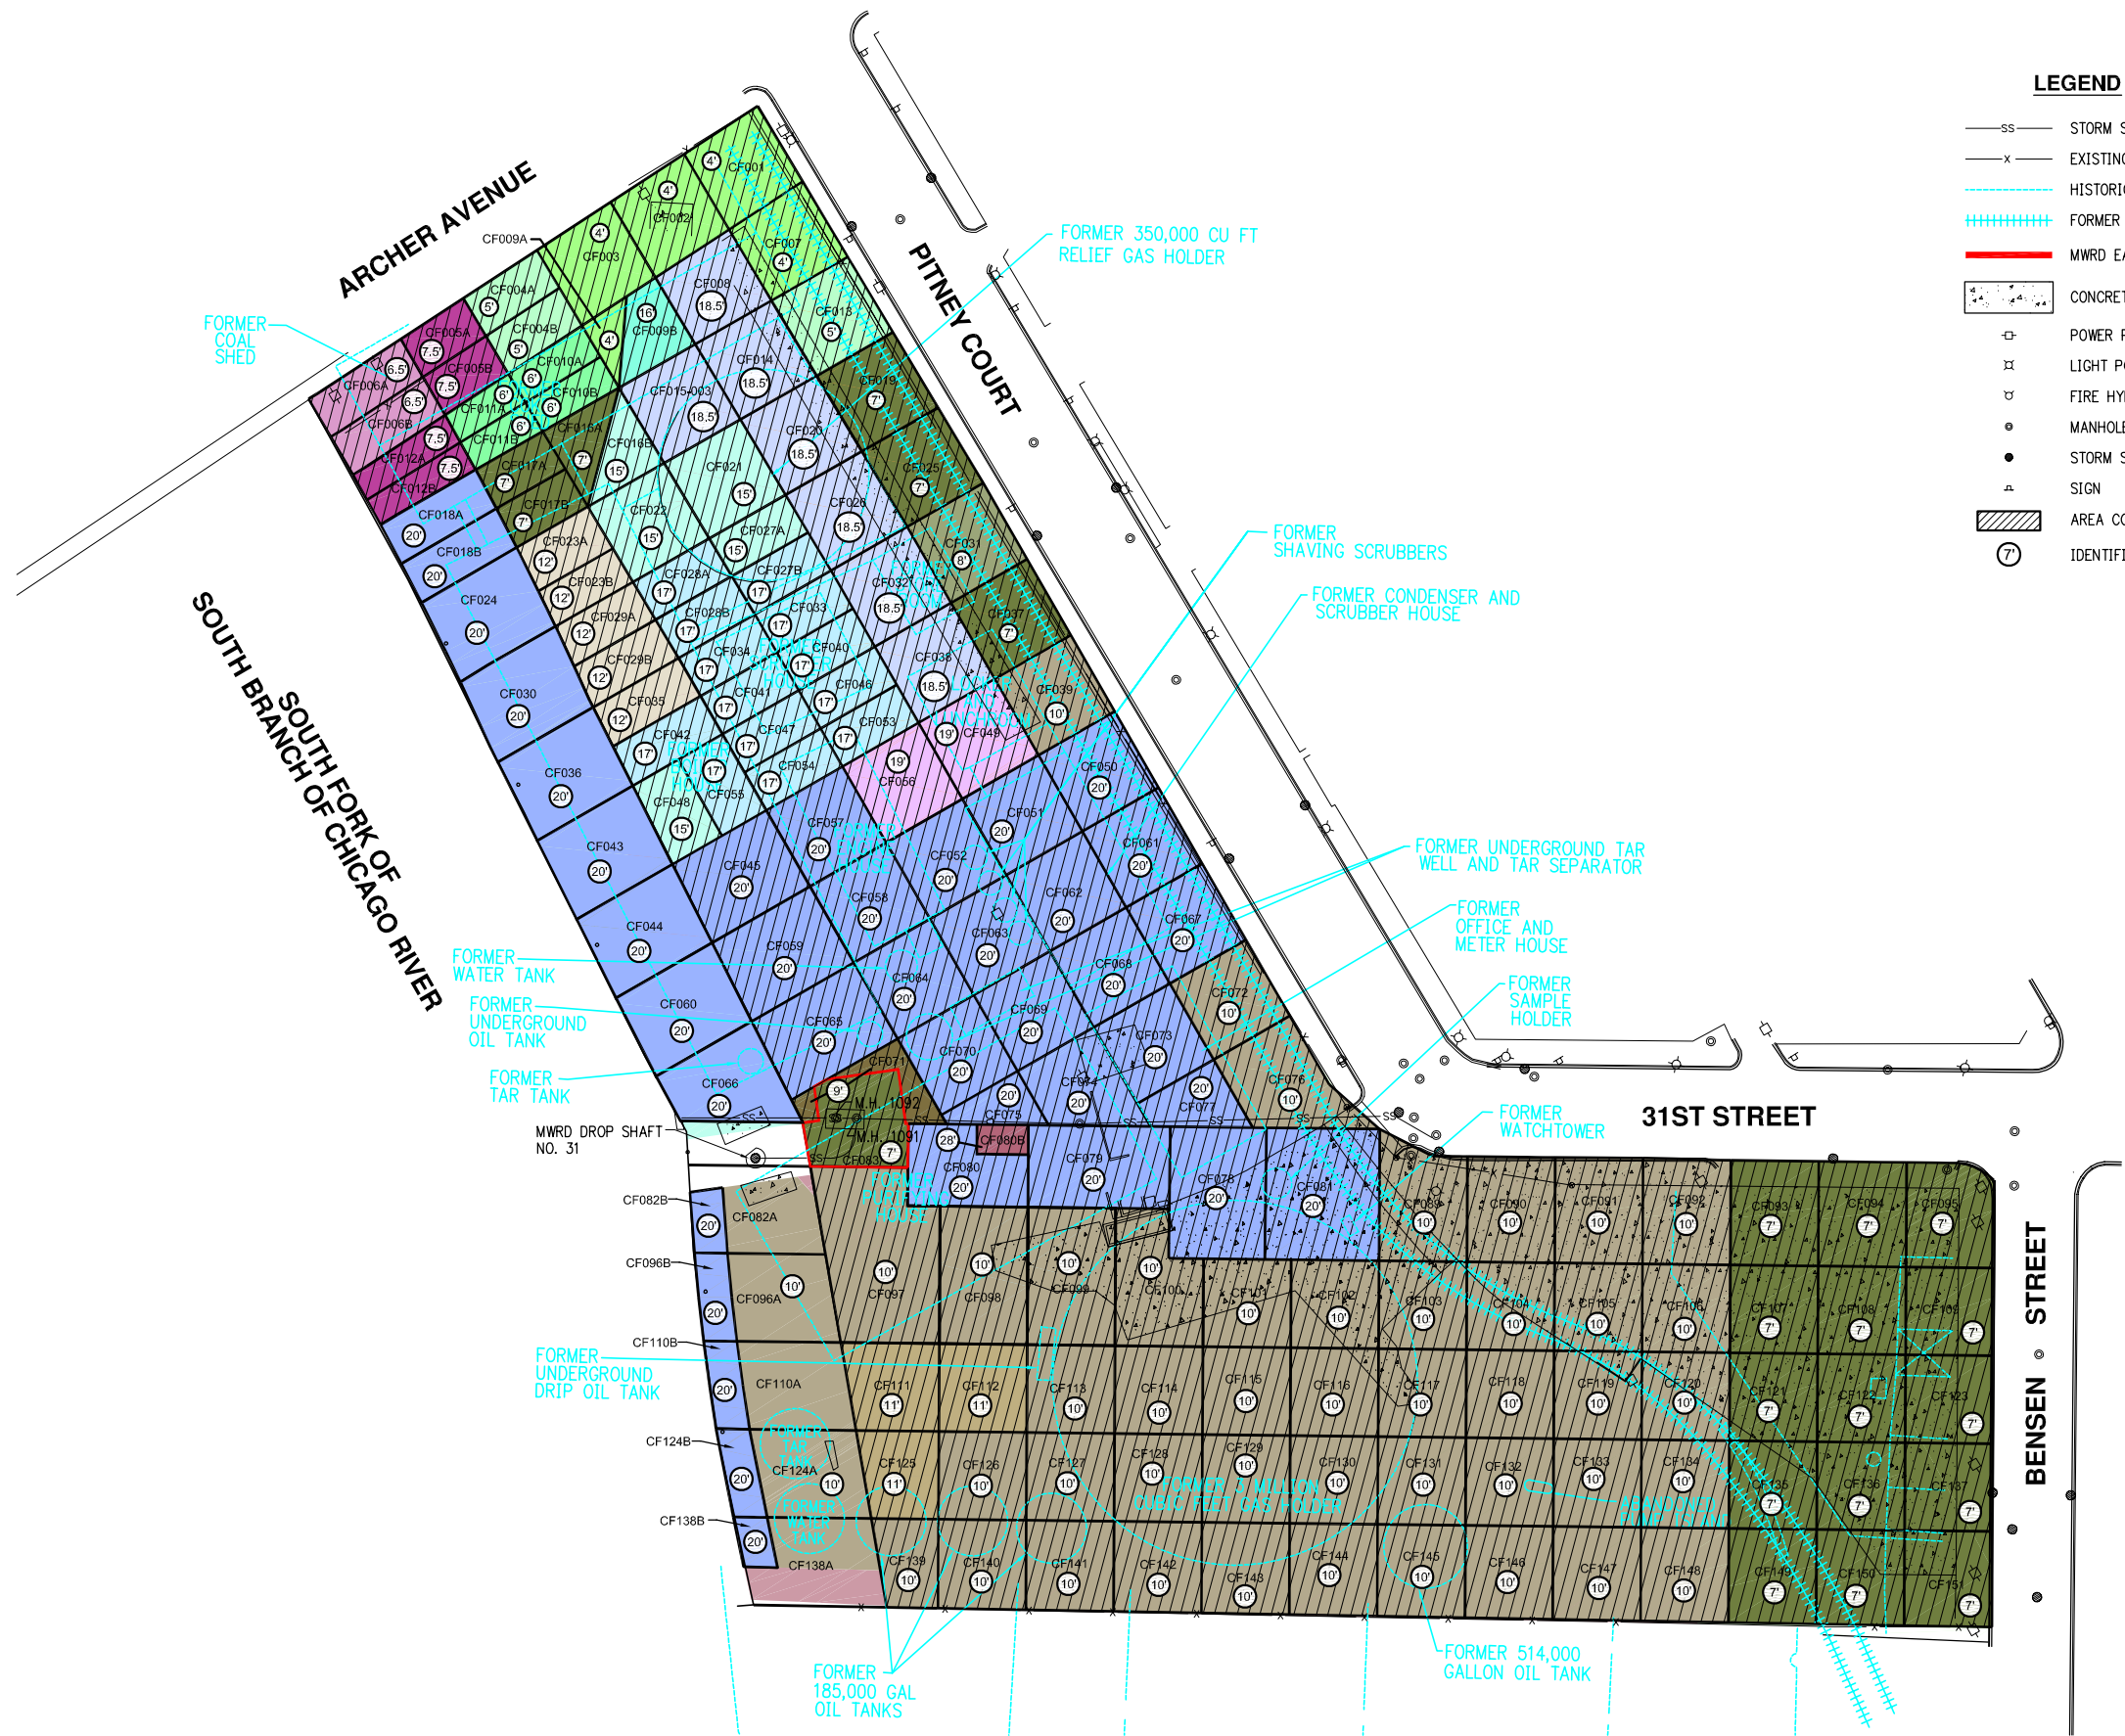

DRAFT

JANUARY 26, 2008


	
date 01-26-08	detailed J. PEREZ
designed A. HANRAHAN	checked
THE PEOPLES GAS LIGHT AND COKE COMPANY CHICAGO, ILLINOIS	
PITNEY COURT 3052 SOUTH PITNEY COURT CHICAGO, ILLINOIS	
Figure 1 AS-BUILT EXCAVATION LAYOUT MAP PITNEY COURT CHICAGO, ILLINOIS	
project 27112	contract
drawing	rev.
sheet 1 of 1 sheets	
file E:\PEOPLES GAS\PITNEY COURT_3052\BROWIN IN PROGRESS\2008-01-26\PITNEY COURT EXCAVATION	





DRAFT


FEBRUARY 02, 2008

	
date 02-02-08	detailed J. PEREZ
designed A. HANRAHAN	checked
THE PEOPLES GAS LIGHT AND COKE COMPANY CHICAGO, ILLINOIS	
PITNEY COURT 3052 SOUTH PITNEY COURT CHICAGO, ILLINOIS	
Figure 1 AS-BUILT EXCAVATION LAYOUT MAP PITNEY COURT CHICAGO, ILLINOIS	
project 27112	contract
drawing	rev.
sheet 1 of 1 sheets	
file EPEOPLES GAS PITNEY COURT_CAD/BENSON IN PROGRESS 2008-02-02 PITNEY COURT EXCAVATION	





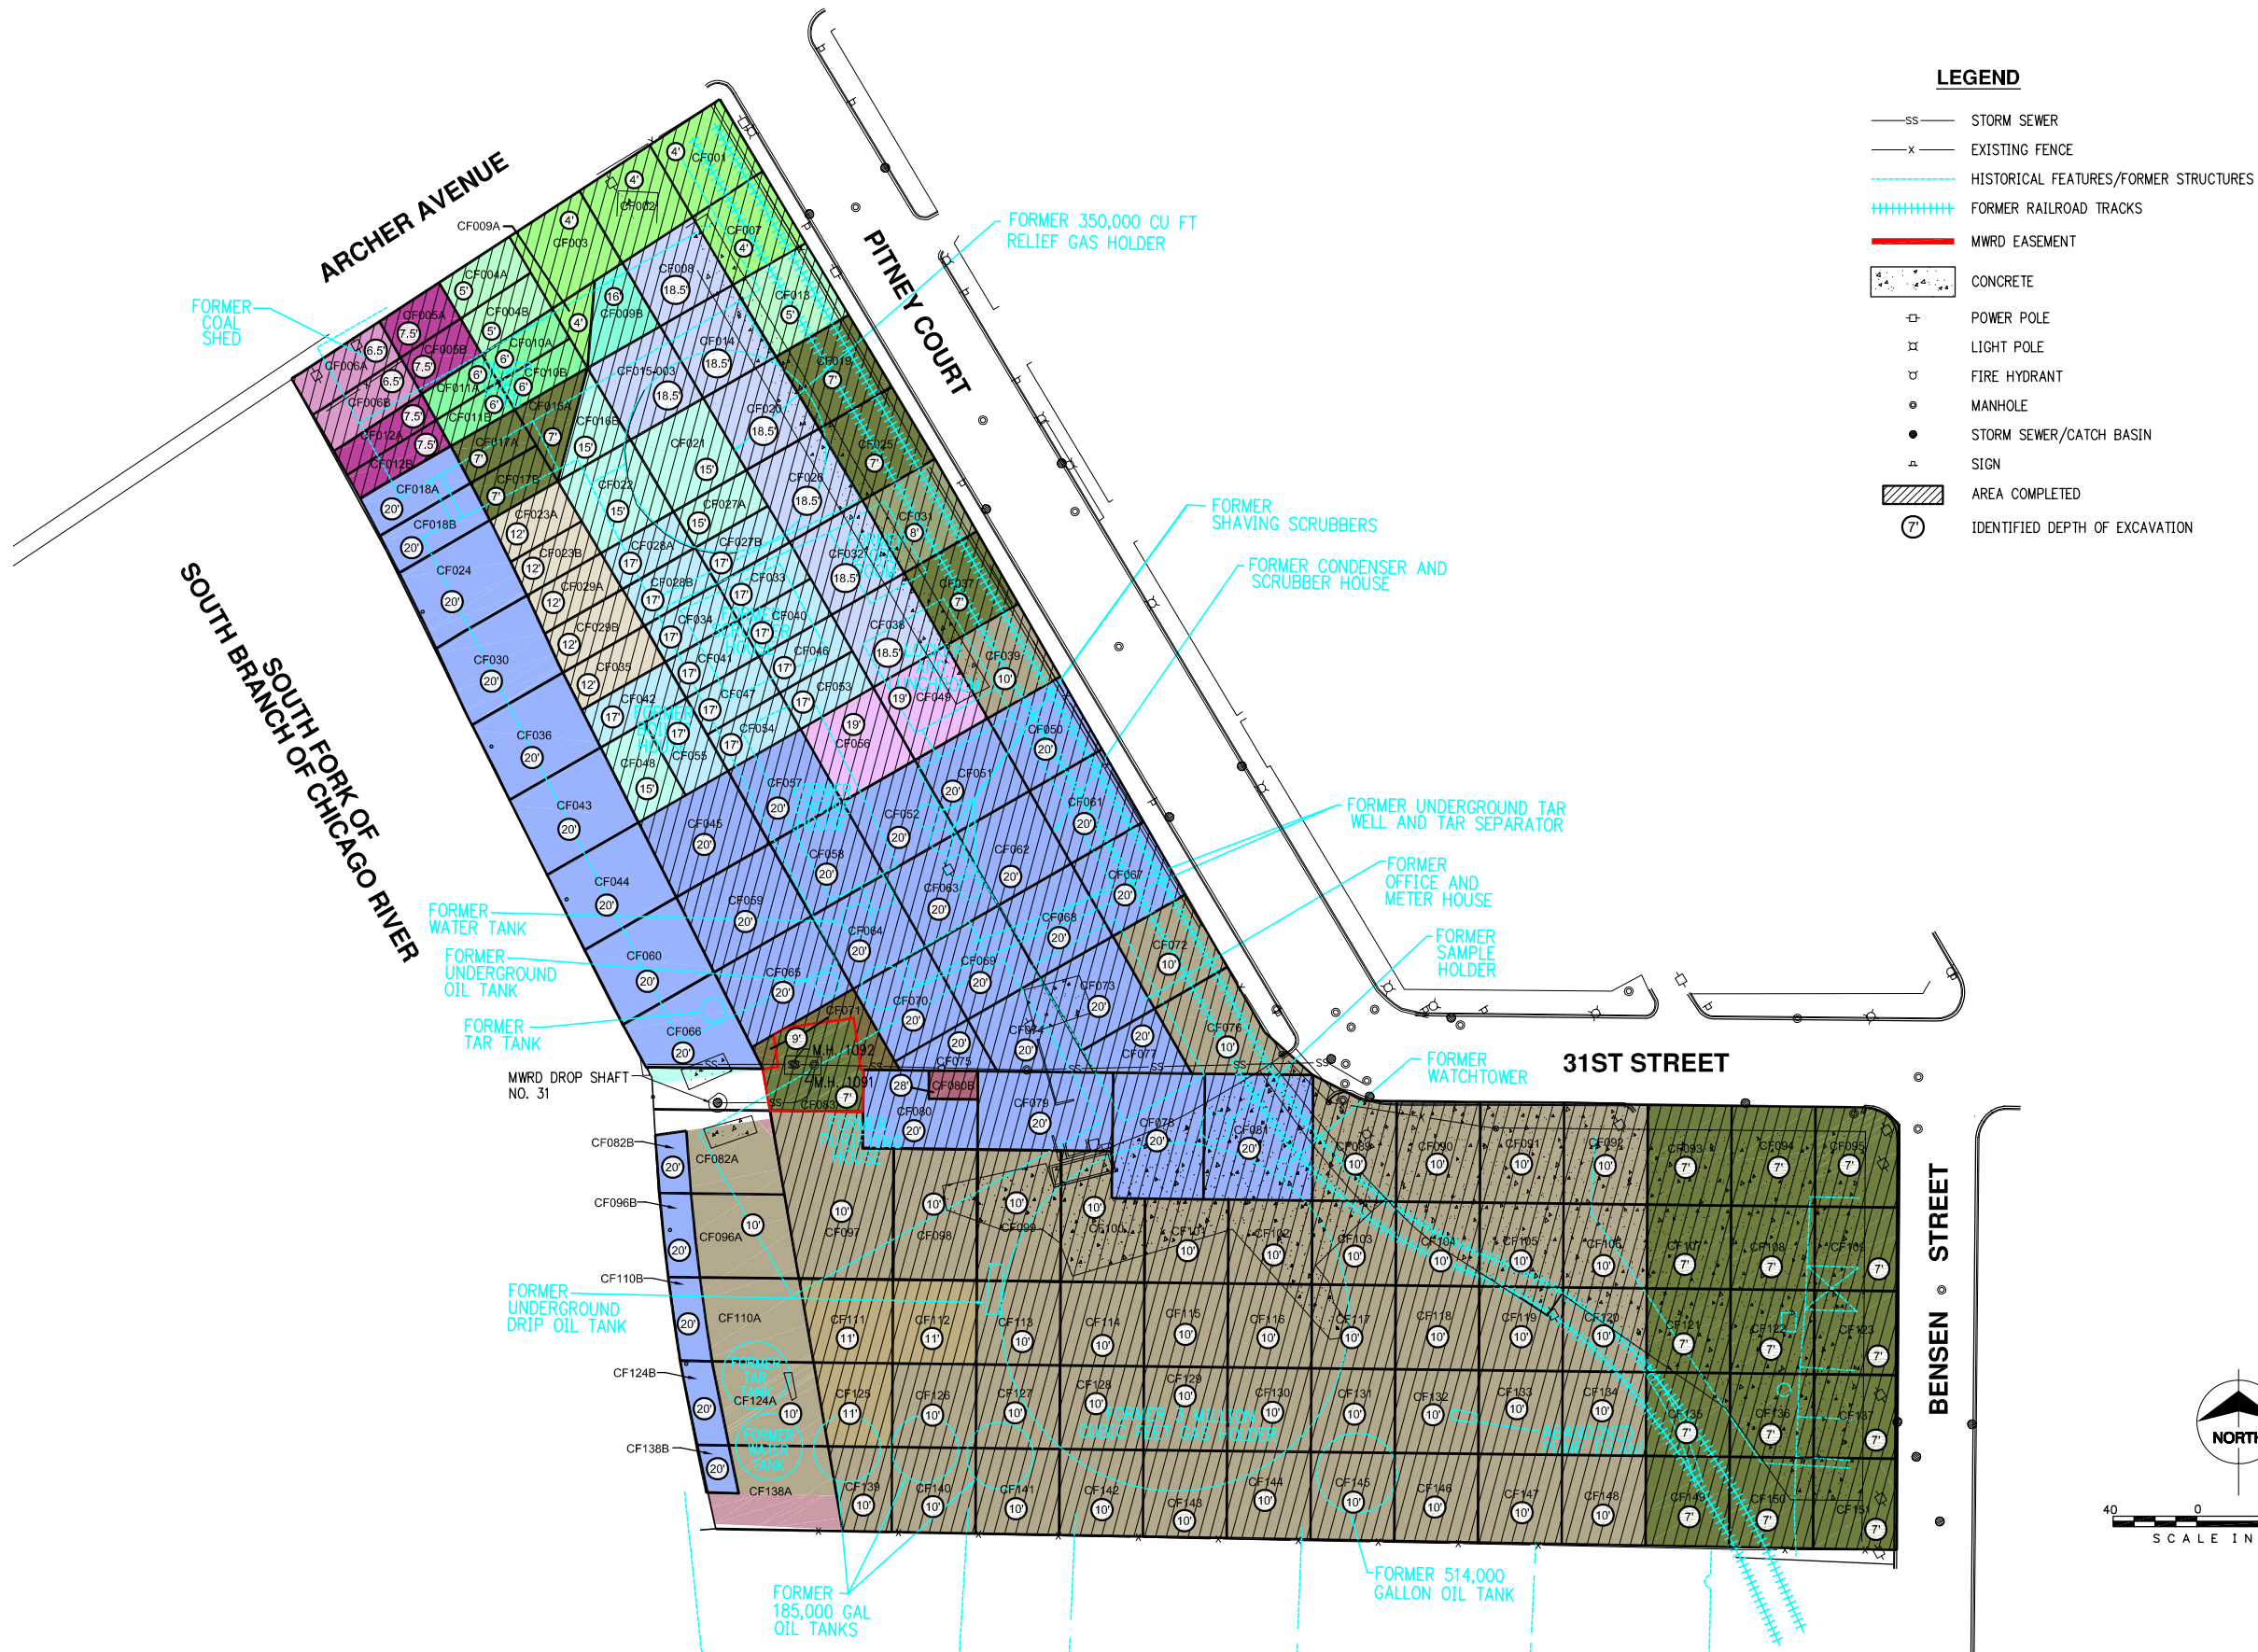


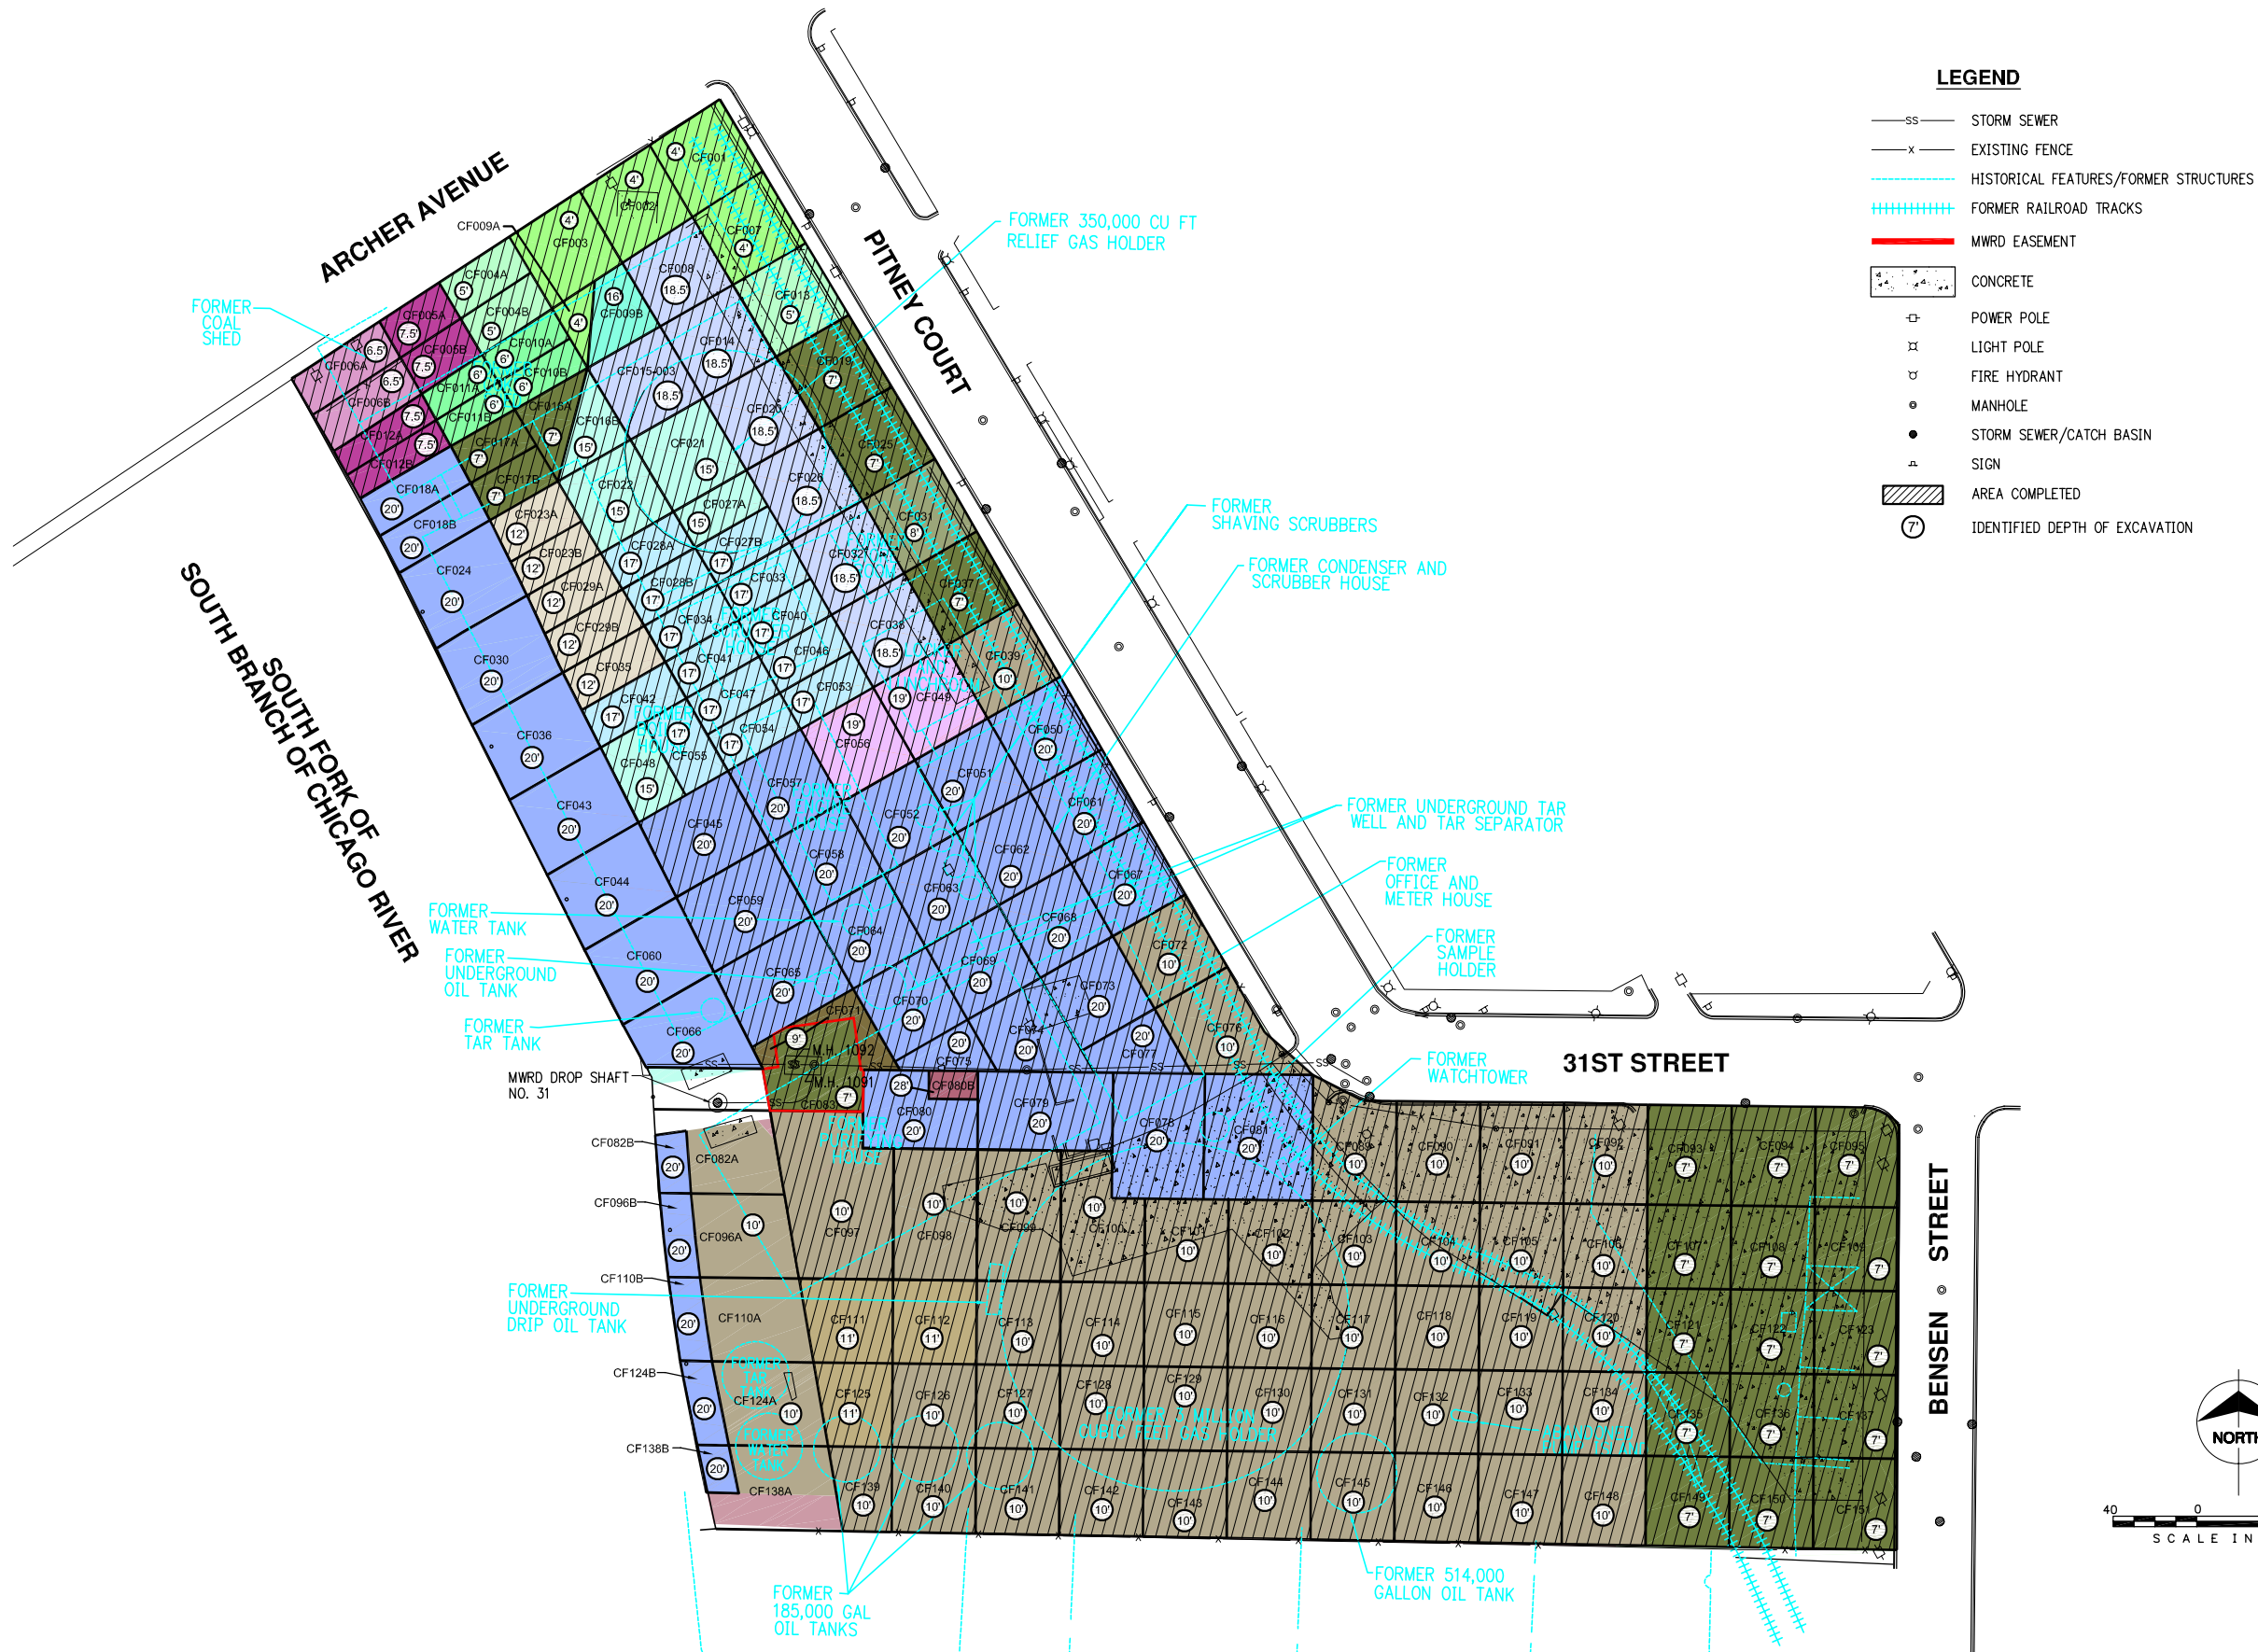


DRAFT

FEBRUARY 16, 2008

	
date 02-16-08	detailed J. PEREZ
designed A. HANRAHAN	checked
THE PEOPLES GAS LIGHT AND COKE COMPANY CHICAGO, ILLINOIS	
PITNEY COURT 3052 SOUTH PITNEY COURT CHICAGO, ILLINOIS	
Figure 1 AS-BUILT EXCAVATION LAYOUT MAP PITNEY COURT CHICAGO, ILLINOIS	
project 27112	contract
drawing	rev.
sheet 1 of 1 sheets	
file:PEOPLES GAS/PITNEY COURT_CAD/WORK IN PROGRESS/2008-02-16/PITNEY COURT EXCAVATION	





LEGEND

- SS STORM SEWER
- X EXISTING FENCE
- HISTORICAL FEATURES/FORMER STRUCTURES
- ===== FORMER RAILROAD TRACKS
- MWRD EASEMENT
- CONCRETE
- POWER POLE
- LIGHT POLE
- FIRE HYDRANT
- MANHOLE
- STORM SEWER/CATCH BASIN
- SIGN
- AREA COMPLETED
- IDENTIFIED DEPTH OF EXCAVATION



40 0 40 80  
SCALE IN FEET

DRAFT

FEBRUARY 23, 2008



date	02-23-08	detailed	J. PEREZ
designed	A. HANRAHAN	checked	

THE PEOPLES GAS LIGHT  
AND COKE COMPANY  
CHICAGO, ILLINOIS

PITNEY COURT  
3052 SOUTH PITNEY COURT  
CHICAGO, ILLINOIS


Figure 1  
AS-BUILT EXCAVATION LAYOUT MAP  
PITNEY COURT  
CHICAGO, ILLINOIS

project	27112	contract	
drawing		rev.	

sheet 1 of 1 sheets

file EPEOPLES GAS/PITNEY COURT\_CAD/BENSON IN PROGRESS/2008-02-23/PITNEY COURT EXCAVATION



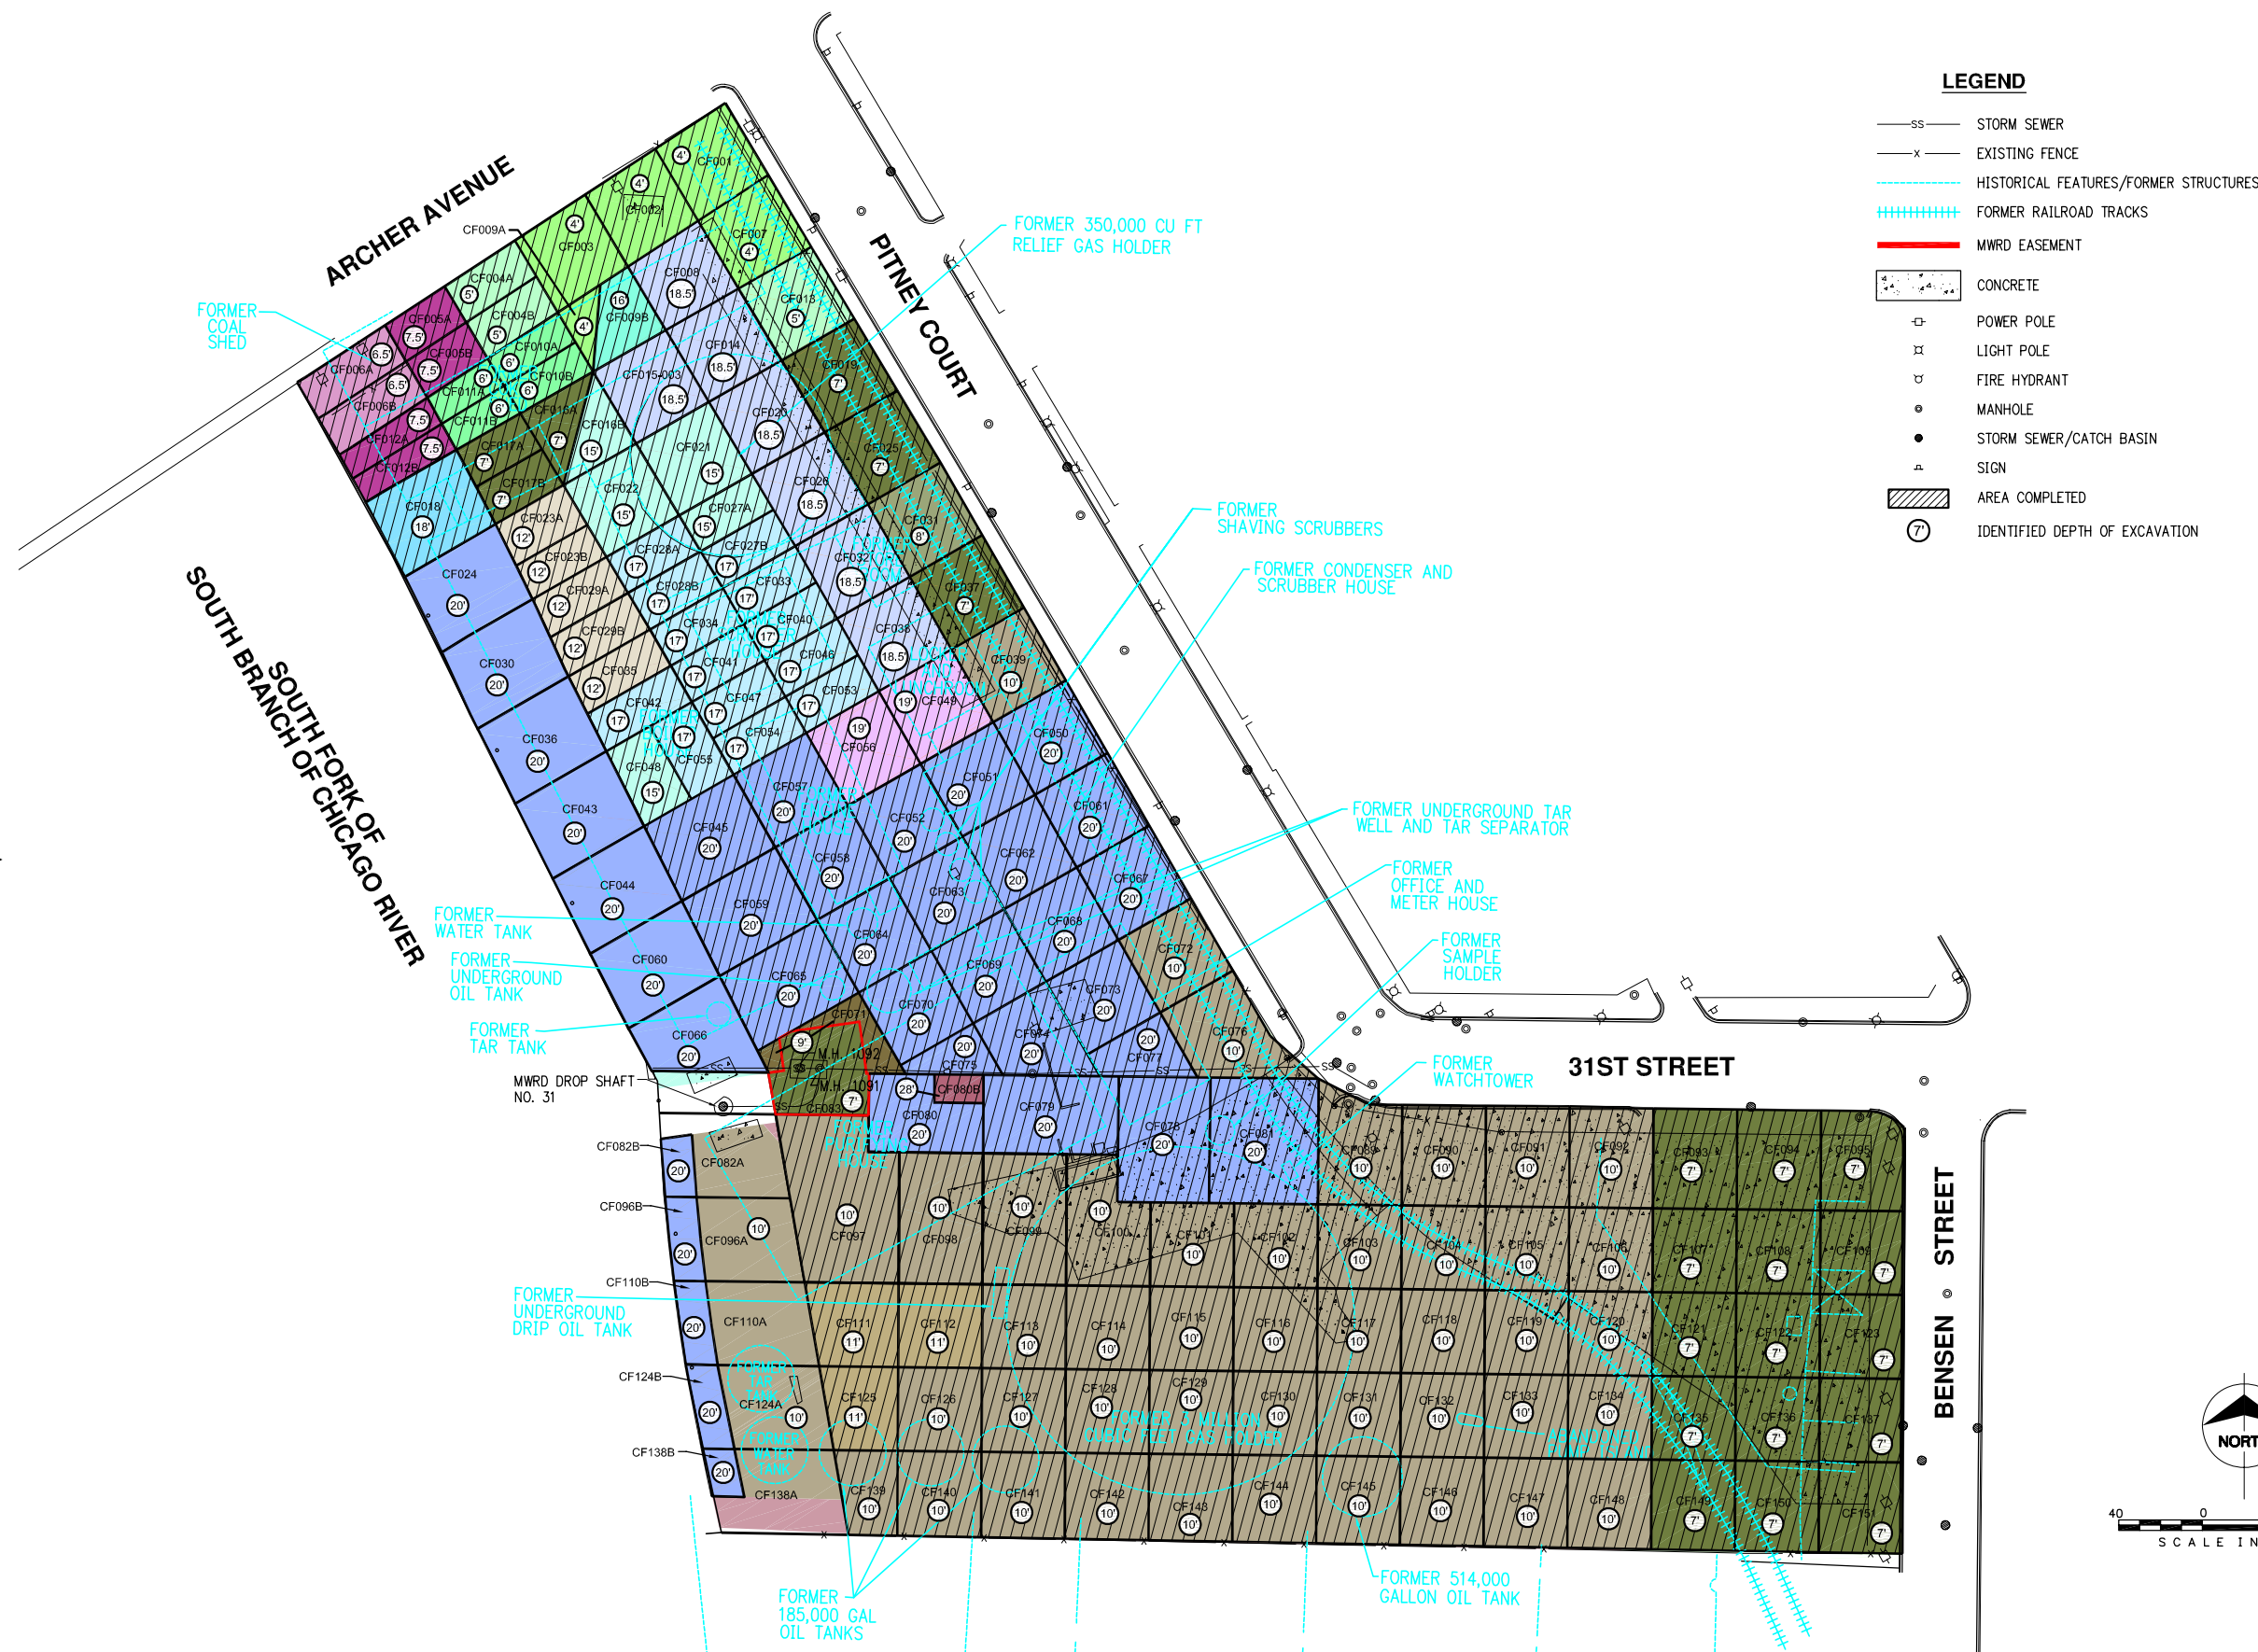

**DRAFT**

**MARCH 01, 2008**

no.	date	by	ckd	description
-----	------	----	-----	-------------



date 03-01-08	detailed J. PEREZ
designed A. HANRAHAN	checked

THE PEOPLES GAS LIGHT  
AND COKE COMPANY  
CHICAGO, ILLINOIS


PITNEY COURT  
3052 SOUTH PITNEY COURT  
CHICAGO, ILLINOIS

Figure 1  
AS-BUILT EXCAVATION LAYOUT MAP  
PITNEY COURT  
CHICAGO, ILLINOIS

CHICAGO, ILLINOIS	
project 27112	contract
drawing	rev.

sheet	1	of	1	sheets
file \\PEOPLES GAS\PINEY COURT_CAD\BID\WORK IN PROGRESS\2008-03-01 PINEY COURT EXCAVATION				



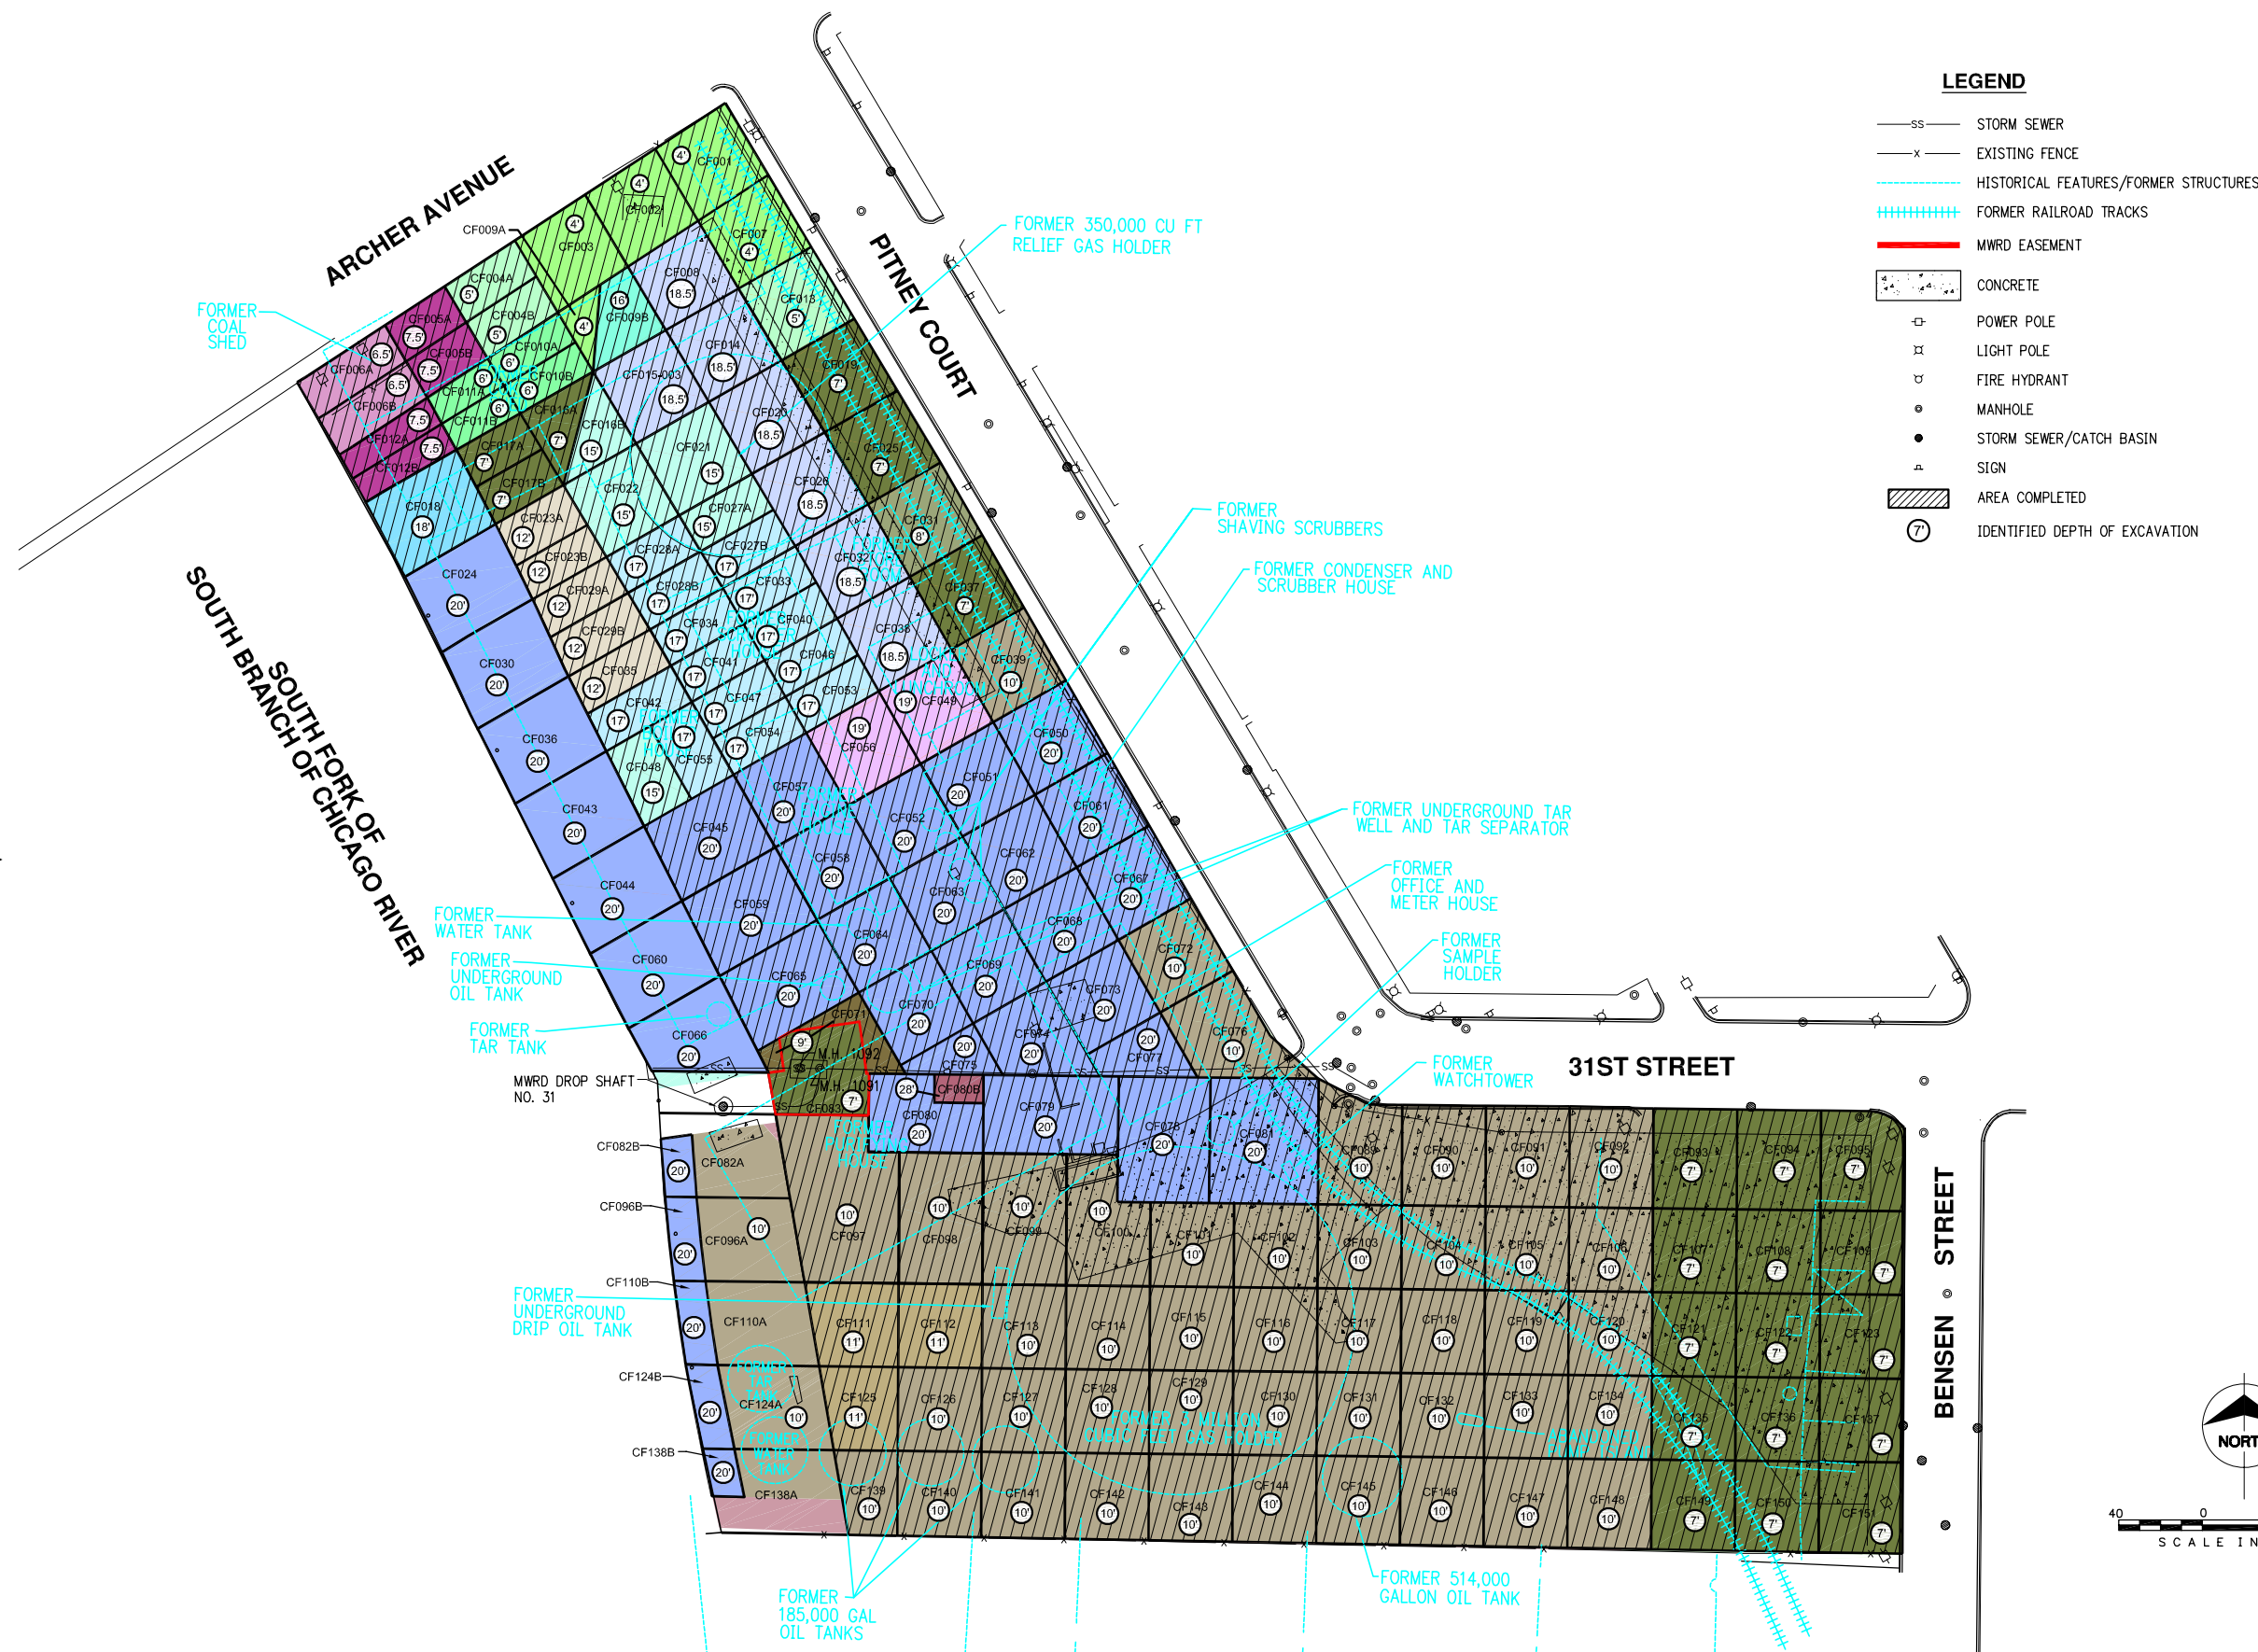


**DRAFT**

**MARCH 08, 2008**

no.	date	by	ckd	description
-----	------	----	-----	-------------

	
date	desailed
03-08-08	J. PEREZ
designed	checked
A. HANRAHAN	

THE PEOPLES GAS LIGHT  
AND COKE COMPANY  
CHICAGO, ILLINOIS


PITNEY COURT  
3052 SOUTH PITNEY COURT  
CHICAGO, ILLINOIS

Figure 1

AS-BUILT EXCAVATION LAYOUT MAP  
PITNEY COURT  
CHICAGO, ILLINOIS

project	contract	
27112		
drawing	rev.	
<div style="width: 50px; height: 10px; background-color: black; margin: 0 auto;"></div>		
sheet 1	of 1	sheets
file \\PEOPLES.GAS\PITNEY COURT_ICAD\BIDWORK\INPROGRESS\2009-01-09 PITNEY COURT EXCAVATION		



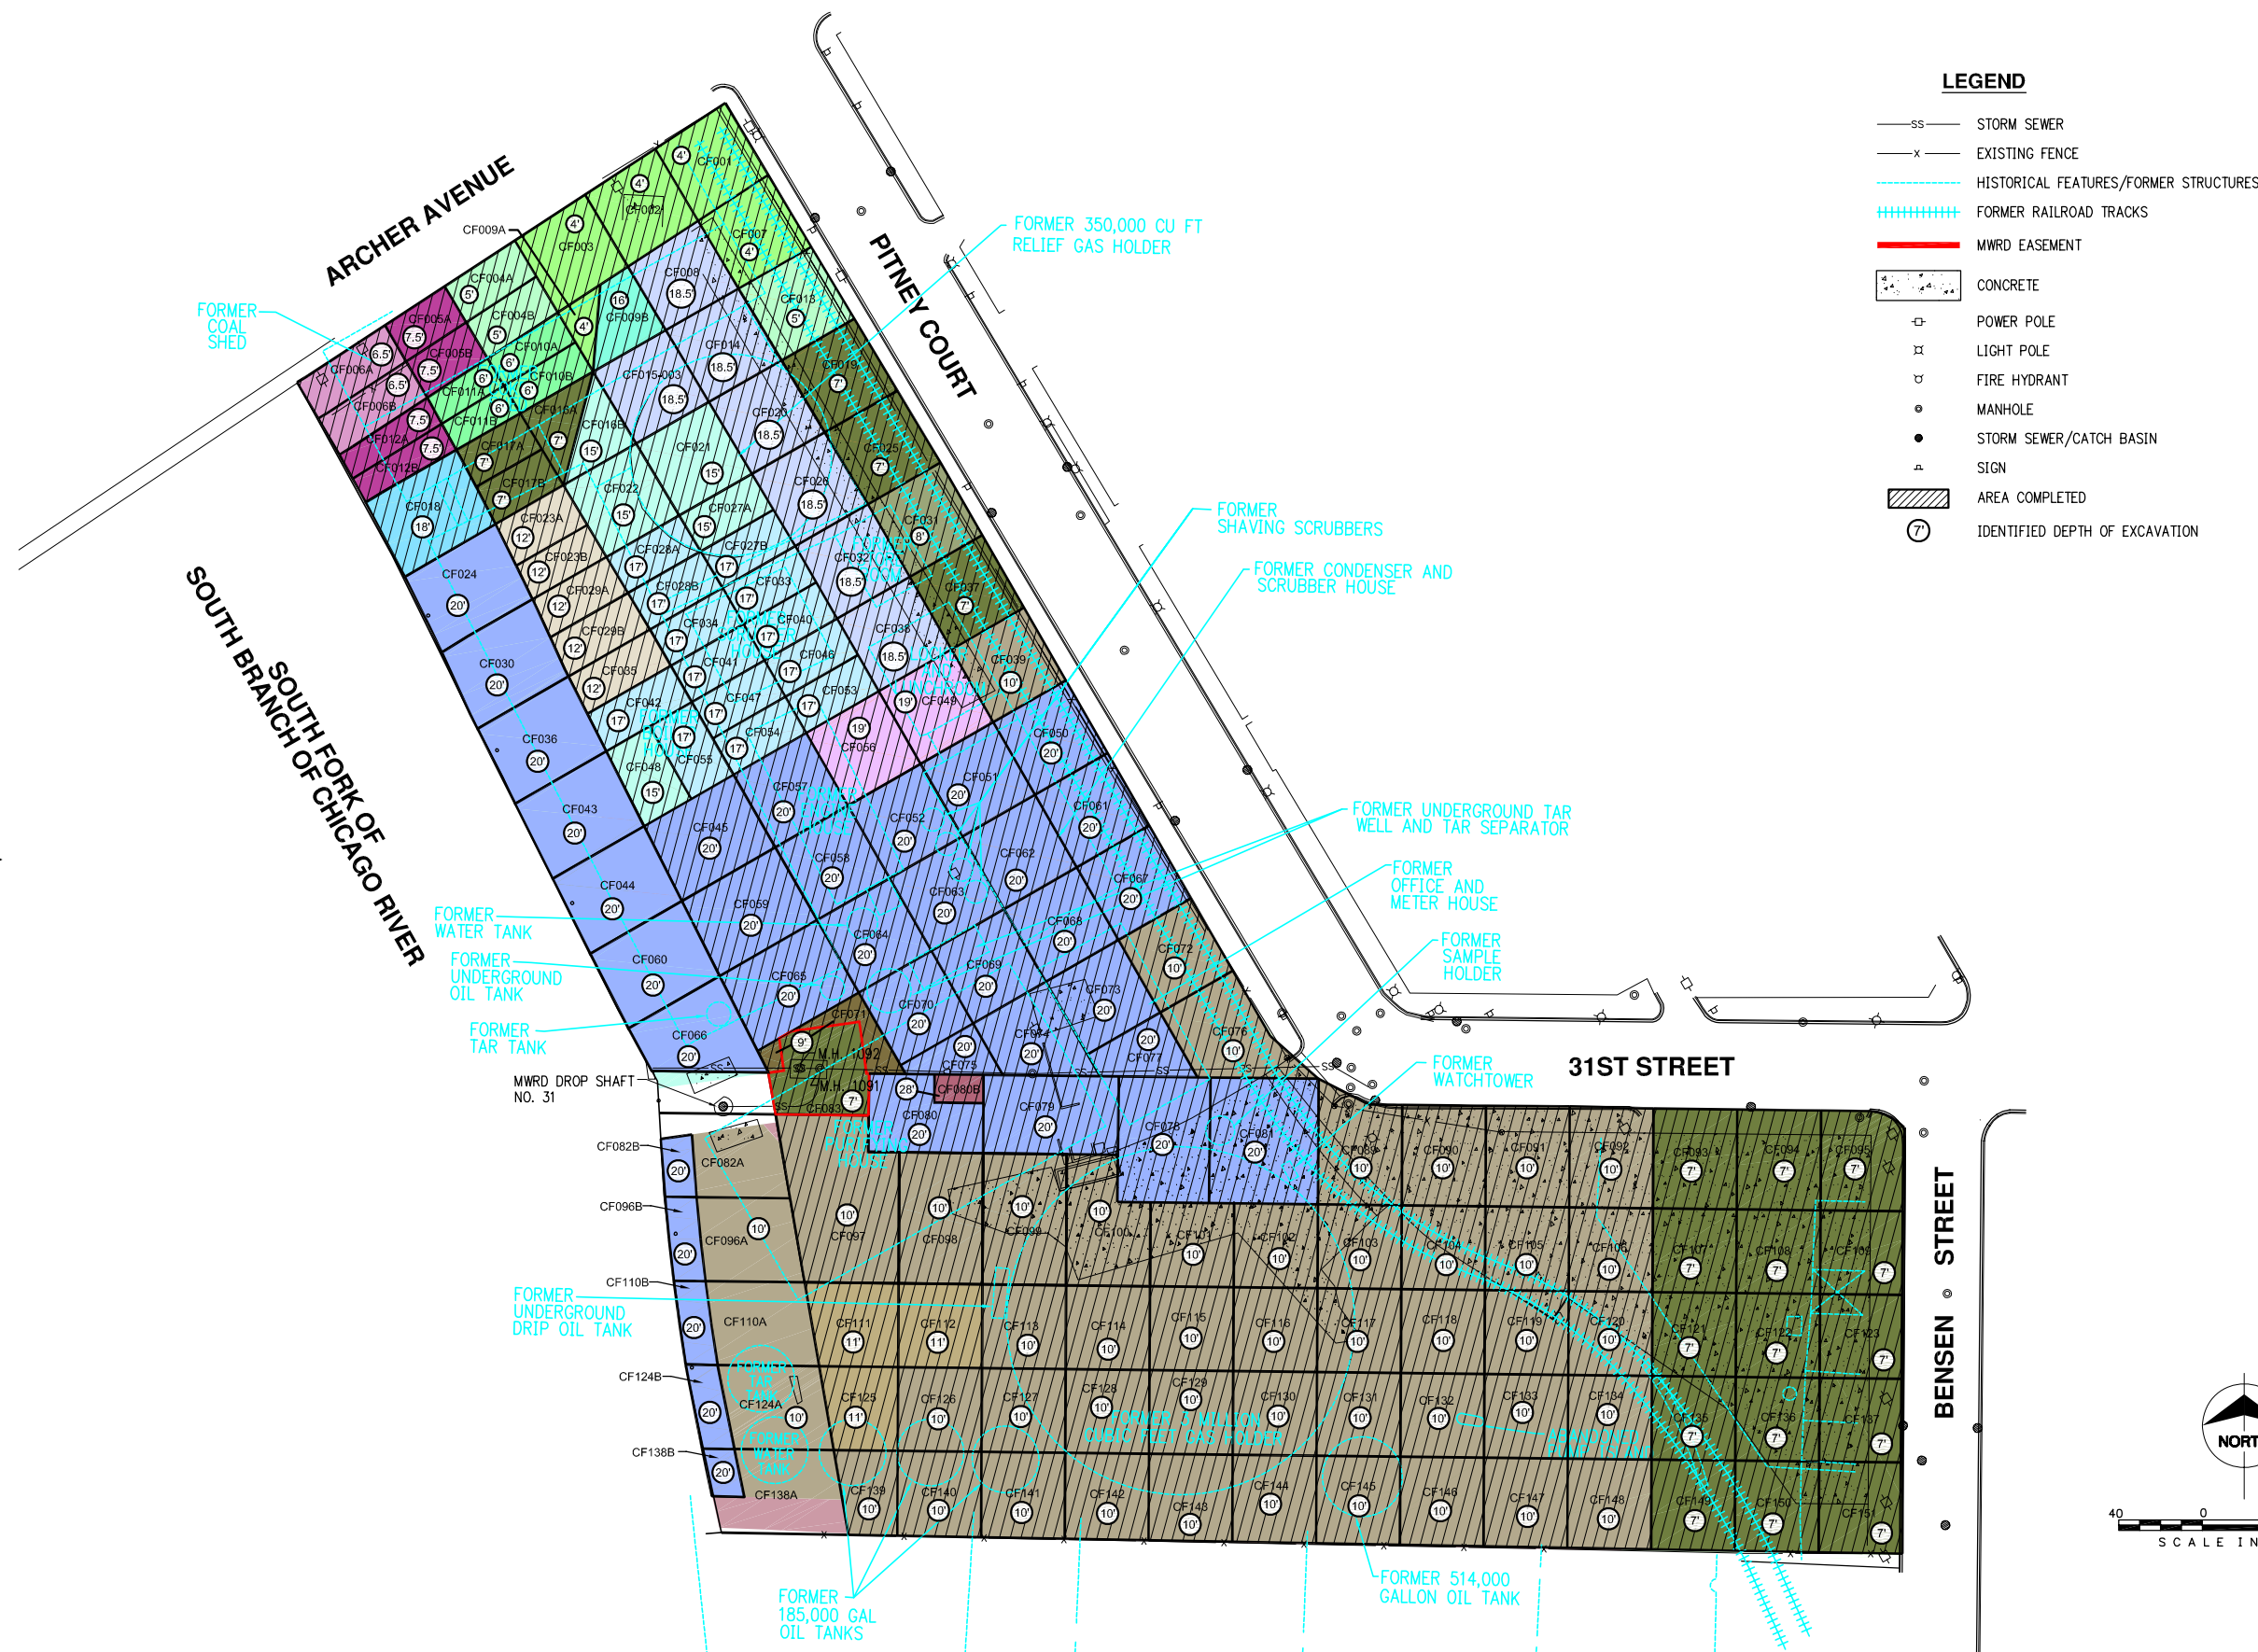




**DRAFT**

**MARCH 15, 2008**

no.	date	by	ckd	description
-----	------	----	-----	-------------

	
date 03-15-08	detailed J. PEREZ
designed A. HANRAHAN	checked
<p>THE PEOPLES GAS LIGHT AND COKE COMPANY CHICAGO, ILLINOIS</p> <p>PITNEY COURT 3052 SOUTH PITNEY COURT CHICAGO, ILLINOIS</p>	
<p>Figure 1</p> <p>AS-BUILT EXCAVATION LAYOUT MAP PITNEY COURT CHICAGO, ILLINOIS</p>	
project 27112	contract
drawing	rev.
<div style="text-align: center;">  </div>	
sheet 1	of 1 sheets
file \\PEOPLES GAS\PITNEY COURT_CAD\BID\WORK IN PROGRESS\2008-03-15\PITNEY COURT EXCAVATION	



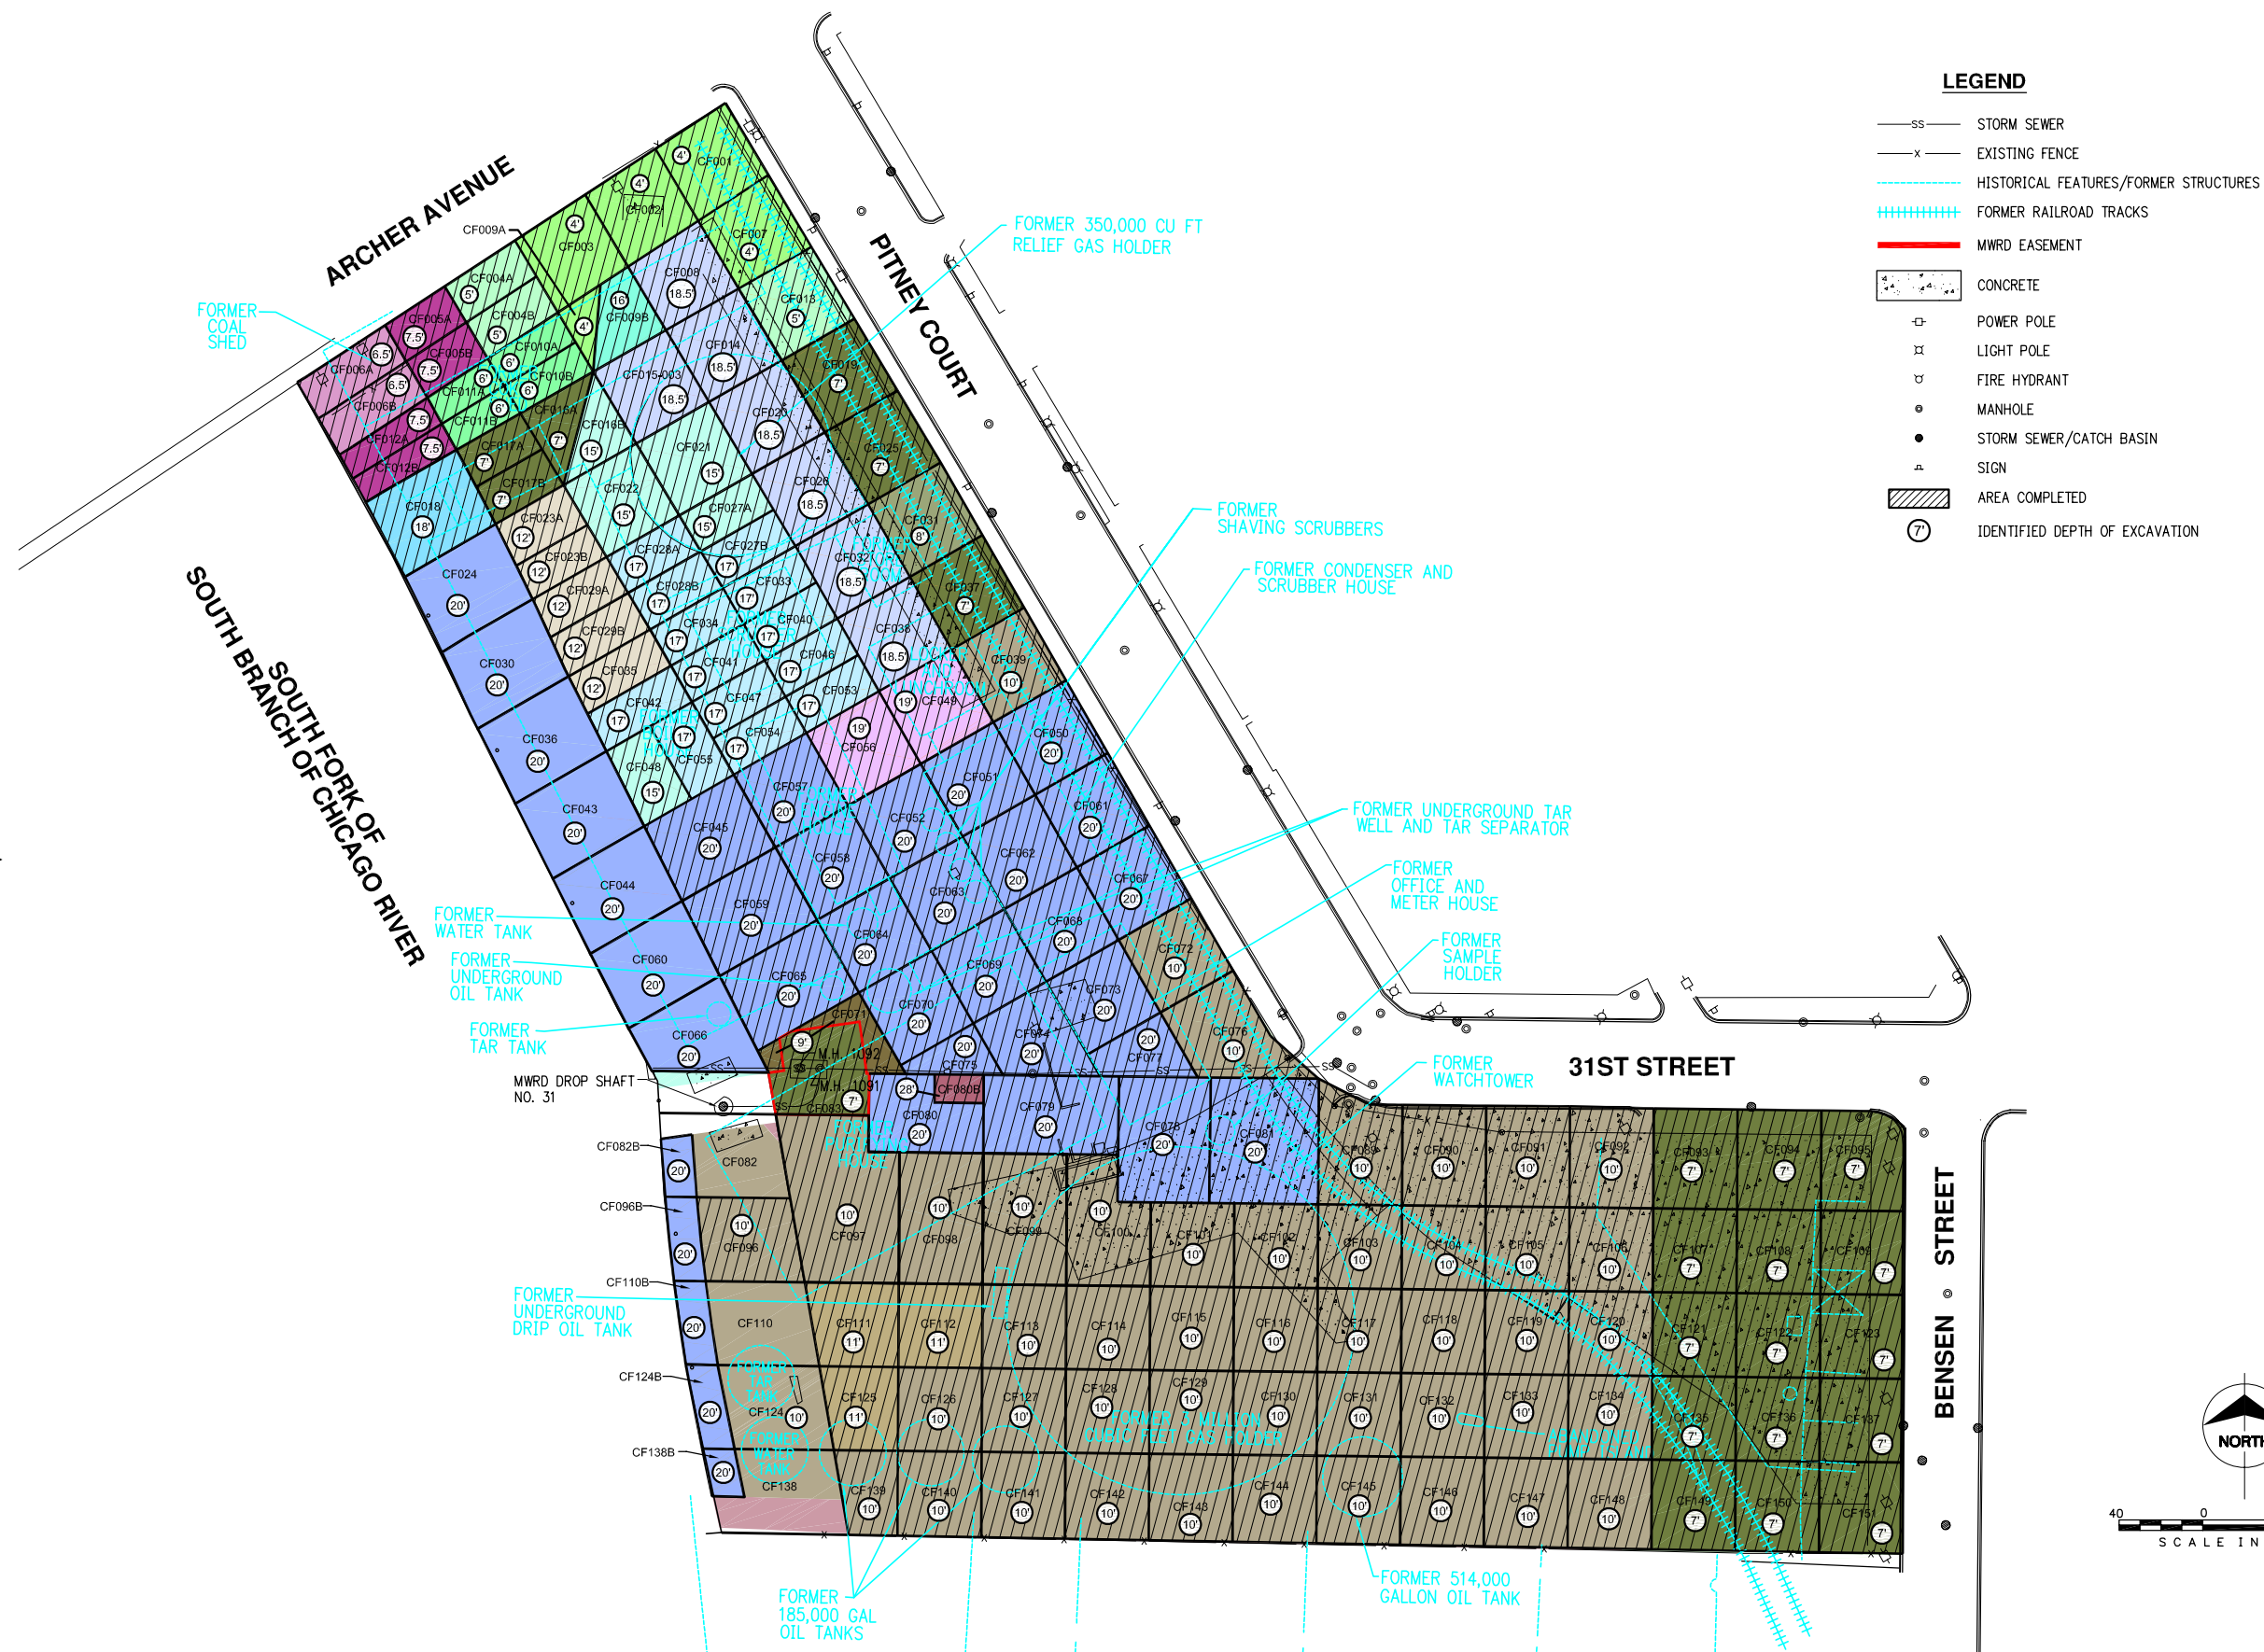

**DRAFT**

**MARCH 22, 2008**

no.	date	by	ckd	description
-----	------	----	-----	-------------



date 03-22-08	detailed J. PEREZ
designed A. HANRAHAN	checked

THE PEOPLES GAS LIGHT  
AND COKE COMPANY  
CHICAGO, ILLINOIS

PITNEY COURT  
3052 SOUTH PITNEY COURT  
CHICAGO, ILLINOIS

Figure 1  
AS-BUILT EXCAVATION LAYOUT MAP  
PITNEY COURT  
CHICAGO, ILLINOIS


CHICAGO, ILLINOIS	
project 27112	contract
drawing	rev.

sheet	1	of	1	sheets
file \\PEOPLES GAS\PINEY COURT_CAD\BID\WORK IN PROGRESS\2008-03-22 PINEY COURT EXCAVATION				







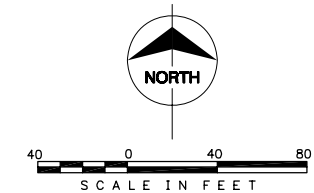

**DRAFT**

**APRIL 05, 2008**



date	04-05-08	detailed	J. PEREZ
designed	A. HANRAHAN	checked	

THE PEOPLES GAS LIGHT  
AND COKE COMPANY  
CHICAGO, ILLINOIS

PITNEY COURT  
3052 SOUTH PITNEY COURT  
CHICAGO, ILLINOIS


Figure 1  
AS-BUILT EXCAVATION LAYOUT MAP  
PITNEY COURT  
CHICAGO, ILLINOIS

project	27112	contract	
drawing		rev.	

sheet 1 of 1 sheets

file EPEOPLES GAS/PITNEY COURT\_CAD/BENJAMIN IN PROGRESS/2008-04-05 PITNEY COURT EXCAVATION



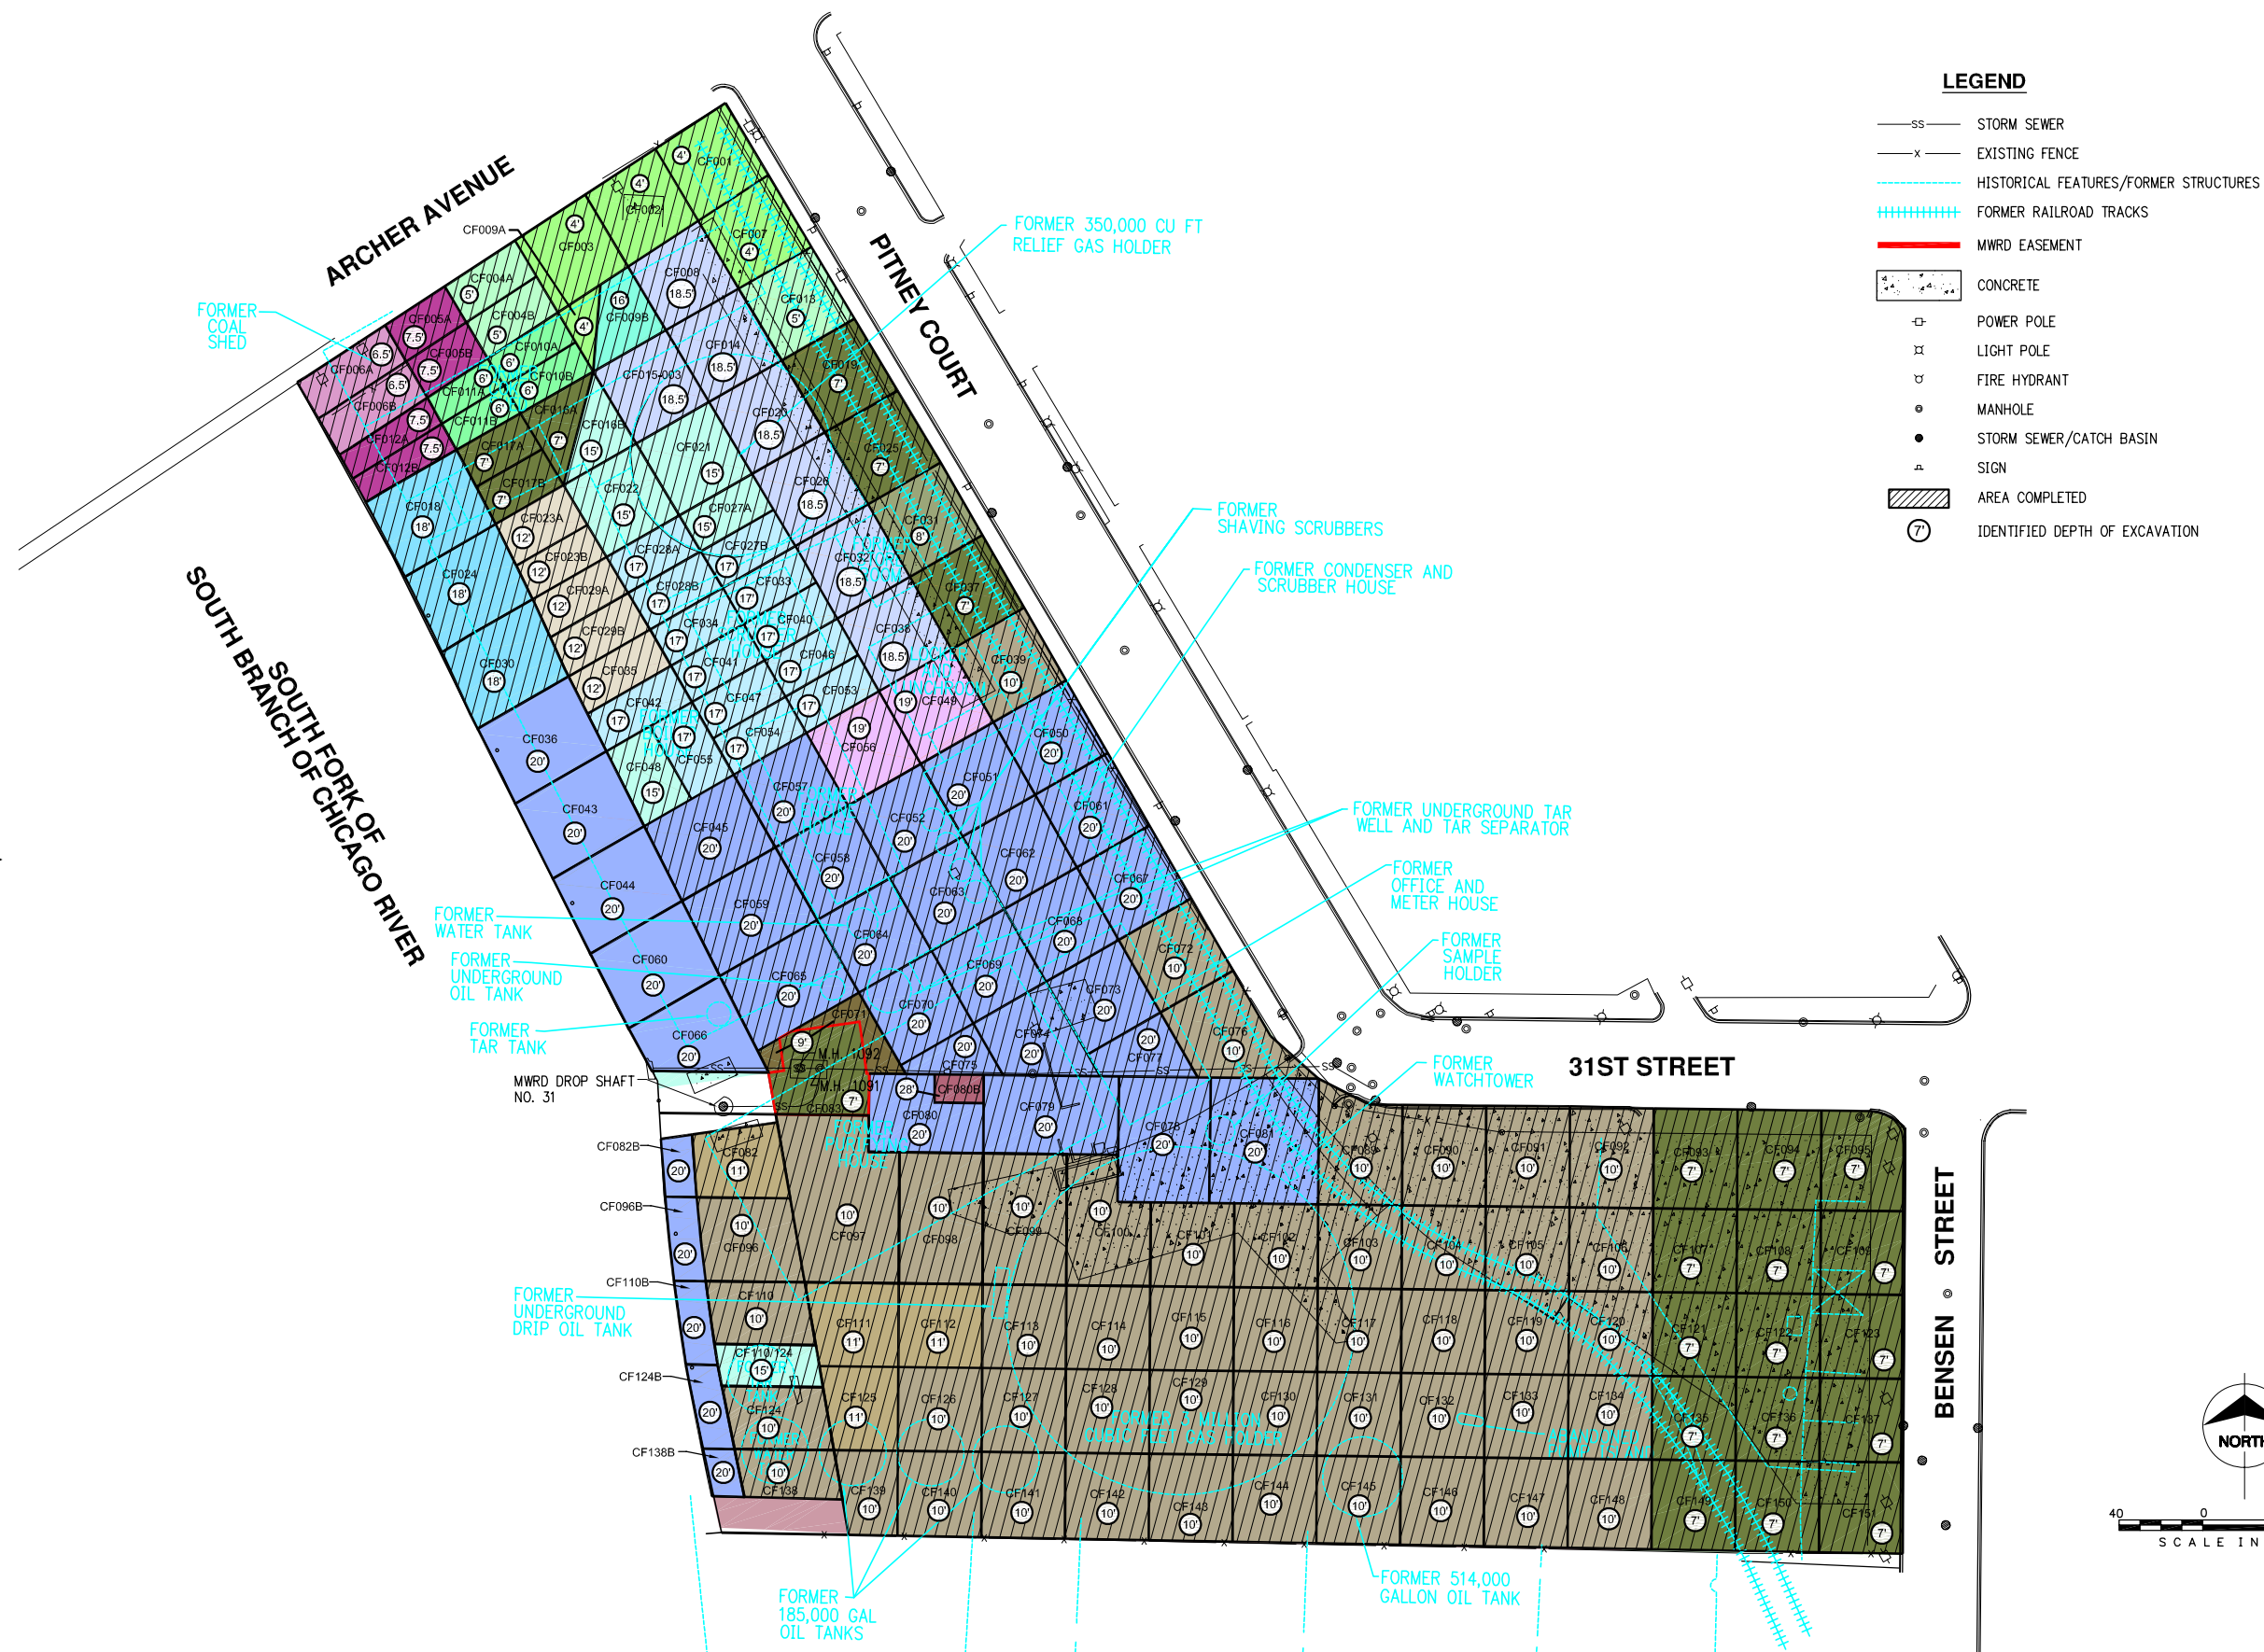


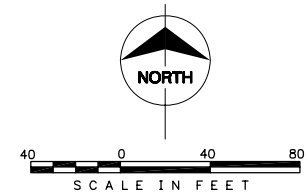
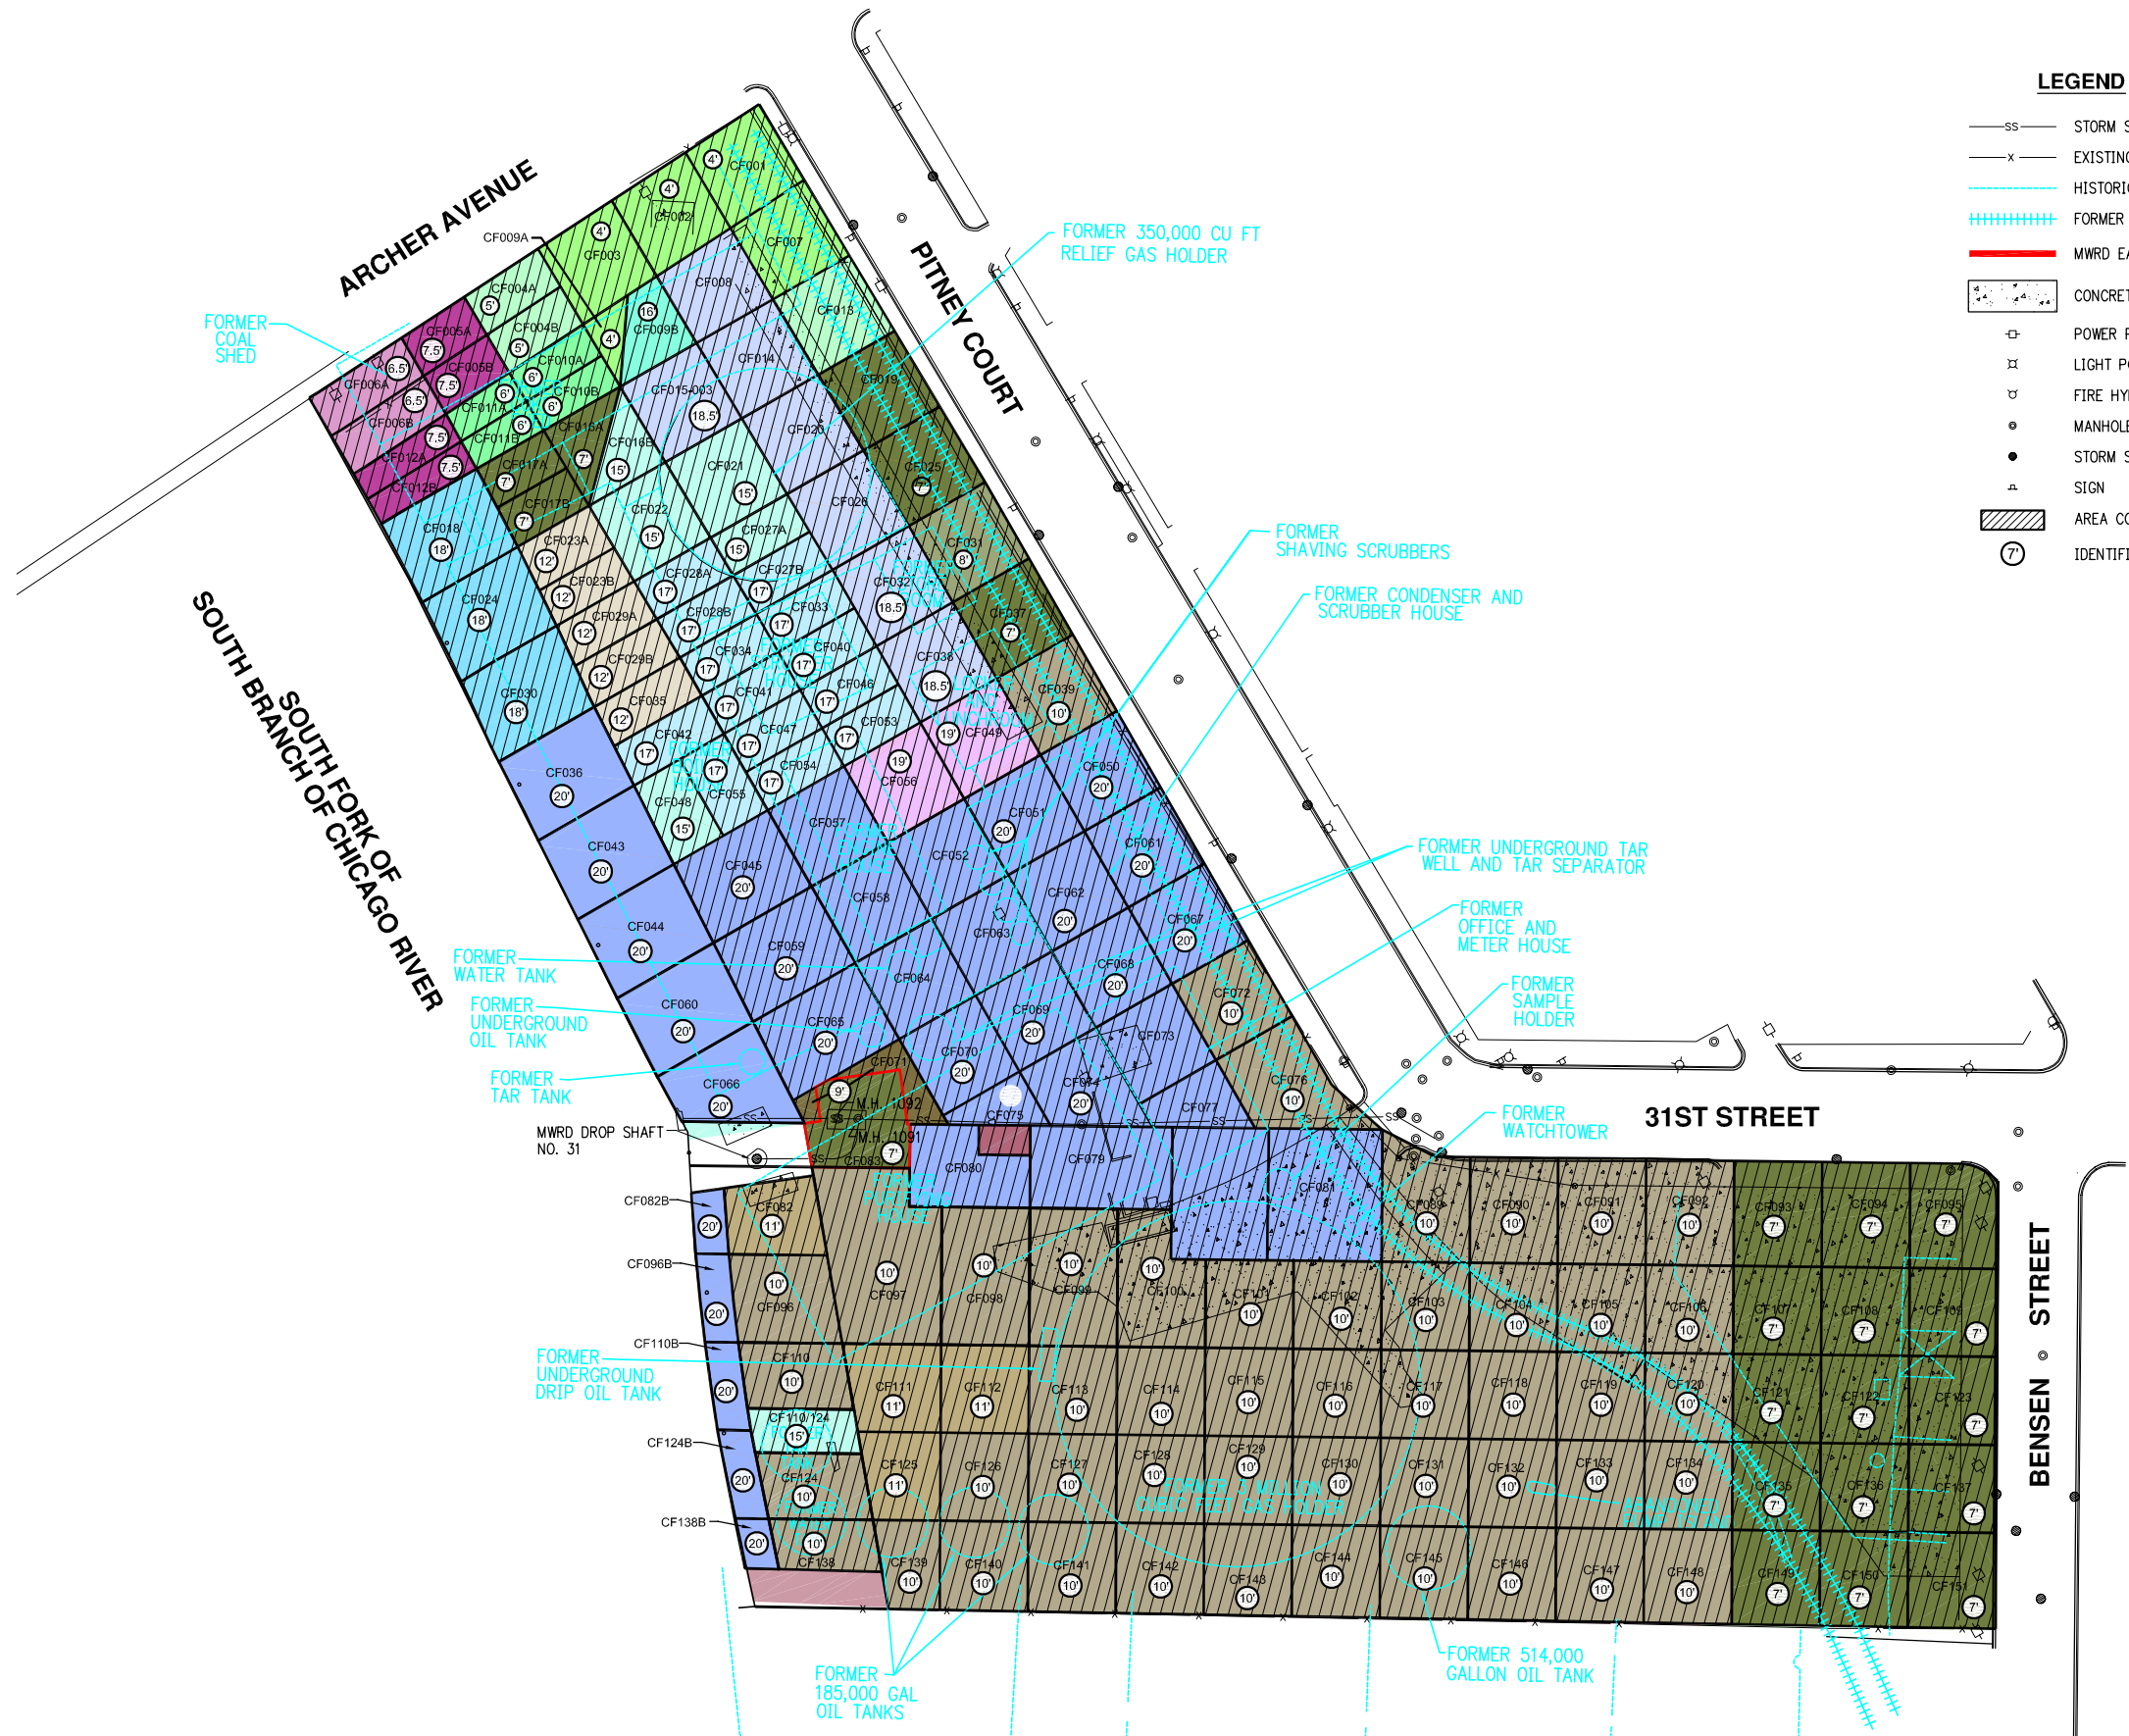
**DRAFT**

**APRIL 12, 2008**

no.	date	by	ckd	description
-----	------	----	-----	-------------

	
date <div style="text-align: center; font-size: 1.2em;">04-12-08</div>	detailed <div style="text-align: center; font-size: 1.2em;">J. PEREZ</div>
designed <div style="text-align: center; font-size: 1.2em;">A. HANRAHAN</div>	checked 
<div style="font-size: 1.5em; font-weight: bold; line-height: 1.2;">             THE PEOPLES GAS LIGHT              AND COKE COMPANY              CHICAGO, ILLINOIS           </div> <div style="font-size: 1.5em; font-weight: bold; line-height: 1.2; margin-top: 20px;">             PITNEY COURT              3052 SOUTH PITNEY COURT              CHICAGO, ILLINOIS           </div>	
Figure 1 AS-BUILT EXCAVATION LAYOUT MAP PITNEY COURT CHICAGO, ILLINOIS	
project <div style="text-align: center; font-size: 1.2em;">27112</div>	contract 
<div style="display: flex; justify-content: space-between;"> <span>drawing</span> <span>rev.</span> </div>	
<div style="width: 50px; height: 10px; background-color: black; margin: 0 auto;"></div>	
<div style="display: flex; justify-content: space-between;"> <span>sheet 1</span> <span>of 1</span> <span>sheets</span> </div>	
<small>file \PEOPLES GAS\PITNEY COURT - 1\AS-BUILD\WORK IN PROGRESS\2008-04-12\PITNEY COURT EXCAVATION</small>	





**DRAFT**

**APRIL 19, 2008**



date	04-19-08	detailed	J. PEREZ
designed	A. HANRAHAN	checked	

THE PEOPLES GAS LIGHT  
AND COKE COMPANY  
CHICAGO, ILLINOIS

PITNEY COURT  
3052 SOUTH PITNEY COURT  
CHICAGO, ILLINOIS


Figure 1  
AS-BUILT EXCAVATION LAYOUT MAP  
PITNEY COURT  
CHICAGO, ILLINOIS

project	27112	contract	
drawing		rev.	


sheet	1	of	1	sheets
-------	---	----	---	--------

file: E:\PEOPLES GAS\PITNEY COURT\_CAD\BROWER IN PROGRESS\2008-04-19\PITNEY COURT EXCAVATION



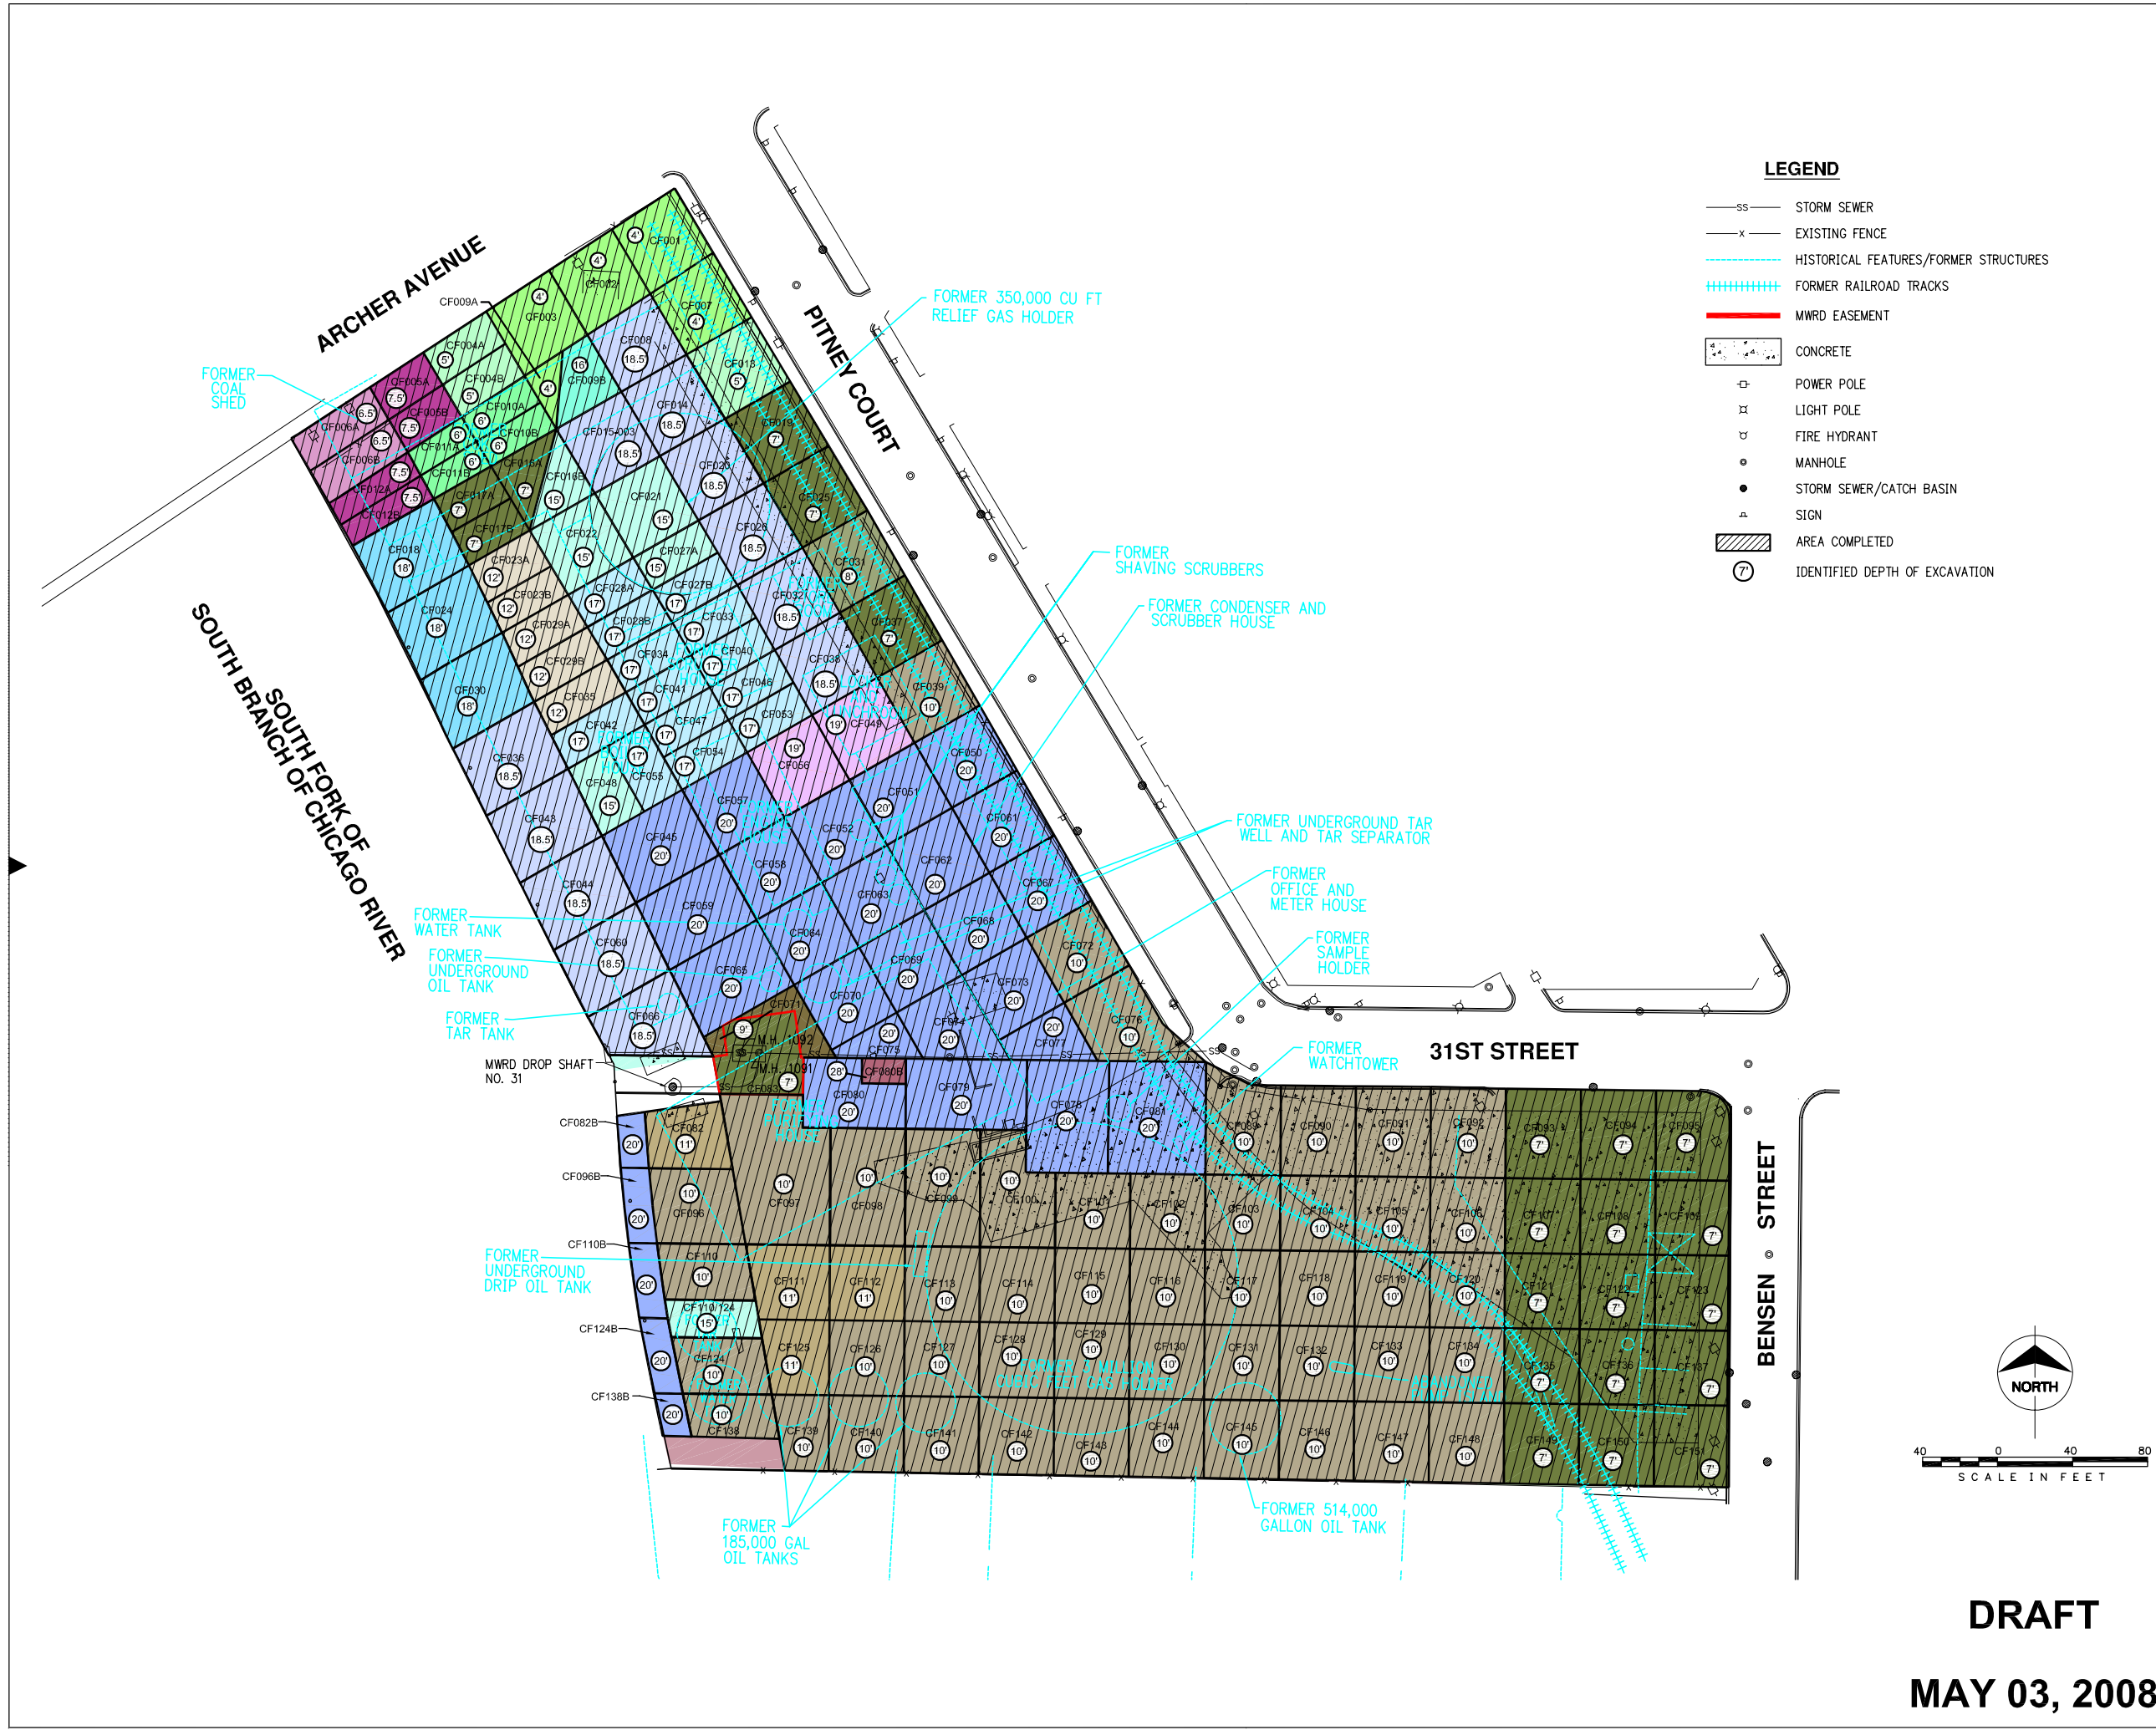

no.	date	by	ckd	description
-----	------	----	-----	-------------



date	05-03-08	detailed	J. PEREZ
designed	A. HANRAHAN	checked	

THE PEOPLES GAS LIGHT AND COKE COMPANY  
CHICAGO, ILLINOIS

PITNEY COURT  
3052 SOUTH PITNEY COURT  
CHICAGO, ILLINOIS

Figure 1  
AS-BUILT EXCAVATION LAYOUT MAP  
PITNEY COURT  
CHICAGO, ILLINOIS



project	27112	contract	
drawing		rev.	

sheet	1	of	1	sheets
file:PEOPLES GAS/PITNEY COURT_CADDWORK/IN PROGRESS/2008-05-03 PITNEY COURT EXCAVATION				

**DRAFT**


**MAY 03, 2008**



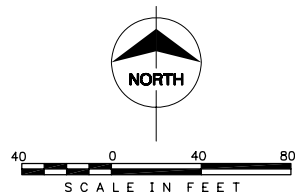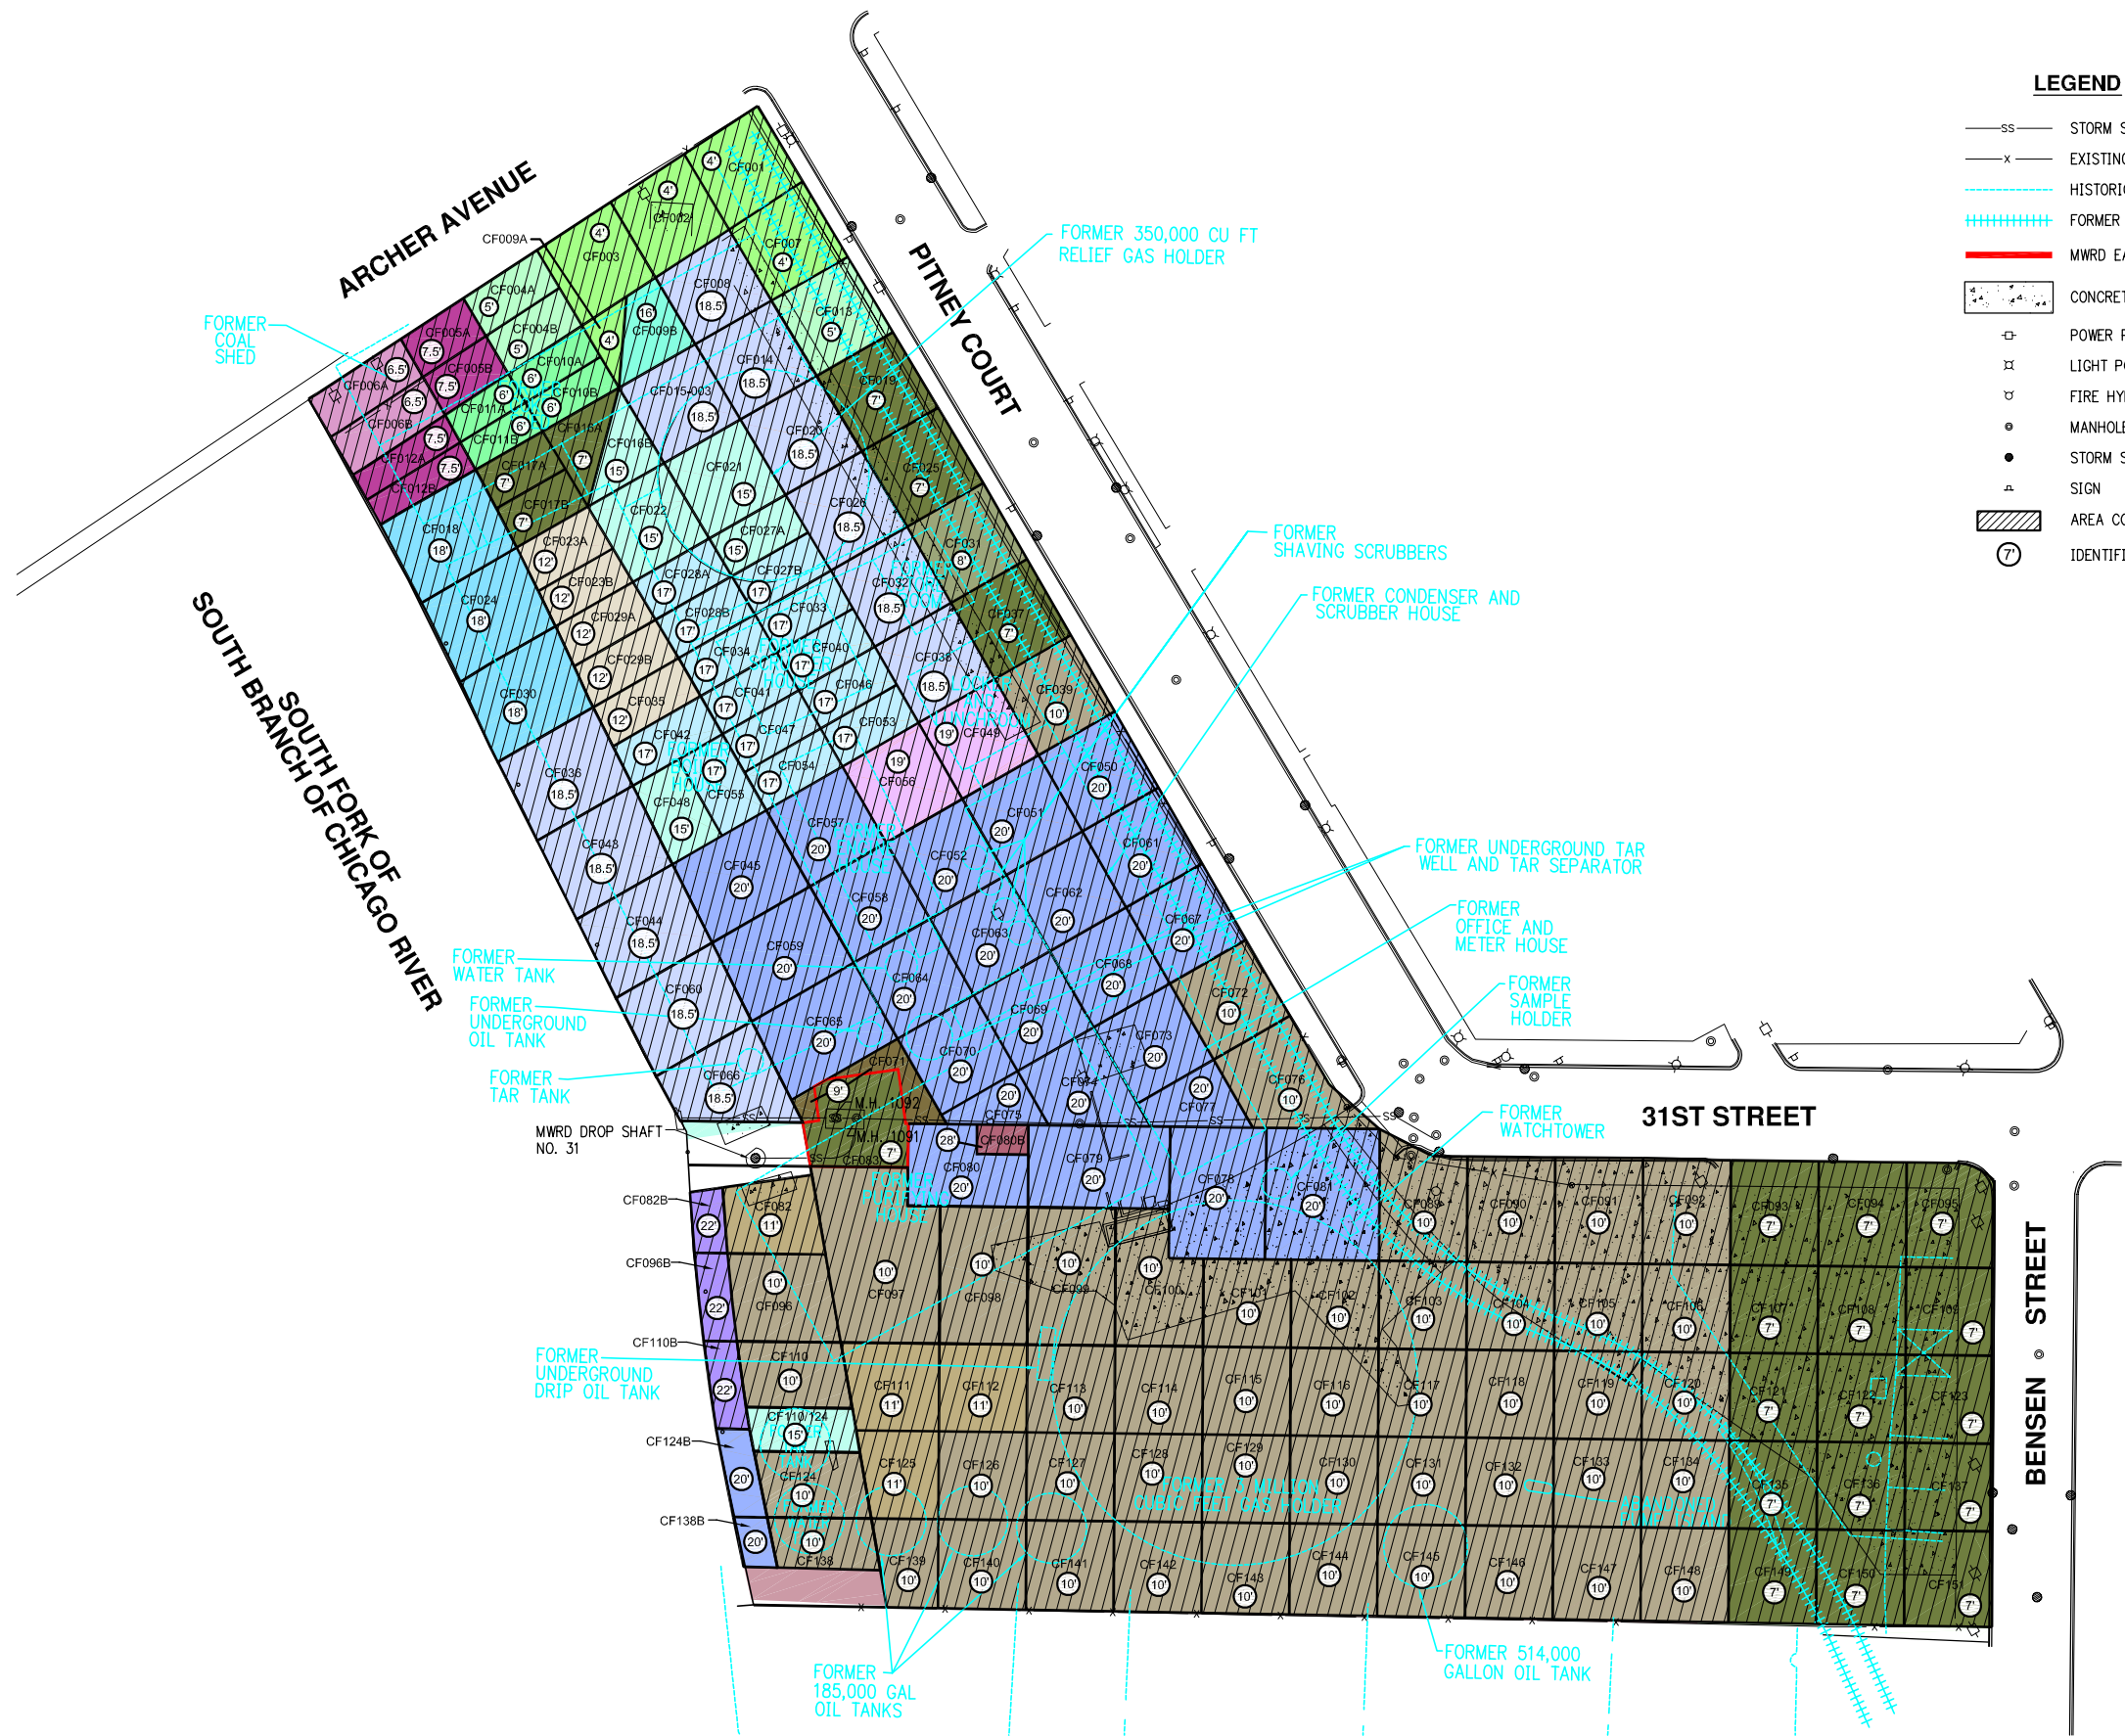


**DRAFT**

**MAY 10, 2008**

	
date 05-10-08	detailed J. PEREZ
designed A. HANRAHAN	checked
<b>THE PEOPLES GAS LIGHT AND COKE COMPANY CHICAGO, ILLINOIS</b>	
<b>PITNEY COURT 3052 SOUTH PITNEY COURT CHICAGO, ILLINOIS</b>	
Figure 1 AS-BUILT EXCAVATION LAYOUT MAP PITNEY COURT CHICAGO, ILLINOIS	
project 27112	contract
drawing	rev.
sheet 1 of 1 sheets	
file:PEOPLES GAS/PITNEY COURT_CADDWORK/INPROGRESS/2008-05-10/PITNEY COURT EXCAVATION	



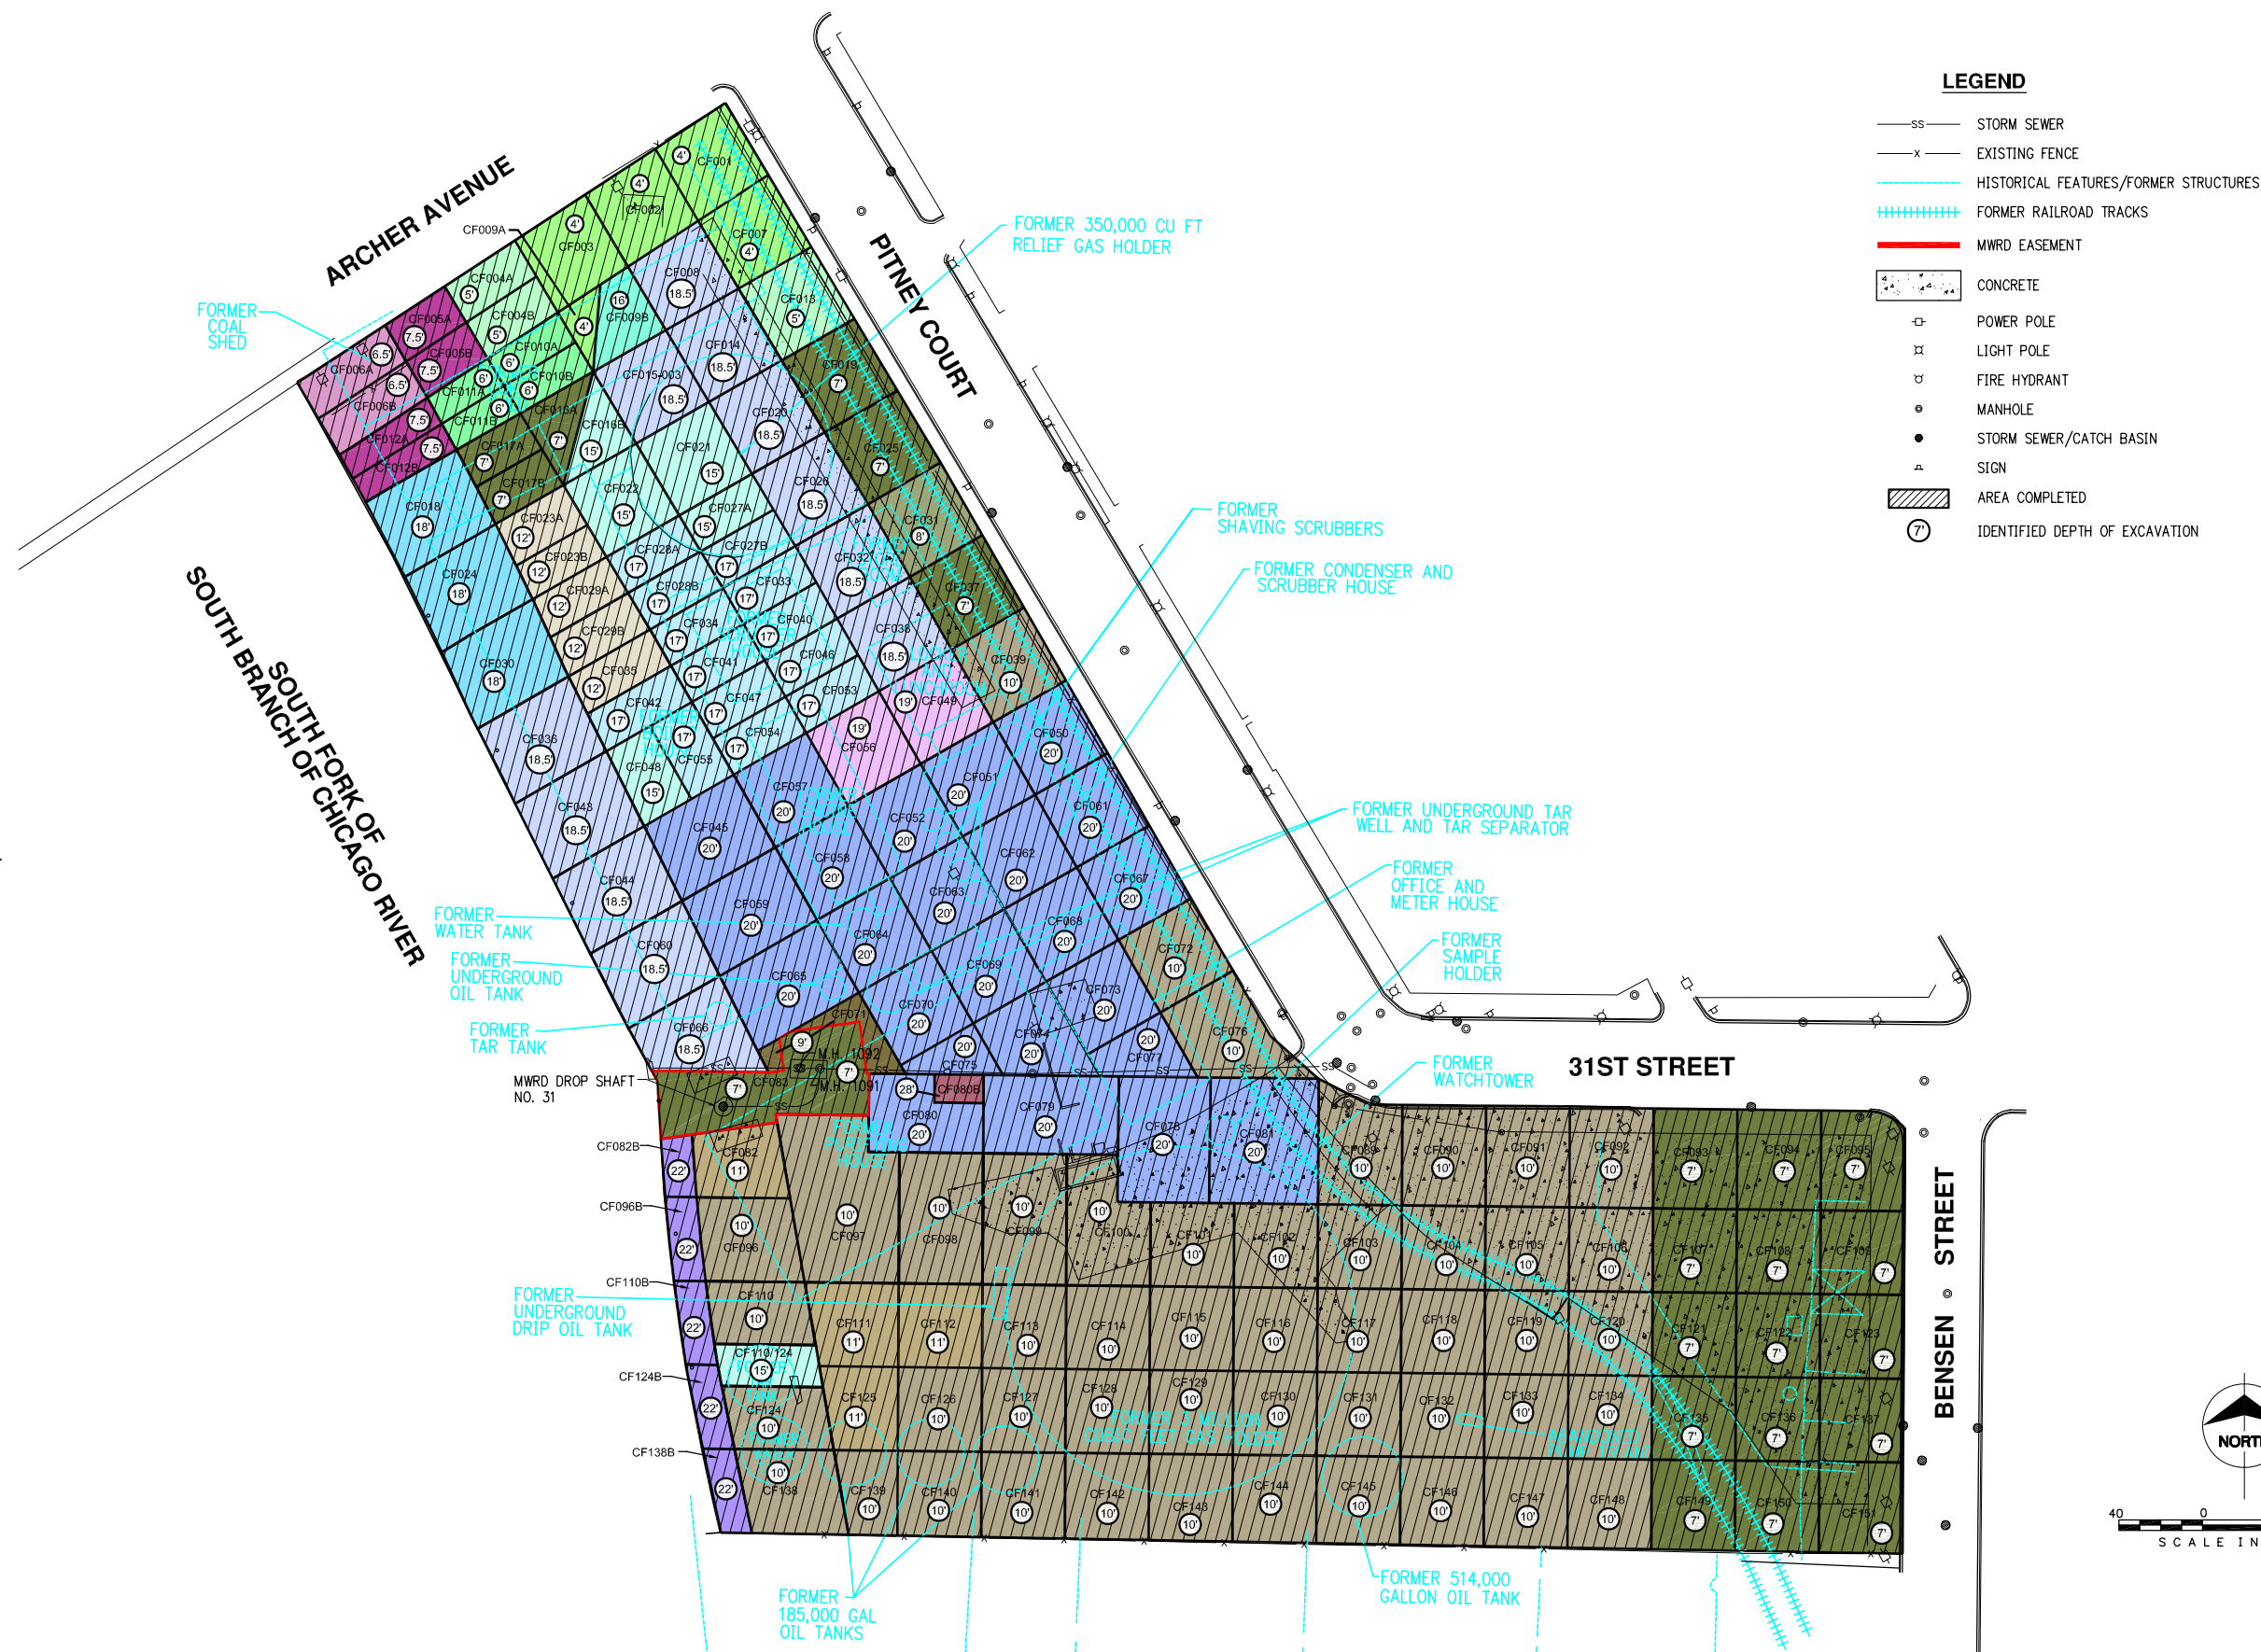


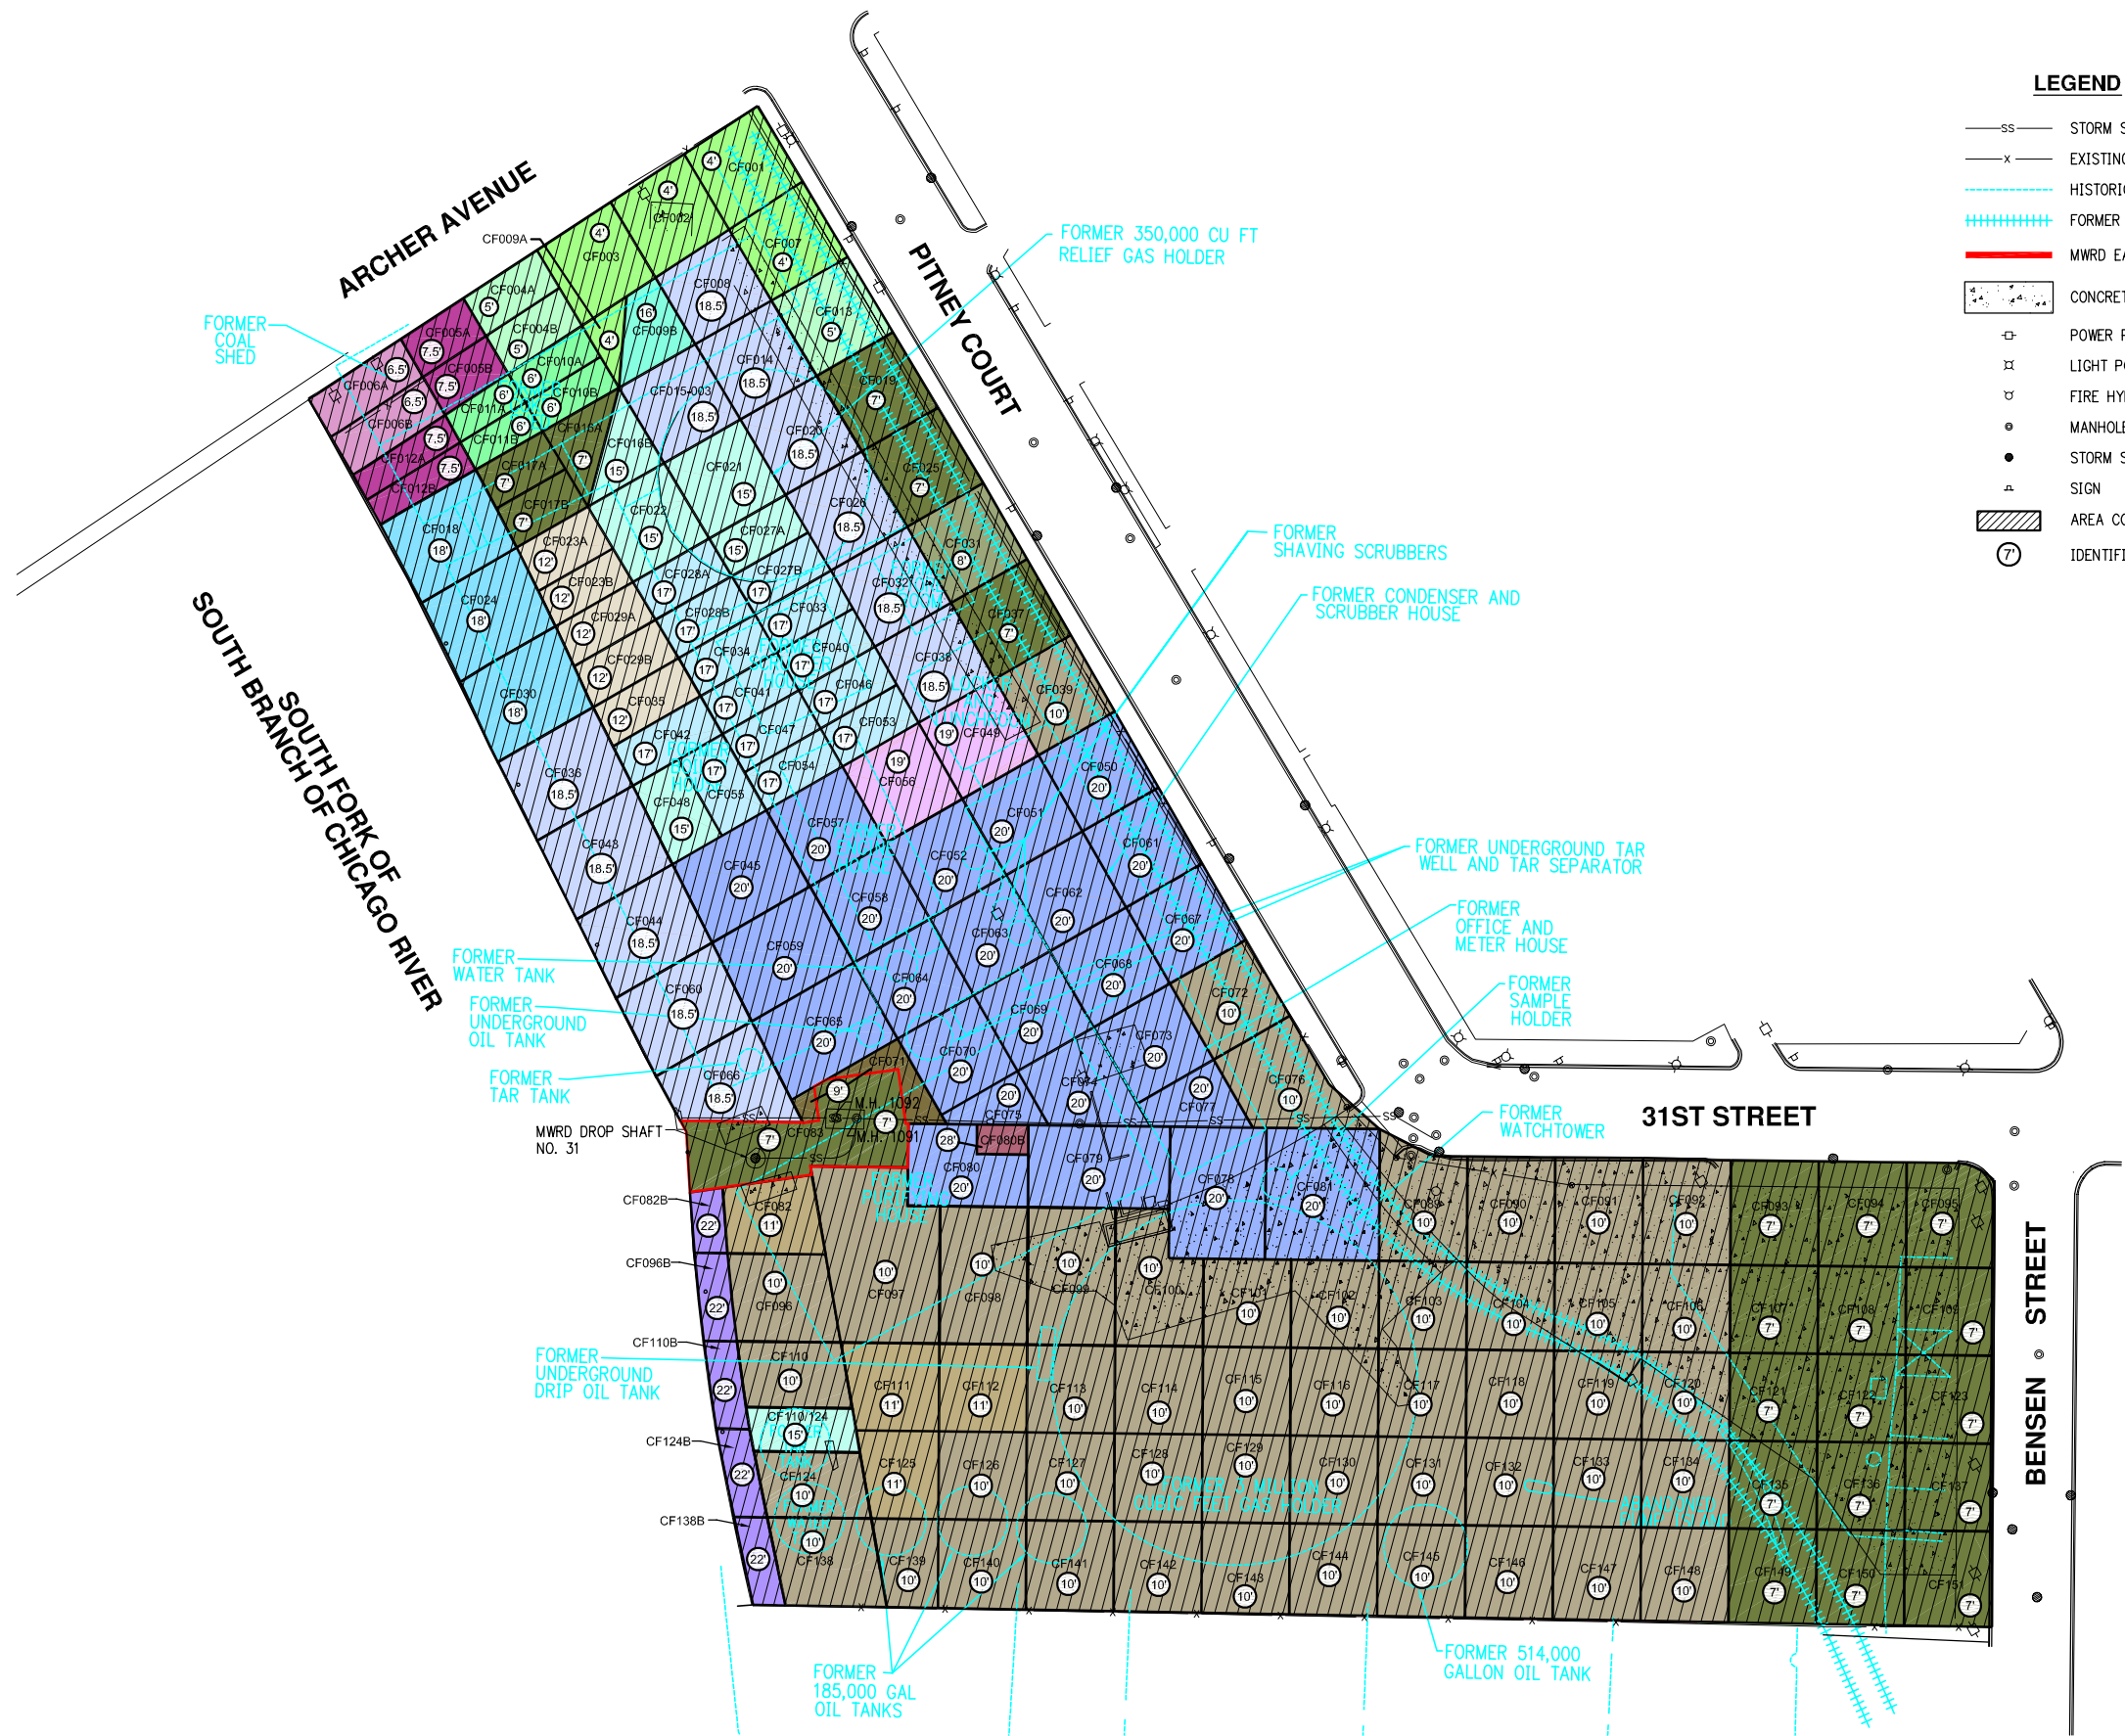
**DRAFT**

**MAY 17, 2008**

no.	date	by	ckd	description
-----	------	----	-----	-------------

	
date 05-17-08	date J. PEREZ
designed A. HANRAHAN	checked
<p>THE PEOPLES GAS LIGHT AND COKE COMPANY CHICAGO, ILLINOIS</p> <p>PITNEY COURT 3052 SOUTH PITNEY COURT CHICAGO, ILLINOIS</p>	
<p>Figure 1</p> <p>AS-BUILT EXCAVATION LAYOUT MAP PITNEY COURT CHICAGO, ILLINOIS</p>	
project 27112	contract
drawing	rev.
<p>sheet 1 of 1 sheets</p> <p>file HPEOPLES GASPINEY COURT_CADDWORK\IN PROGRESS 2008-05-17 PITNEY COURT EXCAVATION</p>	





LEGEND

- SS STORM SEWER
- X EXISTING FENCE
- HISTORICAL FEATURES/FORMER STRUCTURES
- +++++ FORMER RAILROAD TRACKS
- MWRD EASEMENT
- CONCRETE
- POWER POLE
- LIGHT POLE
- FIRE HYDRANT
- MANHOLE
- STORM SEWER/CATCH BASIN
- SIGN
- AREA COMPLETED
- IDENTIFIED DEPTH OF EXCAVATION



40 0 40 80  
SCALE IN FEET

DRAFT

MAY 24, 2008



date	05-24-08	detailed	J. PEREZ
designed	A. HANRAHAN	checked	

THE PEOPLES GAS LIGHT  
AND COKE COMPANY  
CHICAGO, ILLINOIS

PITNEY COURT  
3052 SOUTH PITNEY COURT  
CHICAGO, ILLINOIS

Figure 1 AS-BUILT EXCAVATION LAYOUT MAP PITNEY COURT CHICAGO, ILLINOIS			
project	27112	contract	
drawing		rev.	
sheet	1	of	1
file:PEOPLES GAS/PITNEY COURT_CADWORK/IN PROGRESS/2008-05-24/PITNEY COURT EXCAVATION			



1 2 3 4 5 6 7 8 9 10 11 12 13 14

no. date by ckd description

LEGEND

- SS STORM SEWER
- X EXISTING FENCE
- HISTORICAL FEATURES/FORMER STRUCTURES
- FORMER RAILROAD TRACKS
- CONCRETE
- POWER POLE
- LIGHT POLE
- FIRE HYDRANT
- MANHOLE
- STORM SEWER/CATCH BASIN
- SIGN
- SOIL PROBE
- SOIL BORING
- TEST PIT
- TEST PIT SAMPLE
- GROUNDWATER MONITORING WELL (MW10)
- EXCAVATION DEPTH 3'
- EXCAVATION DEPTH 8'
- EXCAVATION DEPTH 10'
- EXCAVATION DEPTH 14'
- EXCAVATION DEPTH 15'
- EXCAVATION DEPTH 17'
- SLOPING AREA
- APPROXIMATE DEPTH OF EXCAVATION
- SHEET PILING

- NOTES
- EXCAVATION DIMENSIONS WERE DEVELOPED FROM SITE INVESTIGATION DATA AND THEY ARE APPROXIMATE.
  - SOIL CONFIRMATION SAMPLES WILL BE USED TO ESTABLISH FINAL EXCAVATION DIMENSIONS, INCLUDING DEPTH.



date 10-25-06 detailed G. ALVAREZ  
designed checked

THE PEOPLES GAS LIGHT AND COKE COMPANY  
CHICAGO, ILLINOIS  
PITNEY COURT  
3052 SOUTH PITNEY COURT  
CHICAGO, ILLINOIS

Figure 3  
PRELIMINARY EXCAVATION AND  
CROSS-SECTION LOCATION PLAN  
RAP

project 27112 contract  
drawing rev.  
sheet 3 of 5 sheets

FILE:PEOPLES GAS/PITNEY COURT...CAD/BDR/OCTOBER 2006/SECTION LOCATION

